
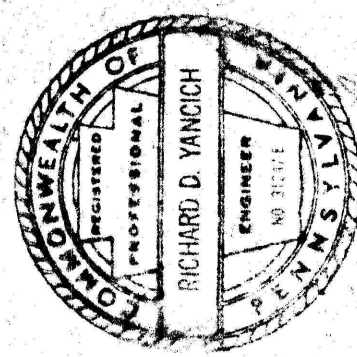


FIT TO SHEET No 5

SHEET No 4

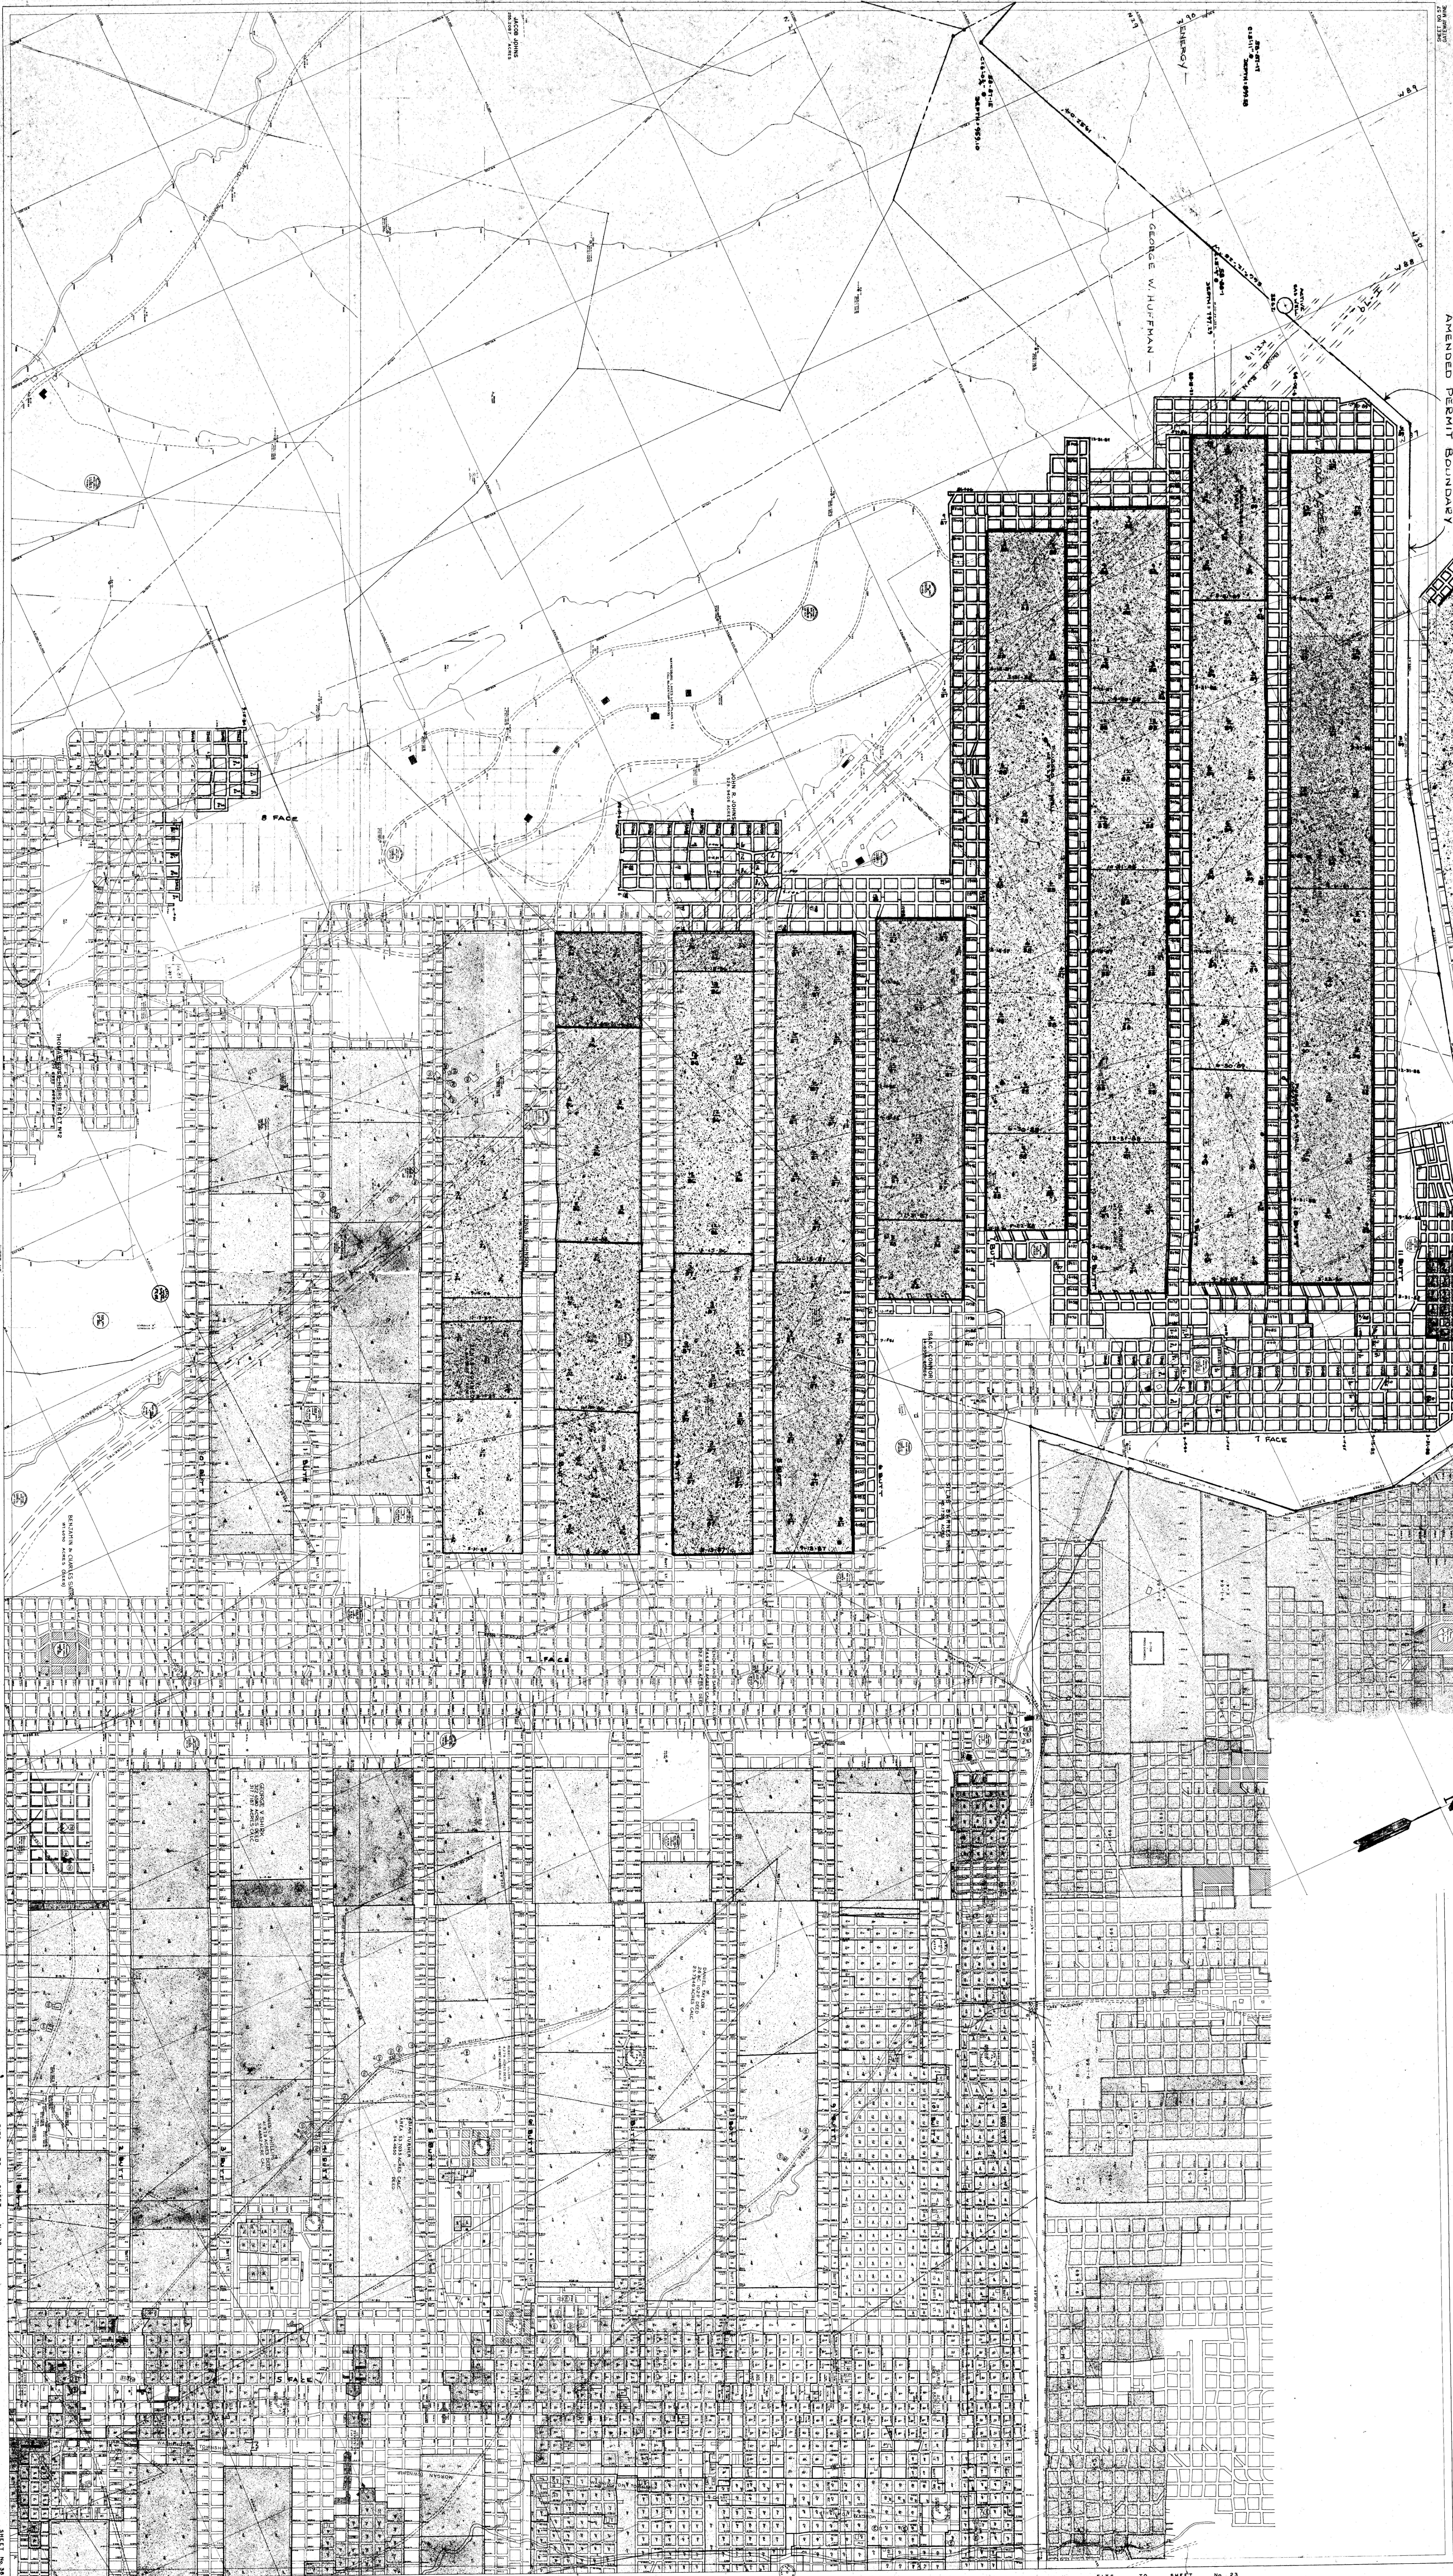

RECEIVED
JUL 31 1990
Dept. of Environmental Resources
McKerray District Office

GATEWAY COAL COMPANY
GATEWAY MINE
1"=400' - SHEET No 4

FINAL MAP
7-31-90

SHEET No 4

FIT TO SHEET No 2