


SHEET No 4

FIT TO SHEET No 5

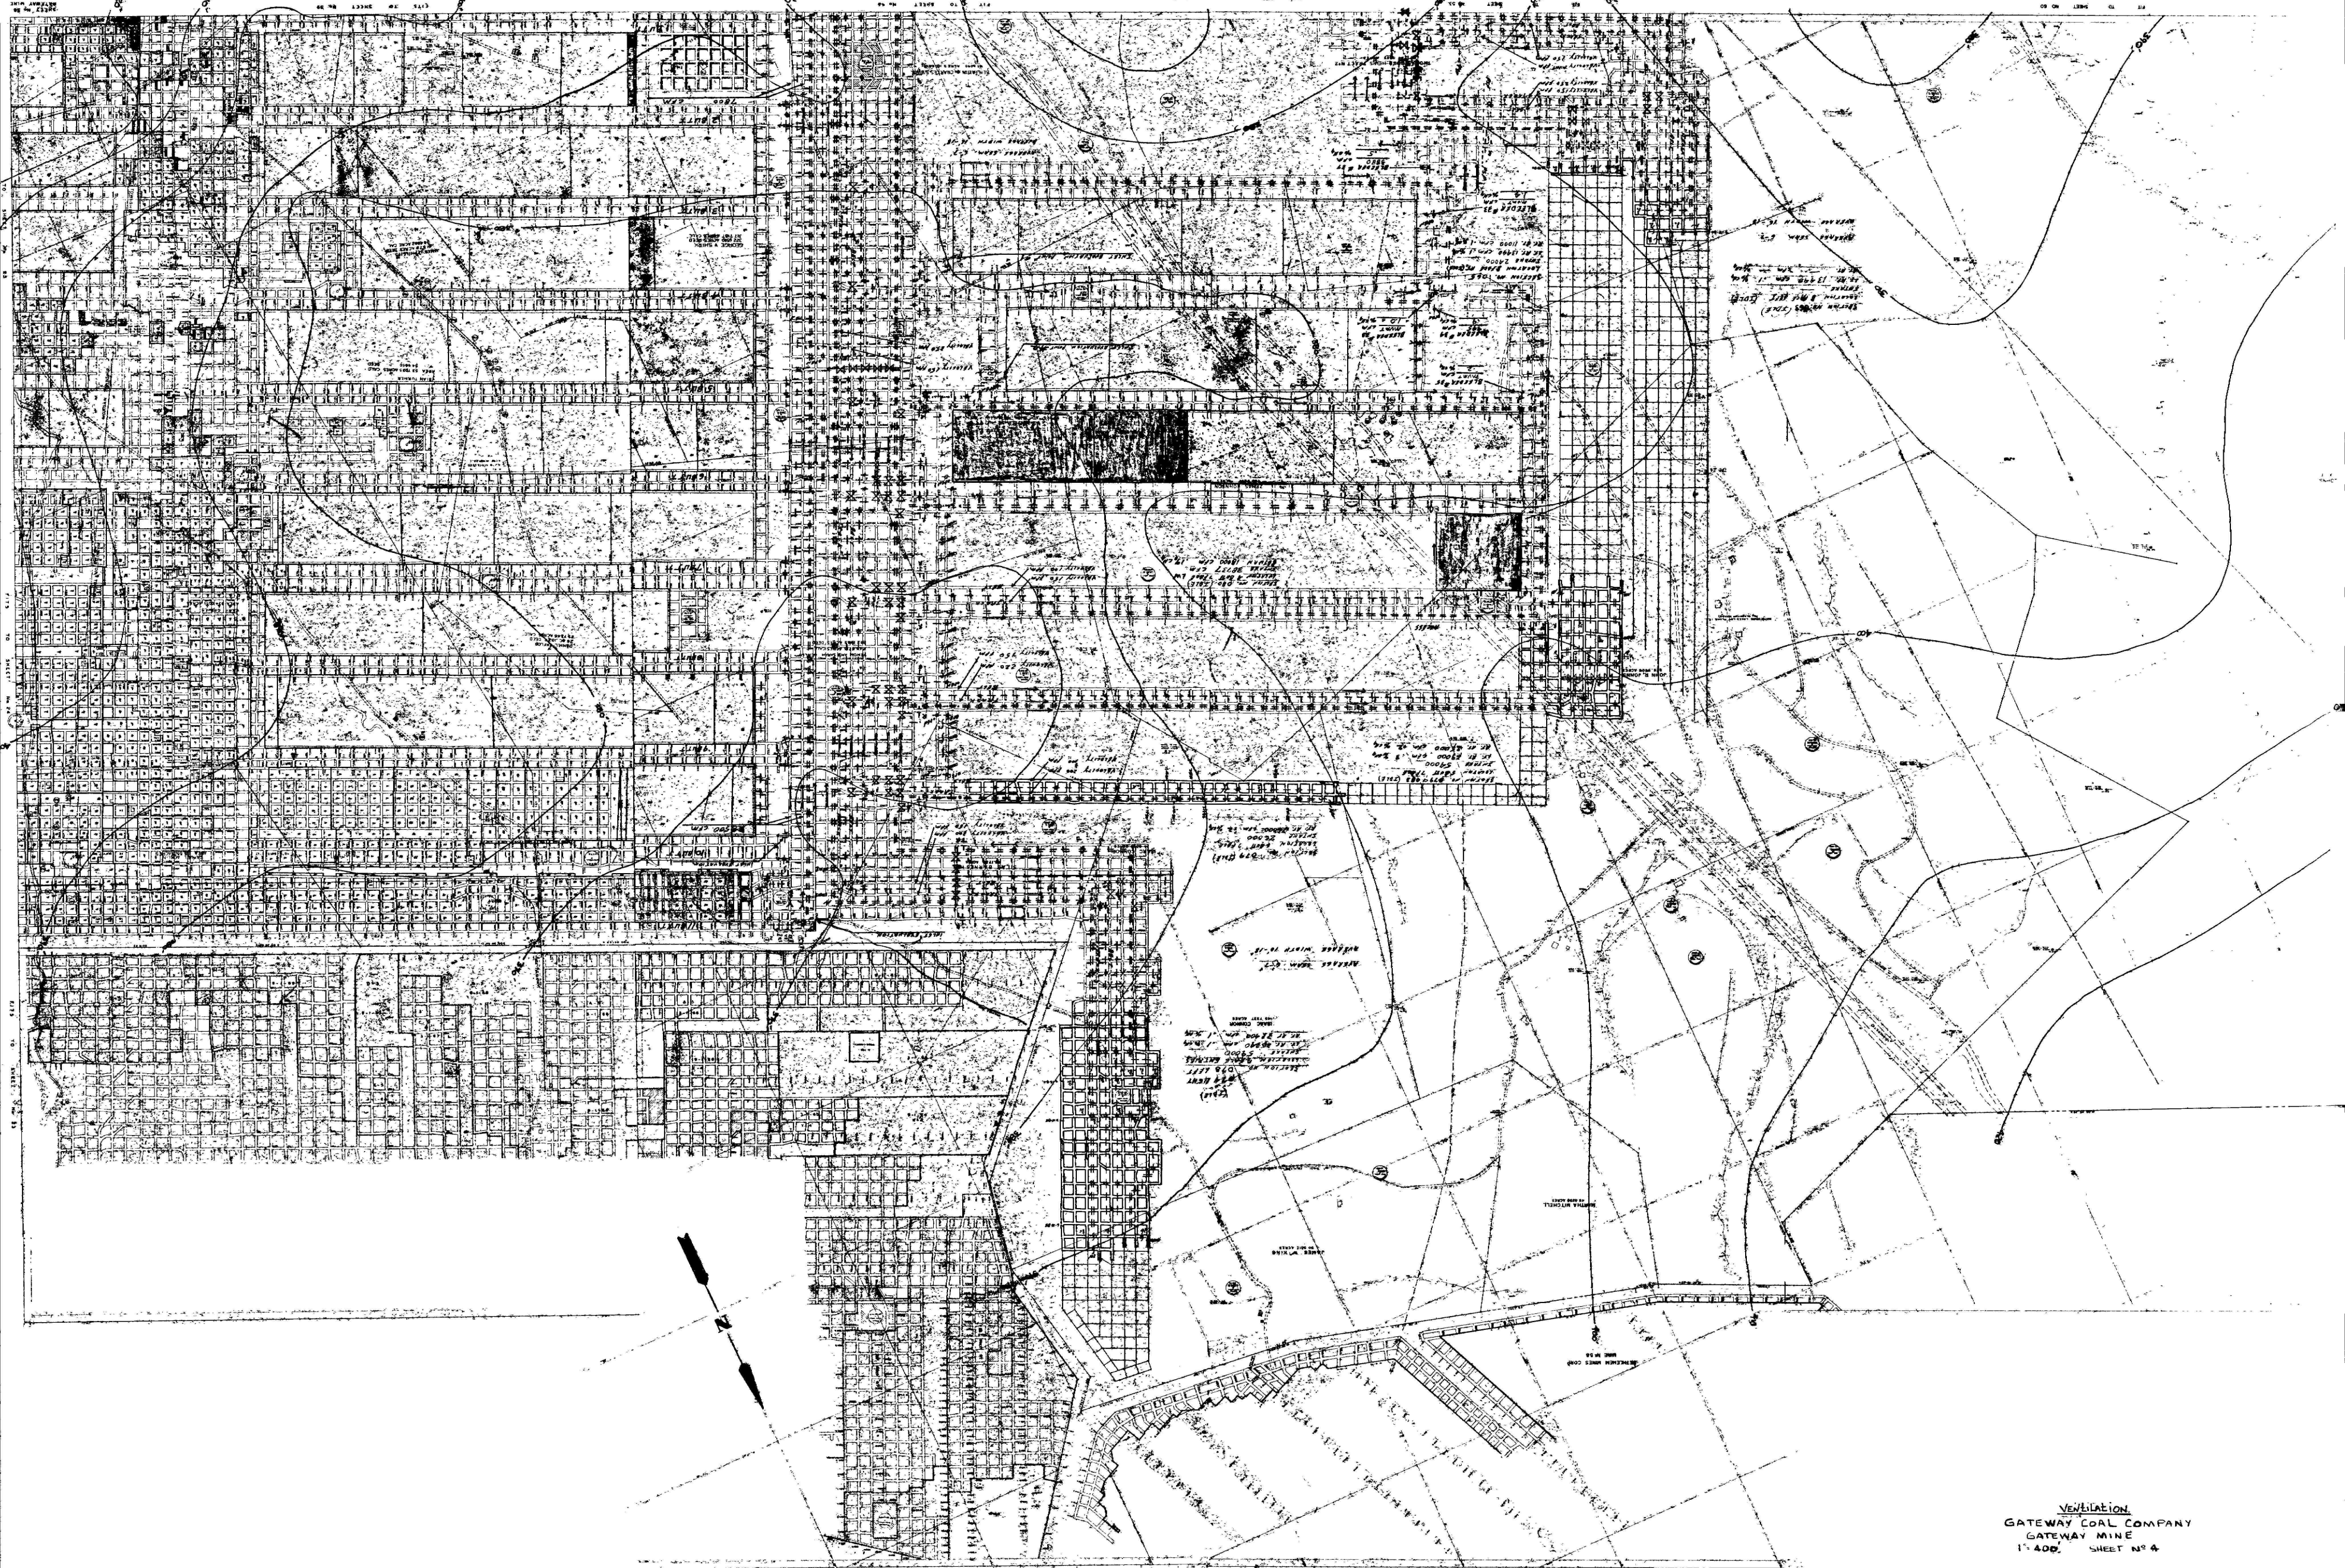

VENTILATION
GATEWAY COAL COMPANY
GATEWAY MINE
1"=400' SHEET No 4

SHEET No 4