


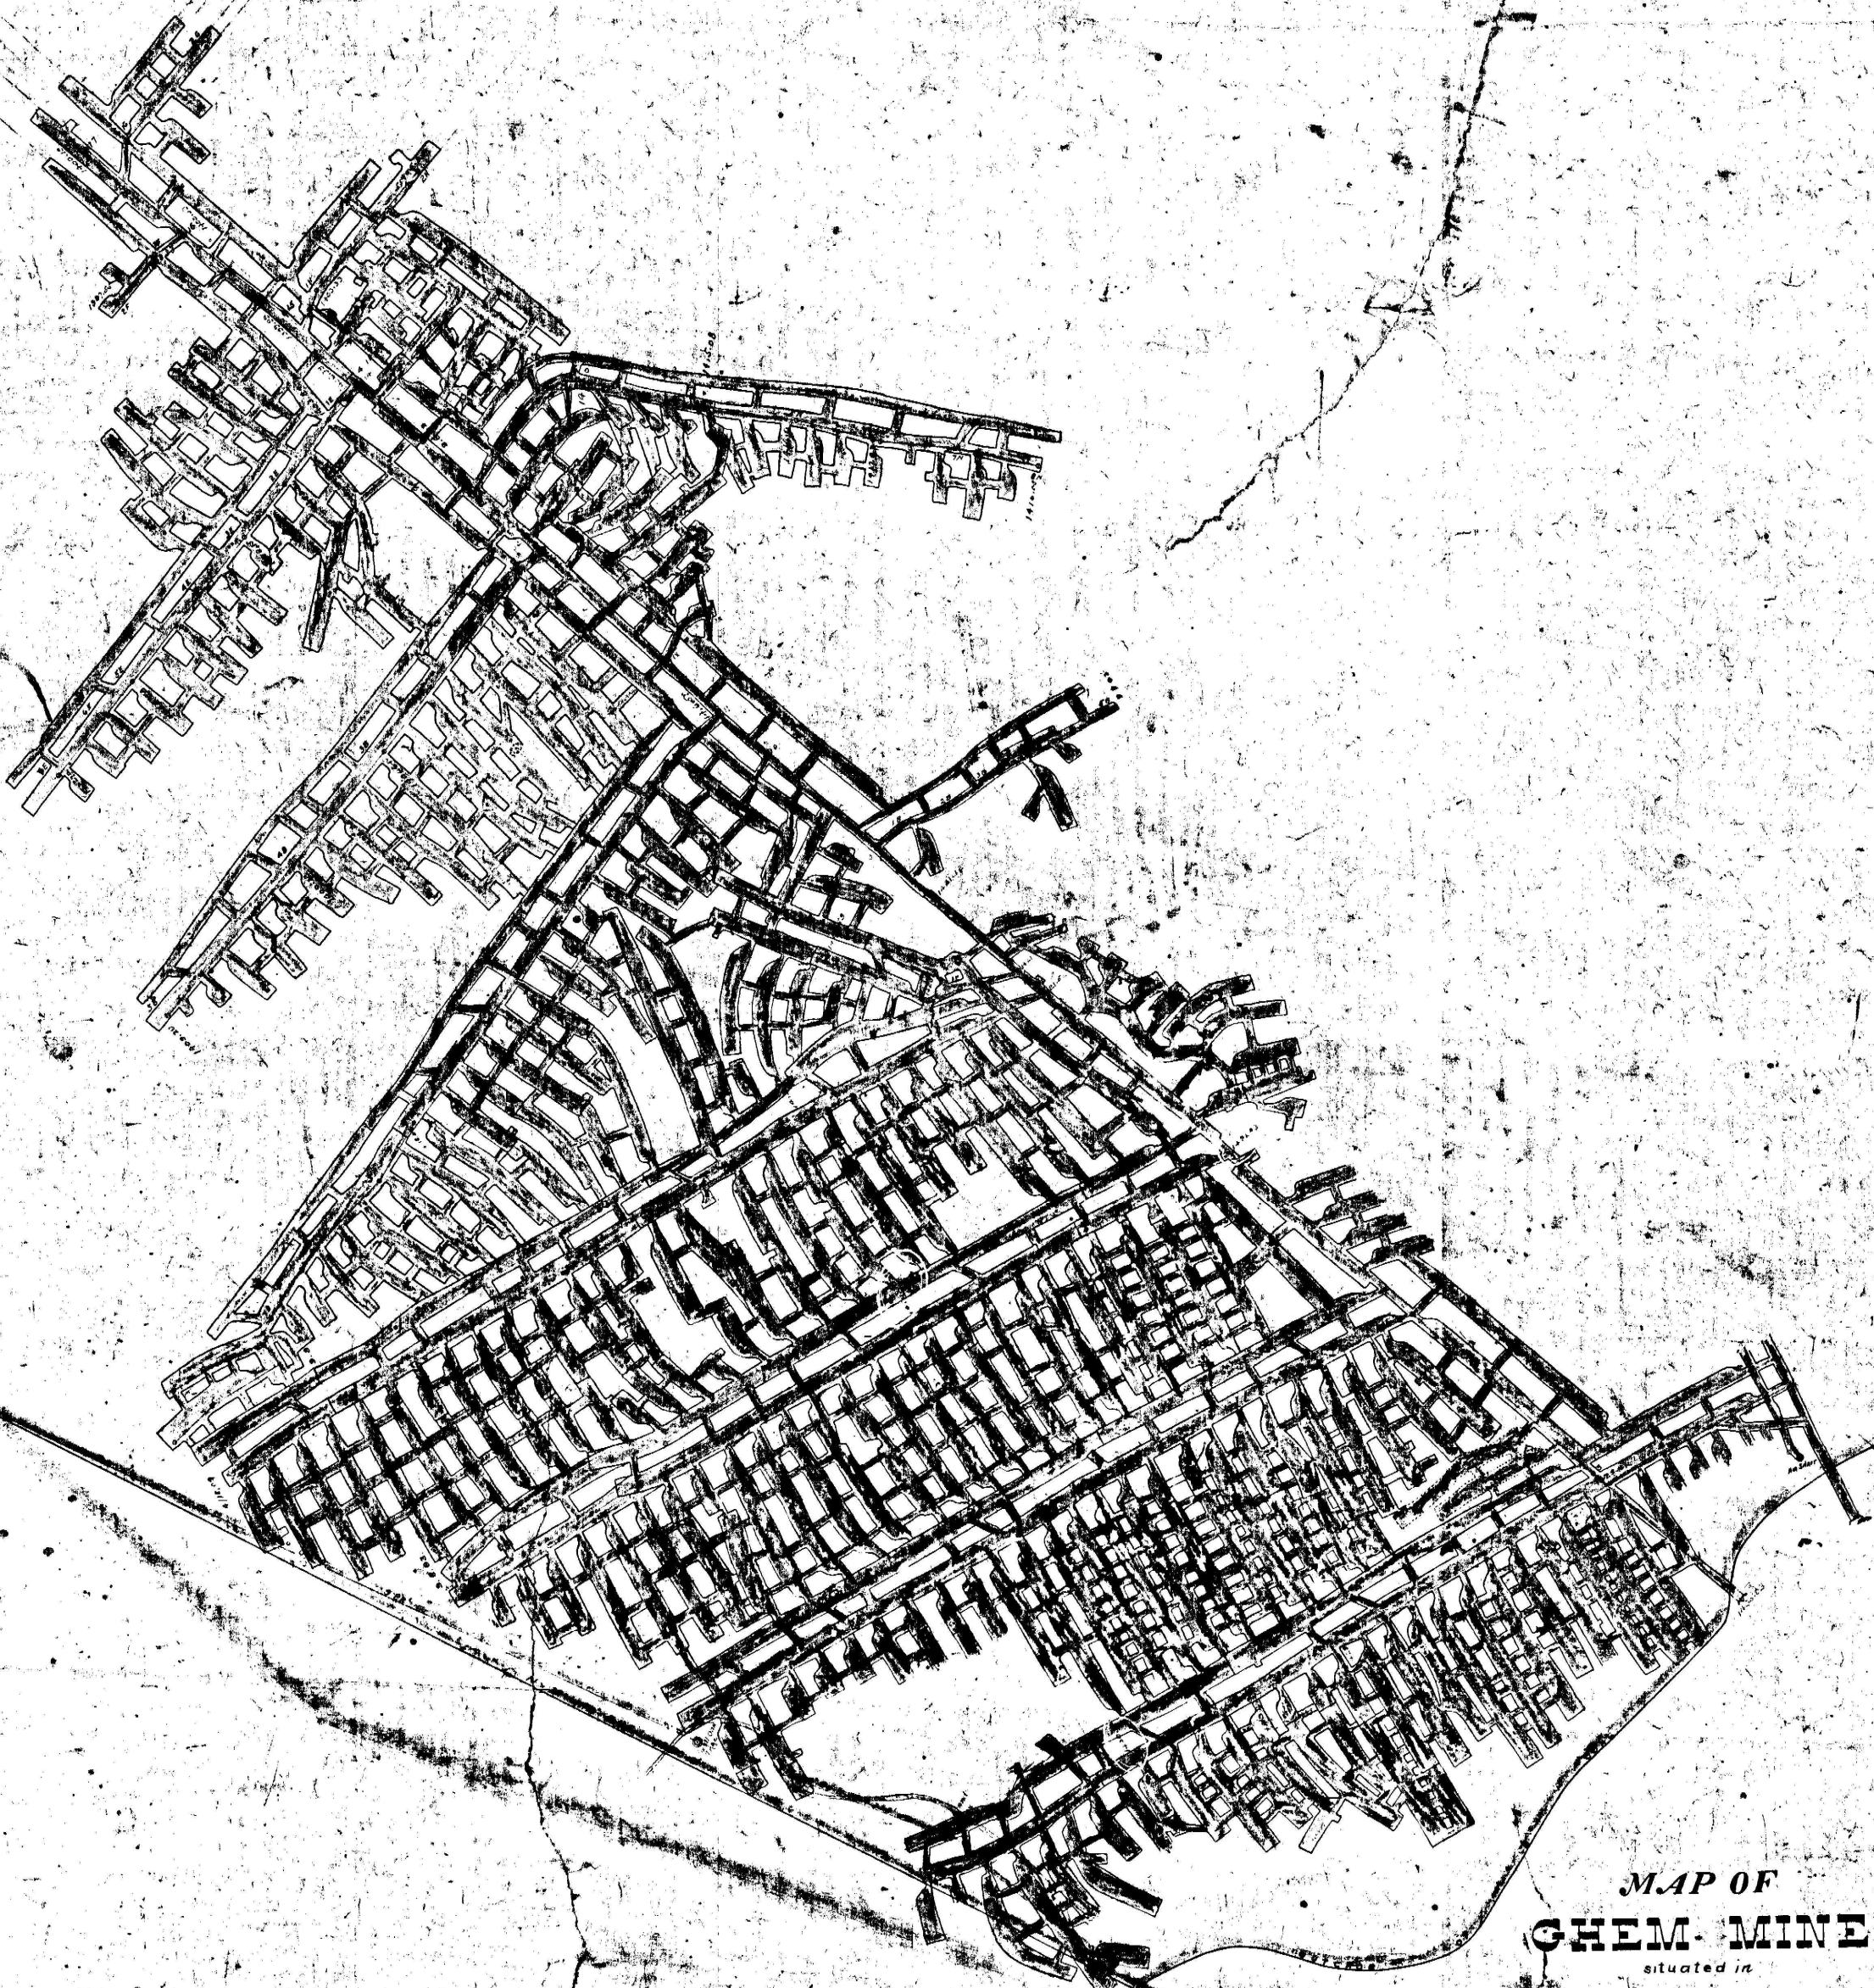

MAP OF
GHEM MINE
situated in
PHILIPS TWP., CLEARFIELD Co. PA.
operated by
JACOB SWIRE
PHILIPSBURG, PA. Scale 1" = 100'
MAY 20, 1901