


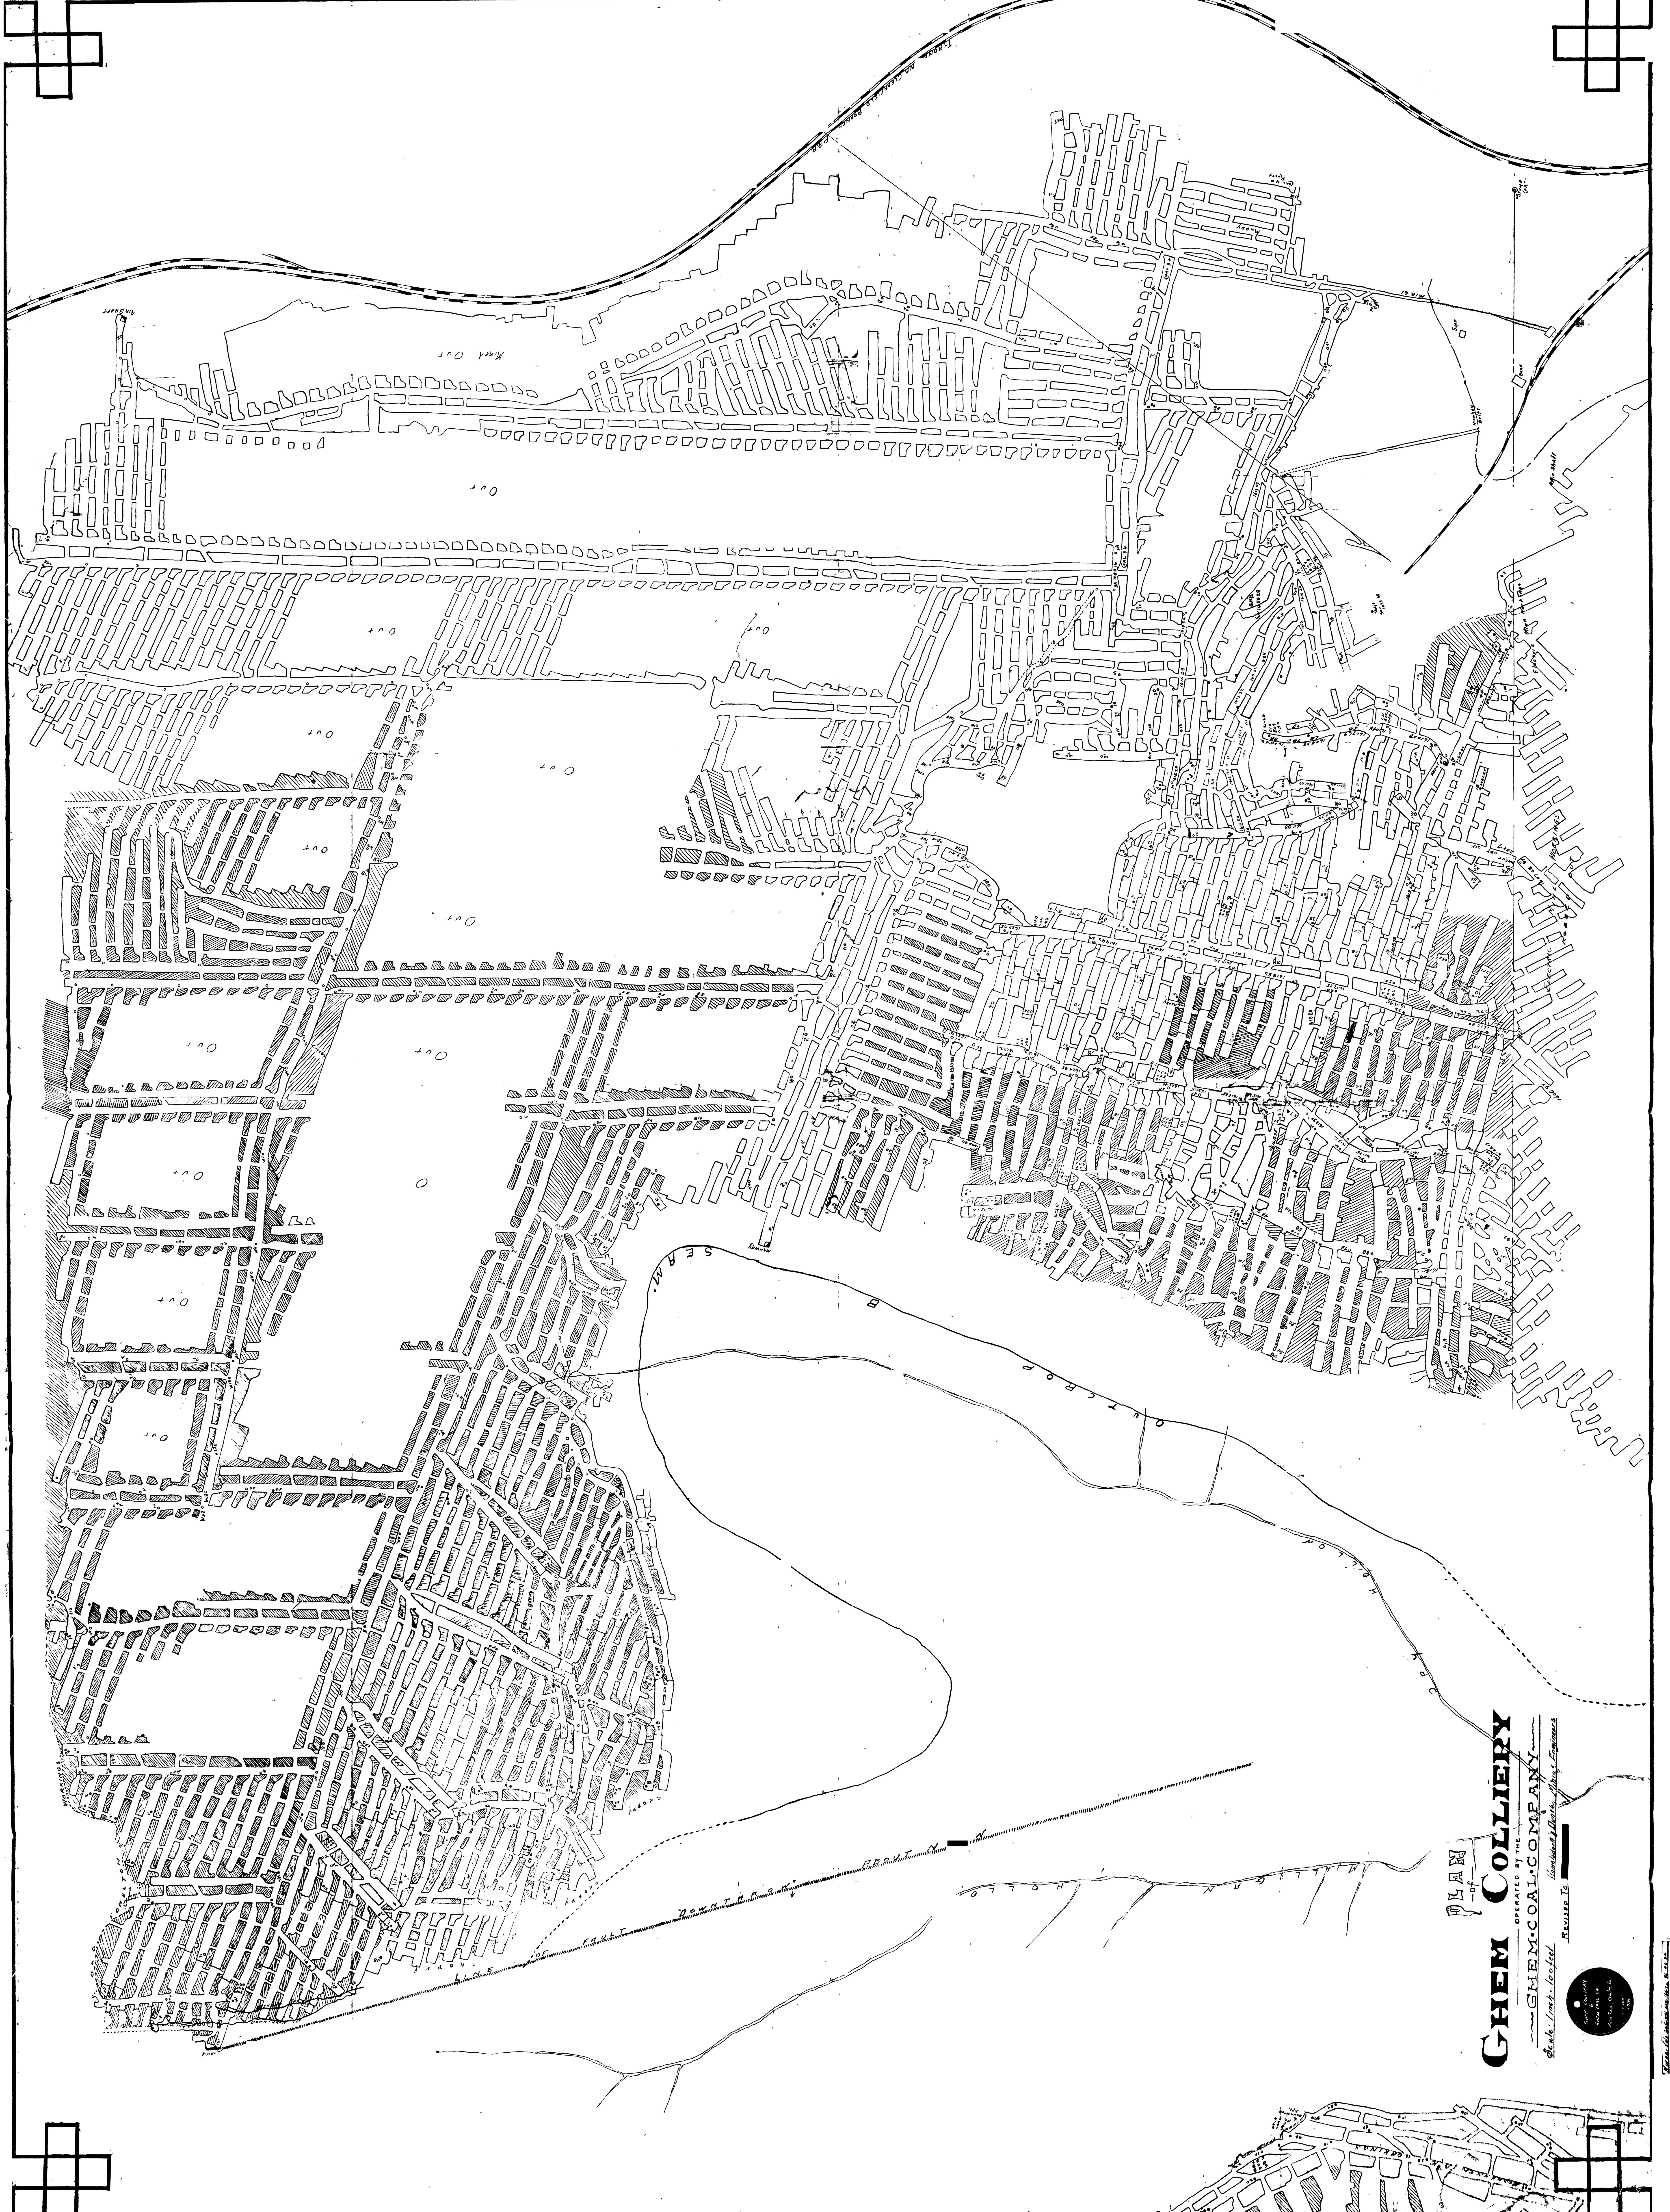

PLAN
-of-
GHEM COLLIERY
OPERATED BY THE
GHEM COAL COMPANY
Clark, Lynch, Leitch
Hatched Areas, Other Features
Revised To

