


177-178, 179-180, 181-182, 1069-1070,

$E = 8,000$

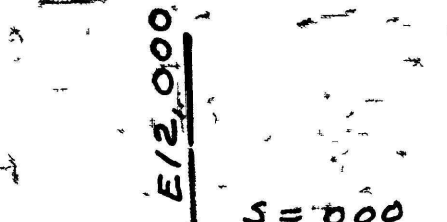

LEECHBURG, PA