

Gasley No 1

MAP OF
GASLEY NO 1

Name changed to Glen Brook No 1
OPERATED ON LANDS OF

GASLEY COAL CO
Glen Brook Mining Company
Scale 1/4 inch = 100 Feet Womelsdorff & Denkle, Min. Engrs.

1917

July 7-1920

July 7 1920


A

LITTLE BEAVER BR
P.C. 5

R.R.

J. B. NEVLING

1000'

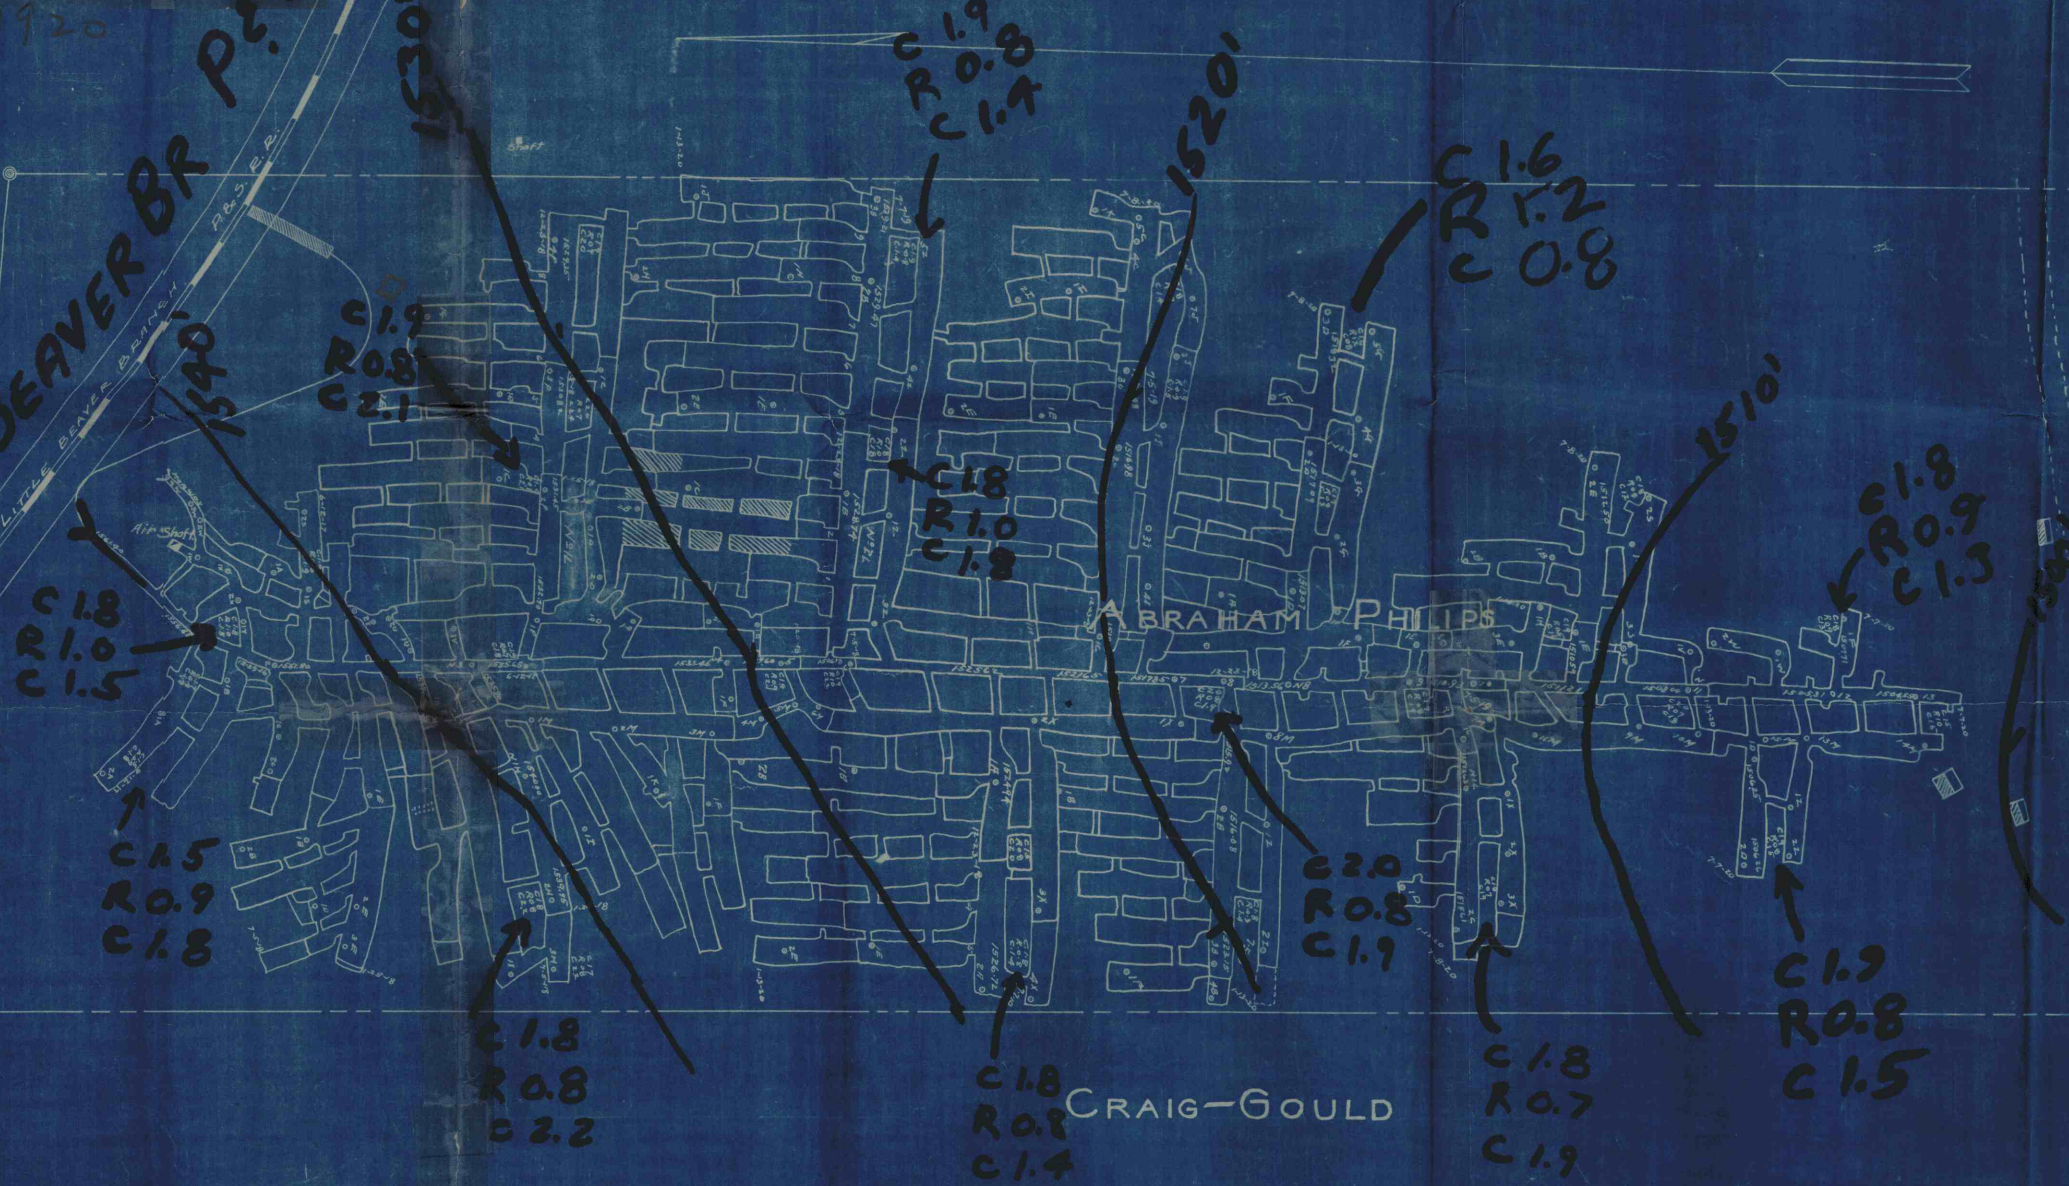

CRAIG-GOULD

#114
12-25-19
C.B.