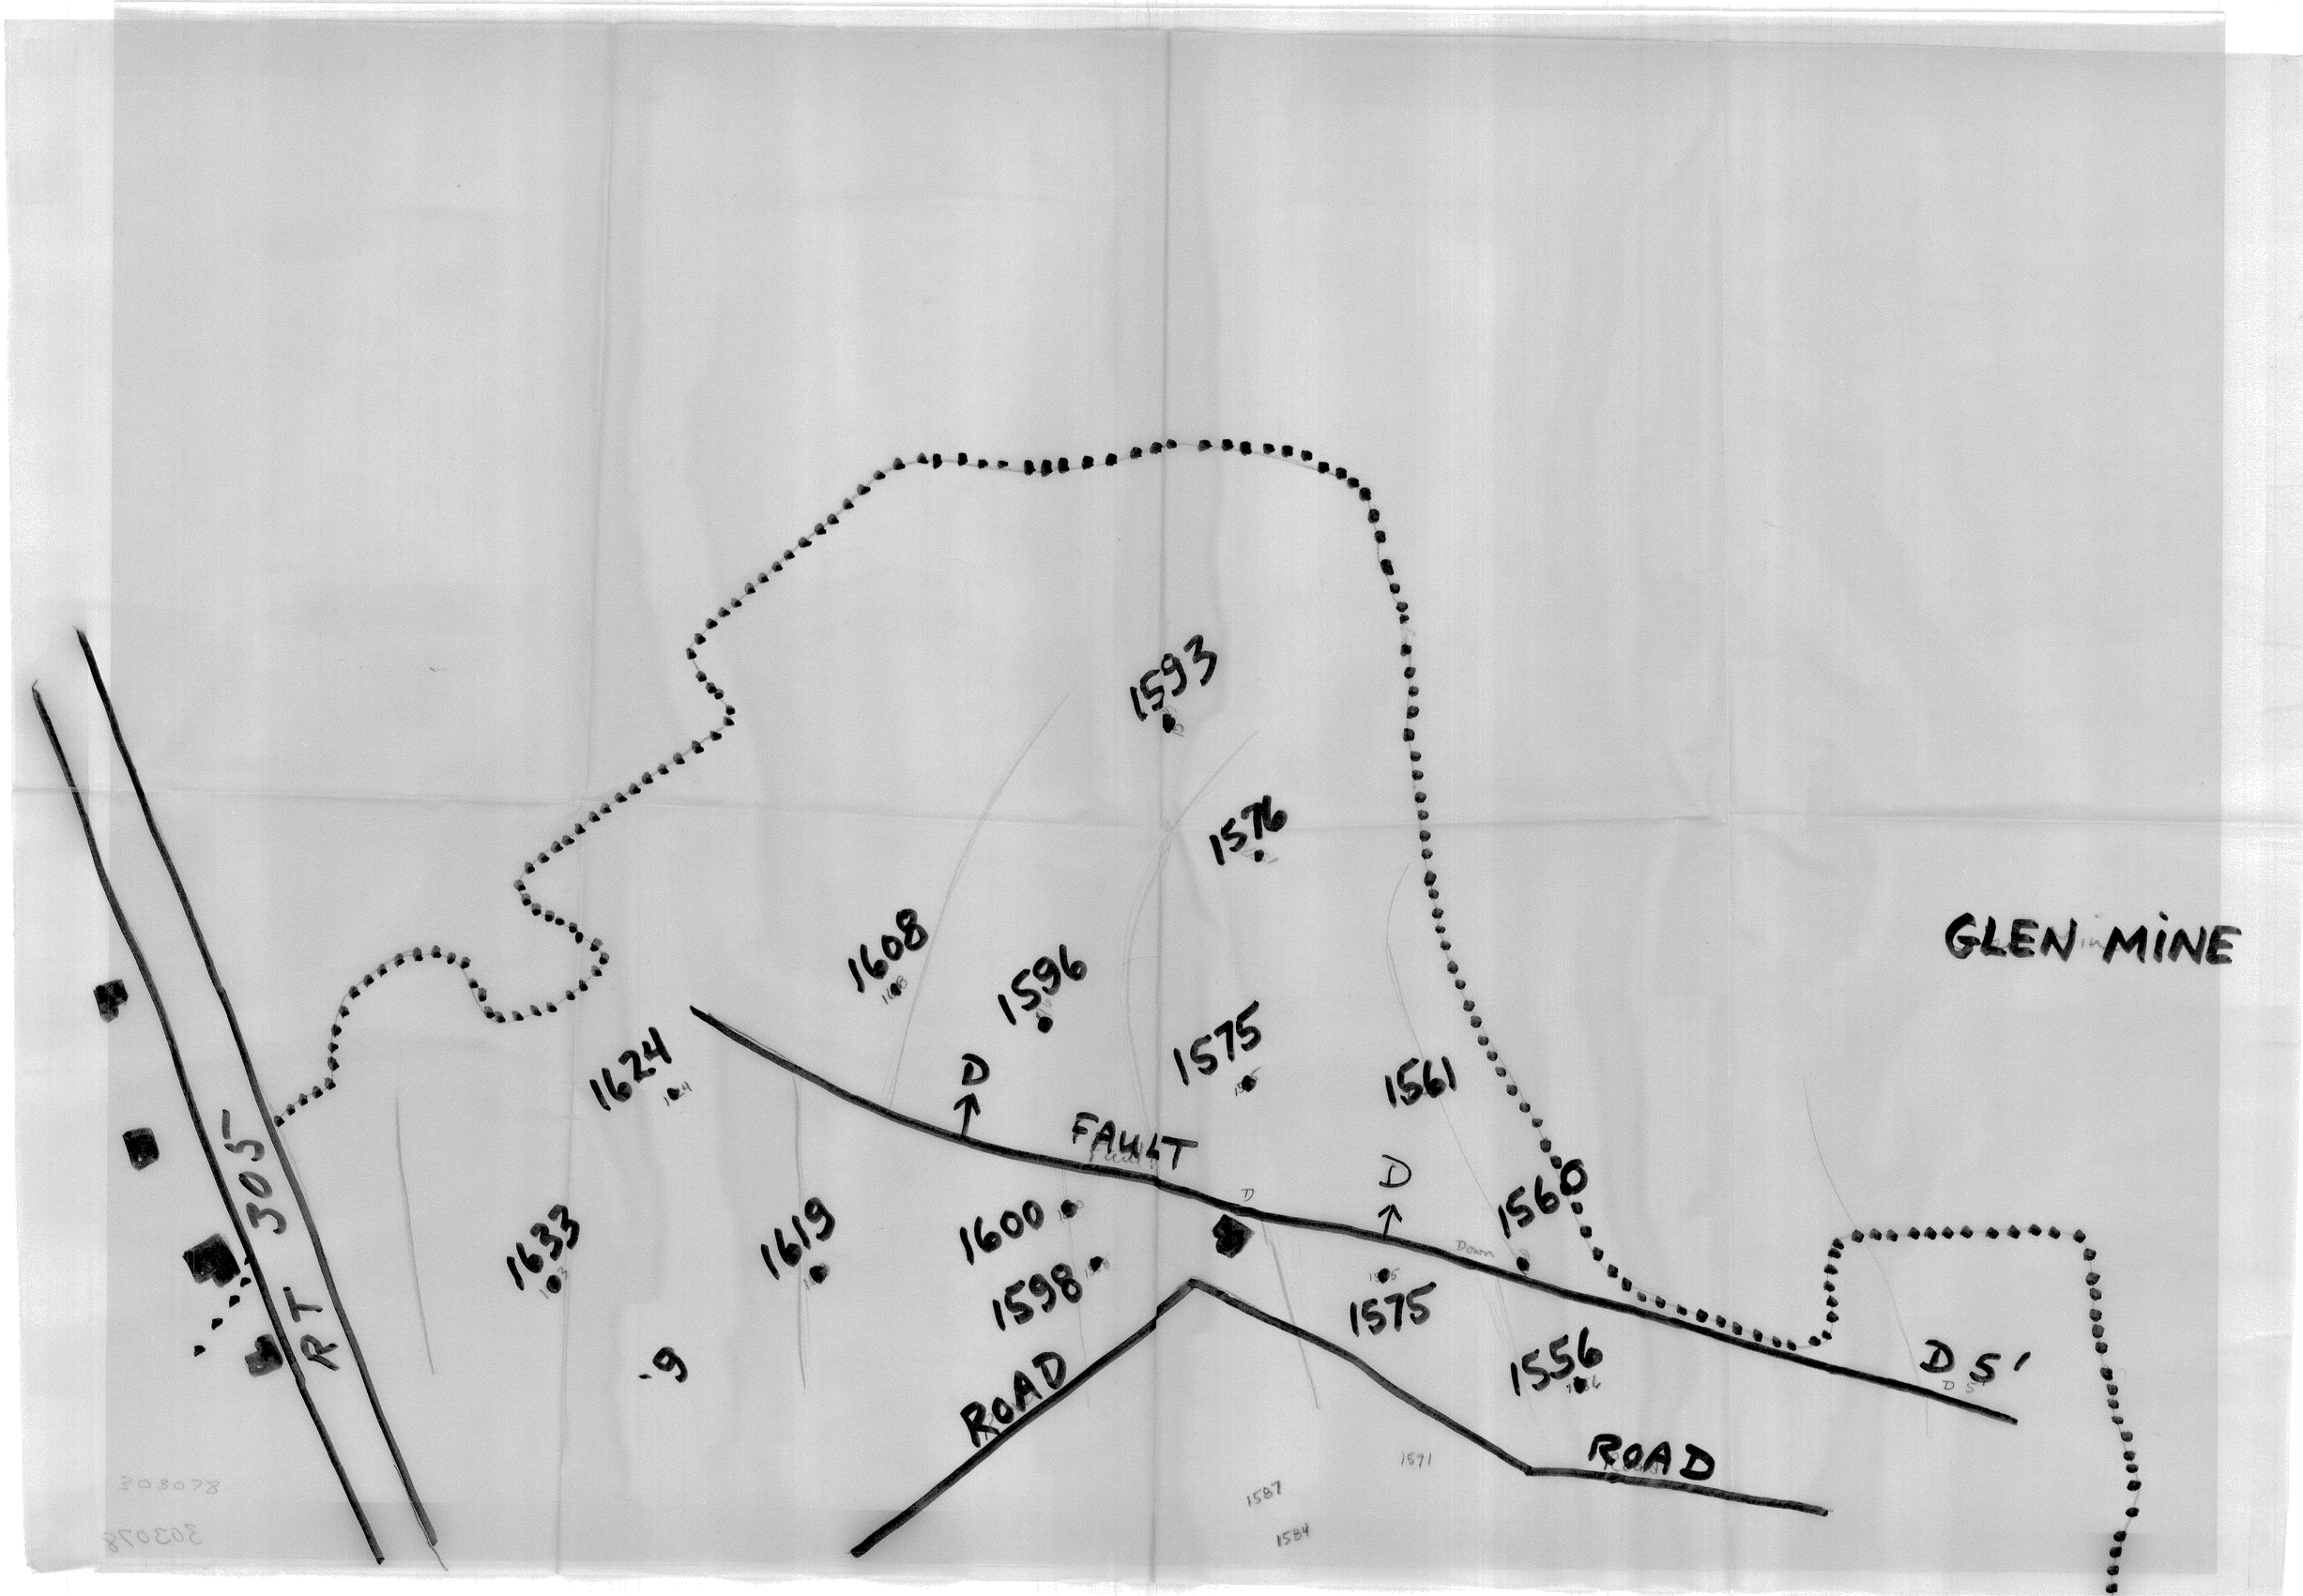
GLEN MINE
1593
1576
1608
1596
1575
1561
1624
D
FAULT
D
1560
1633
1619
1600
1598
1575
1556
D 5'
ROAD
ROAD
RT 305
1571
1587
1584
303078