


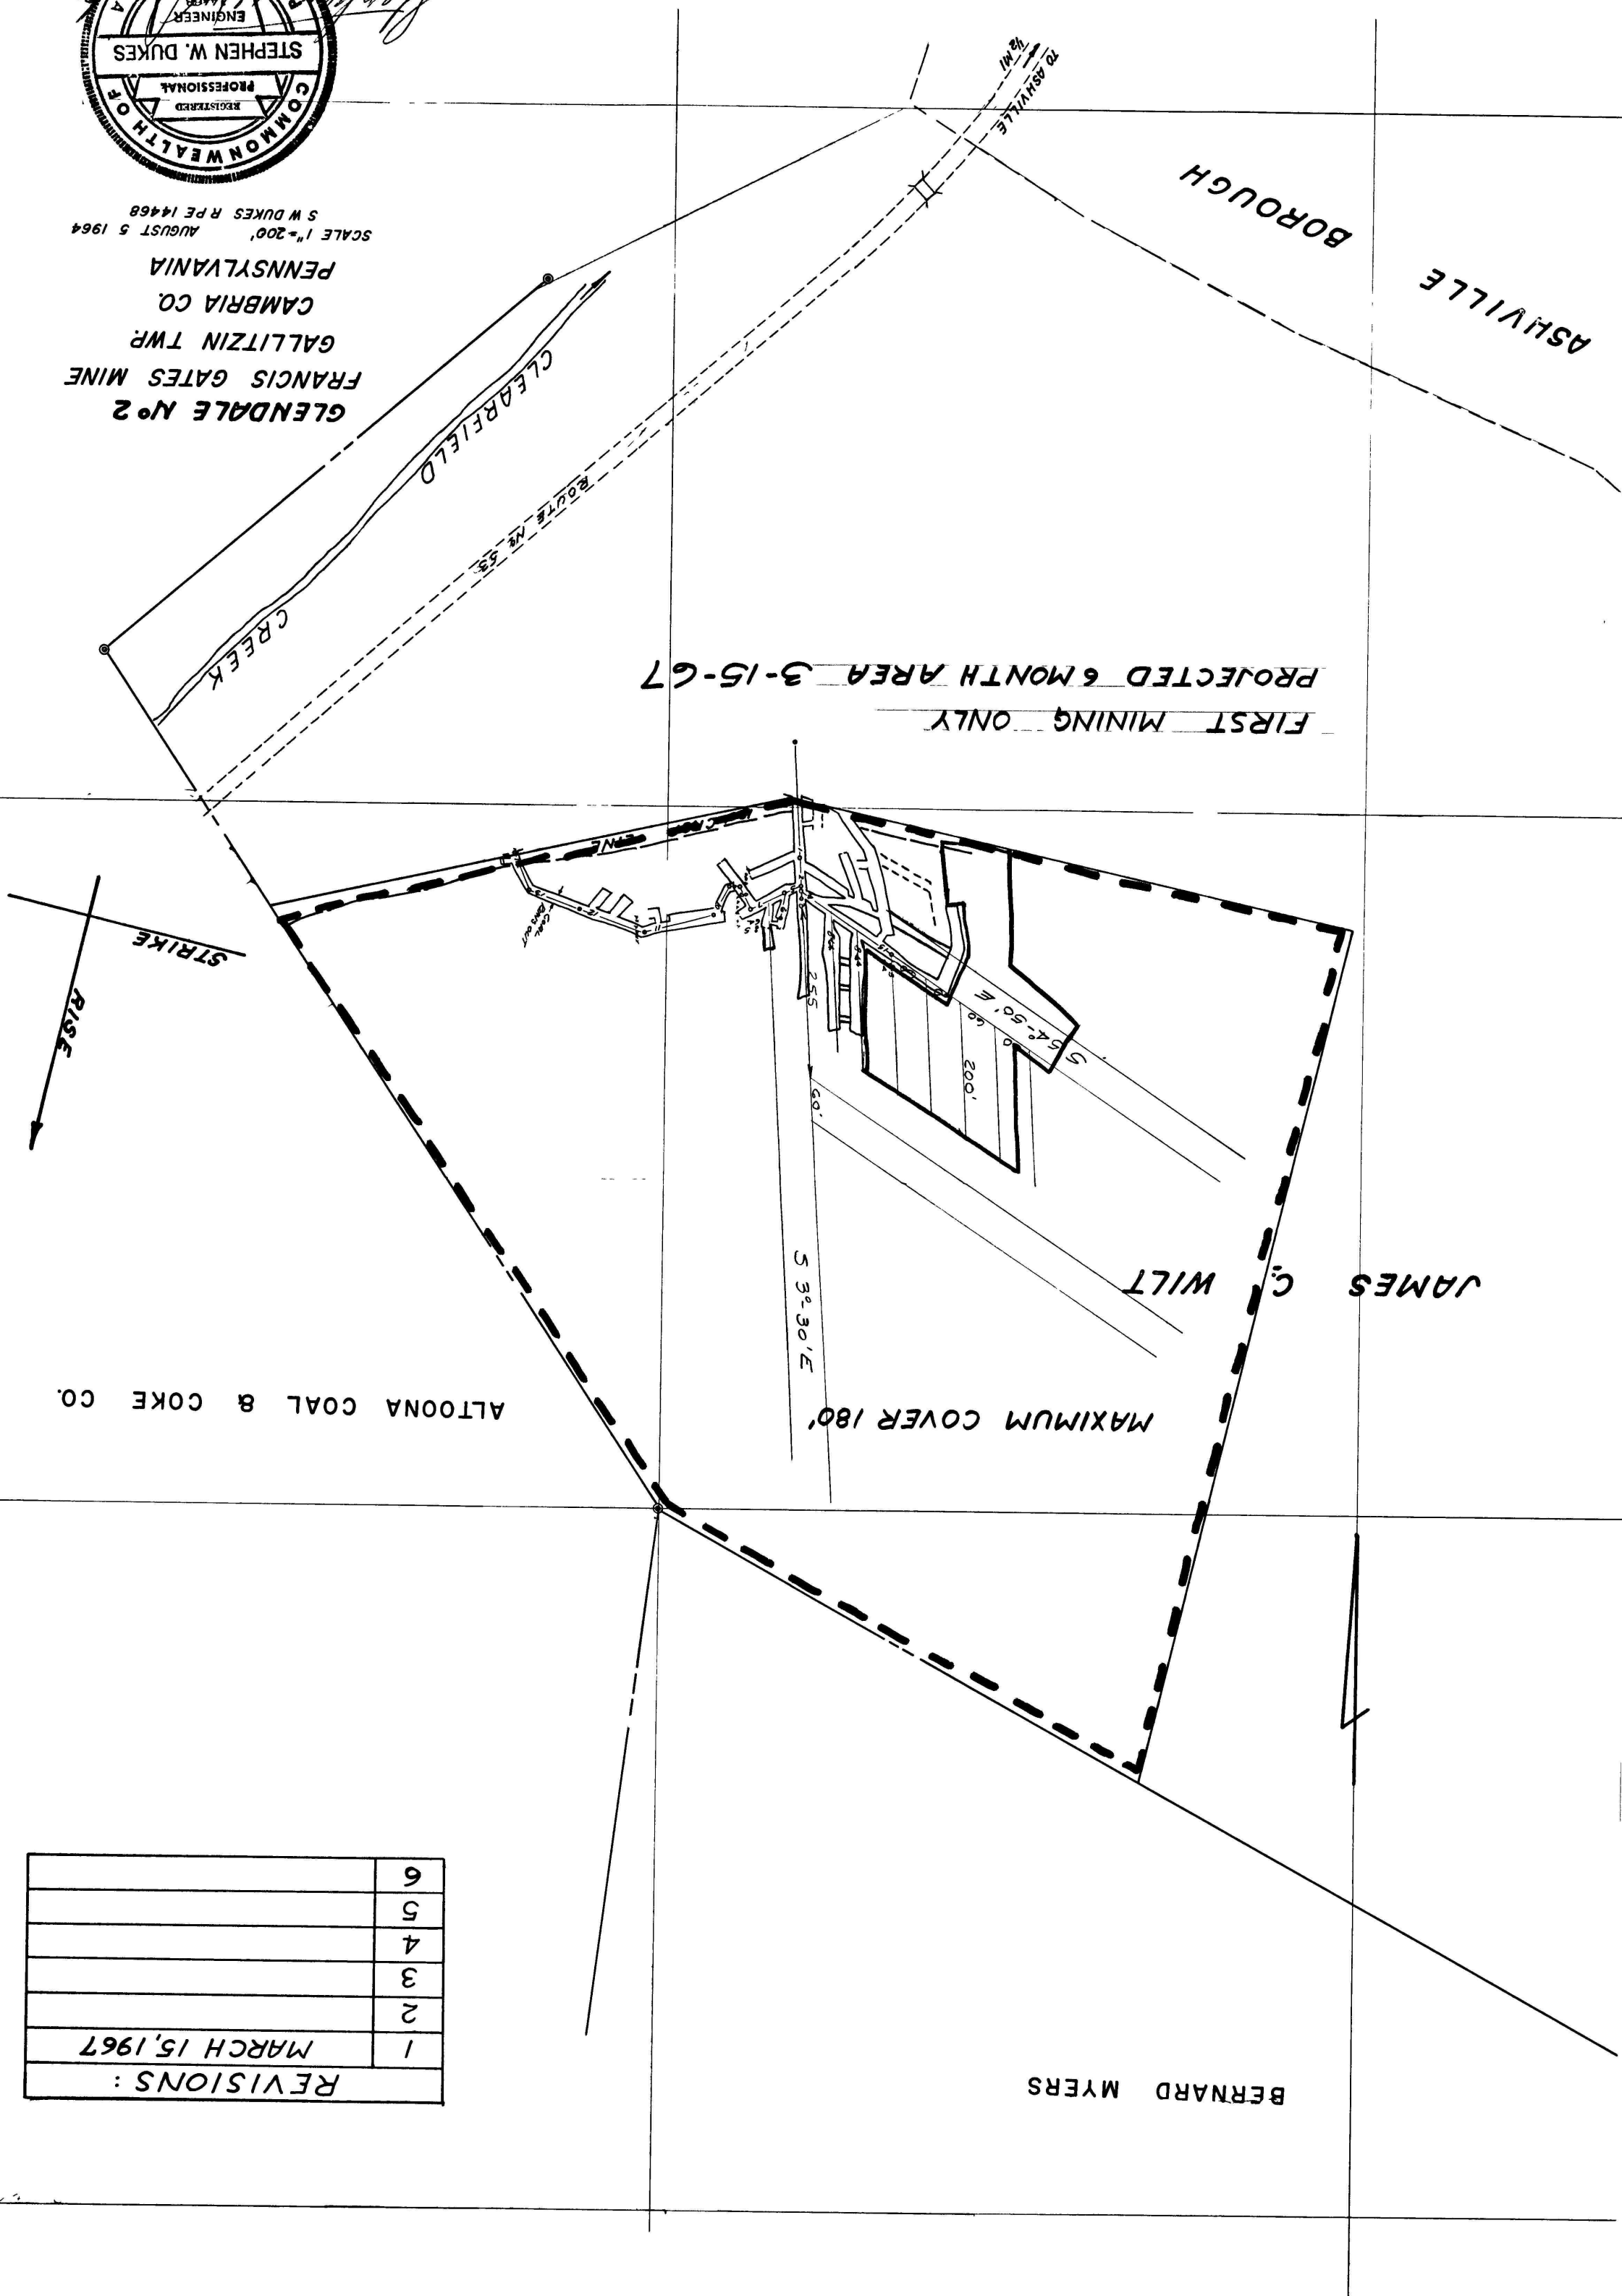

GLENDALE No 2
FRANCIS GATES MINE
GALLITZIN TWP
CAMBRIA CO.
PENNSYLVANIA
SCALE 1"=200'
AUGUST 5 1964
S W DUKES R PE 14468



REVISIONS :	
1	MARCH 15, 1967
2	
3	
4	
5	
6	

ALTOONA COAL & COKE CO.

BERNARD MYERS