


LEASEHOLD OF THE DENNY COAL & COKE CO.

LEASEHOLD OF THE DENNY COAL & COKE CO.

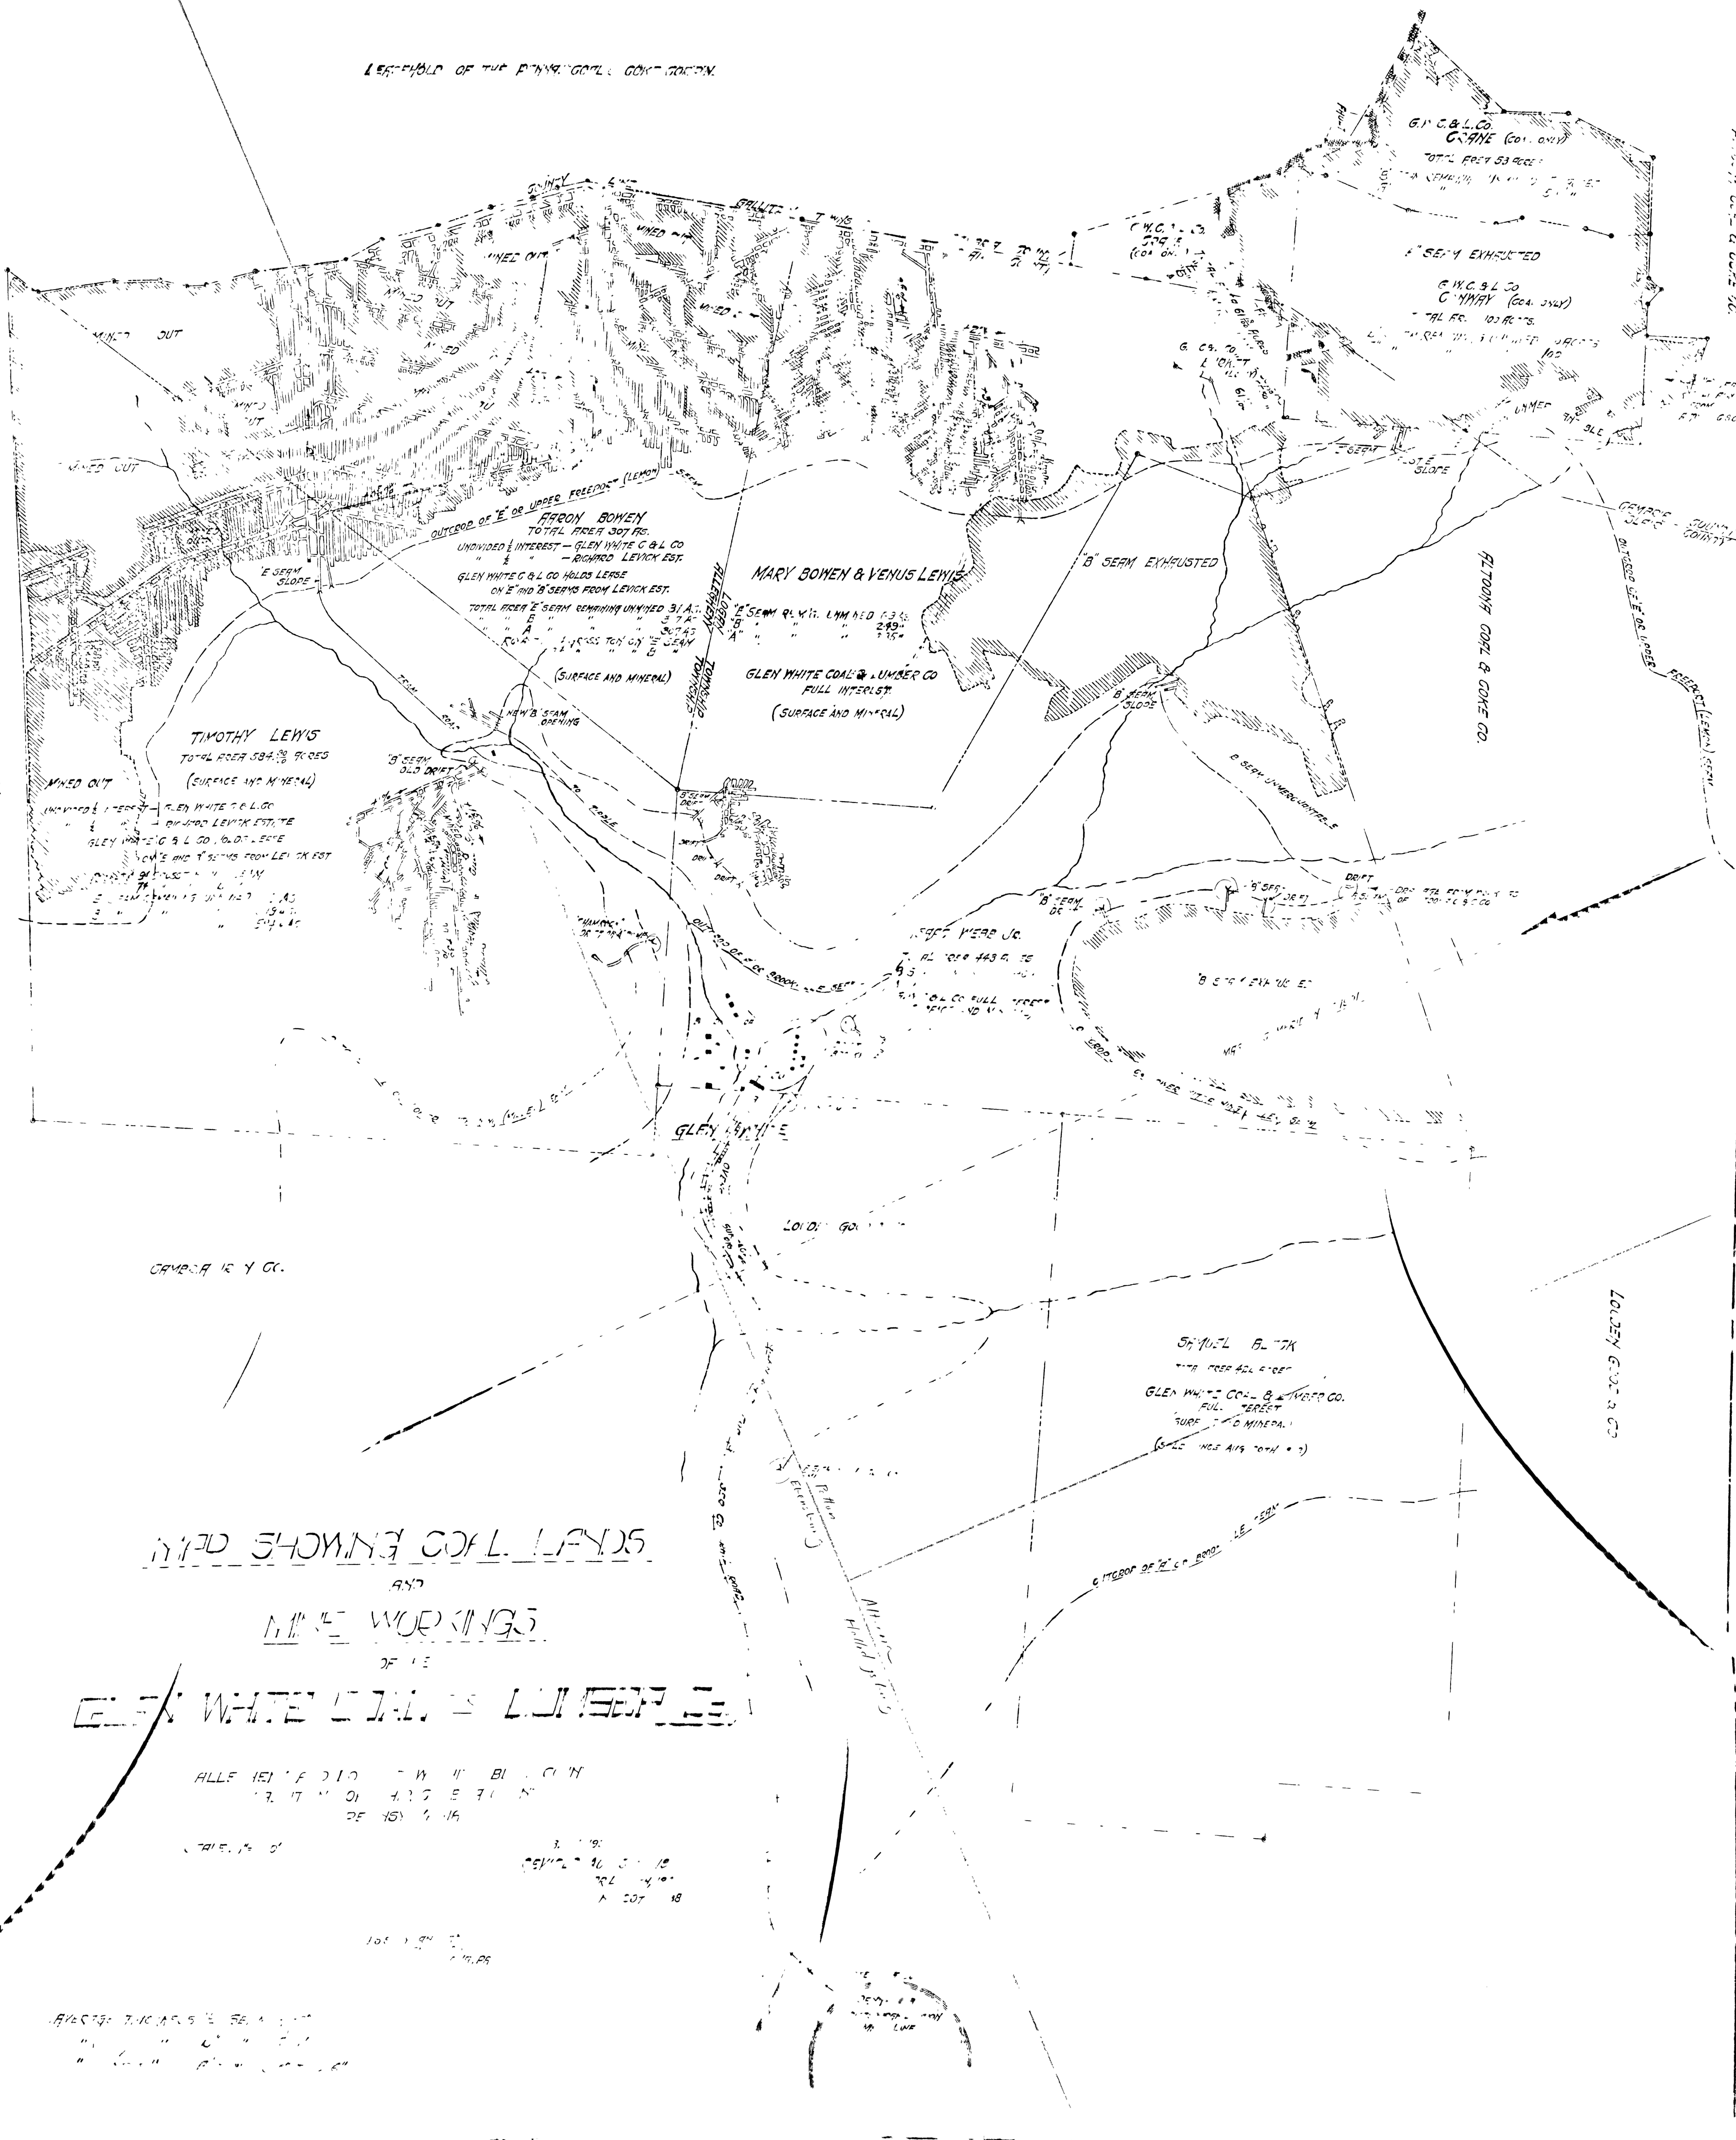


AND

MINING WORKINGS

OF THE


1917
DE 151 111




