


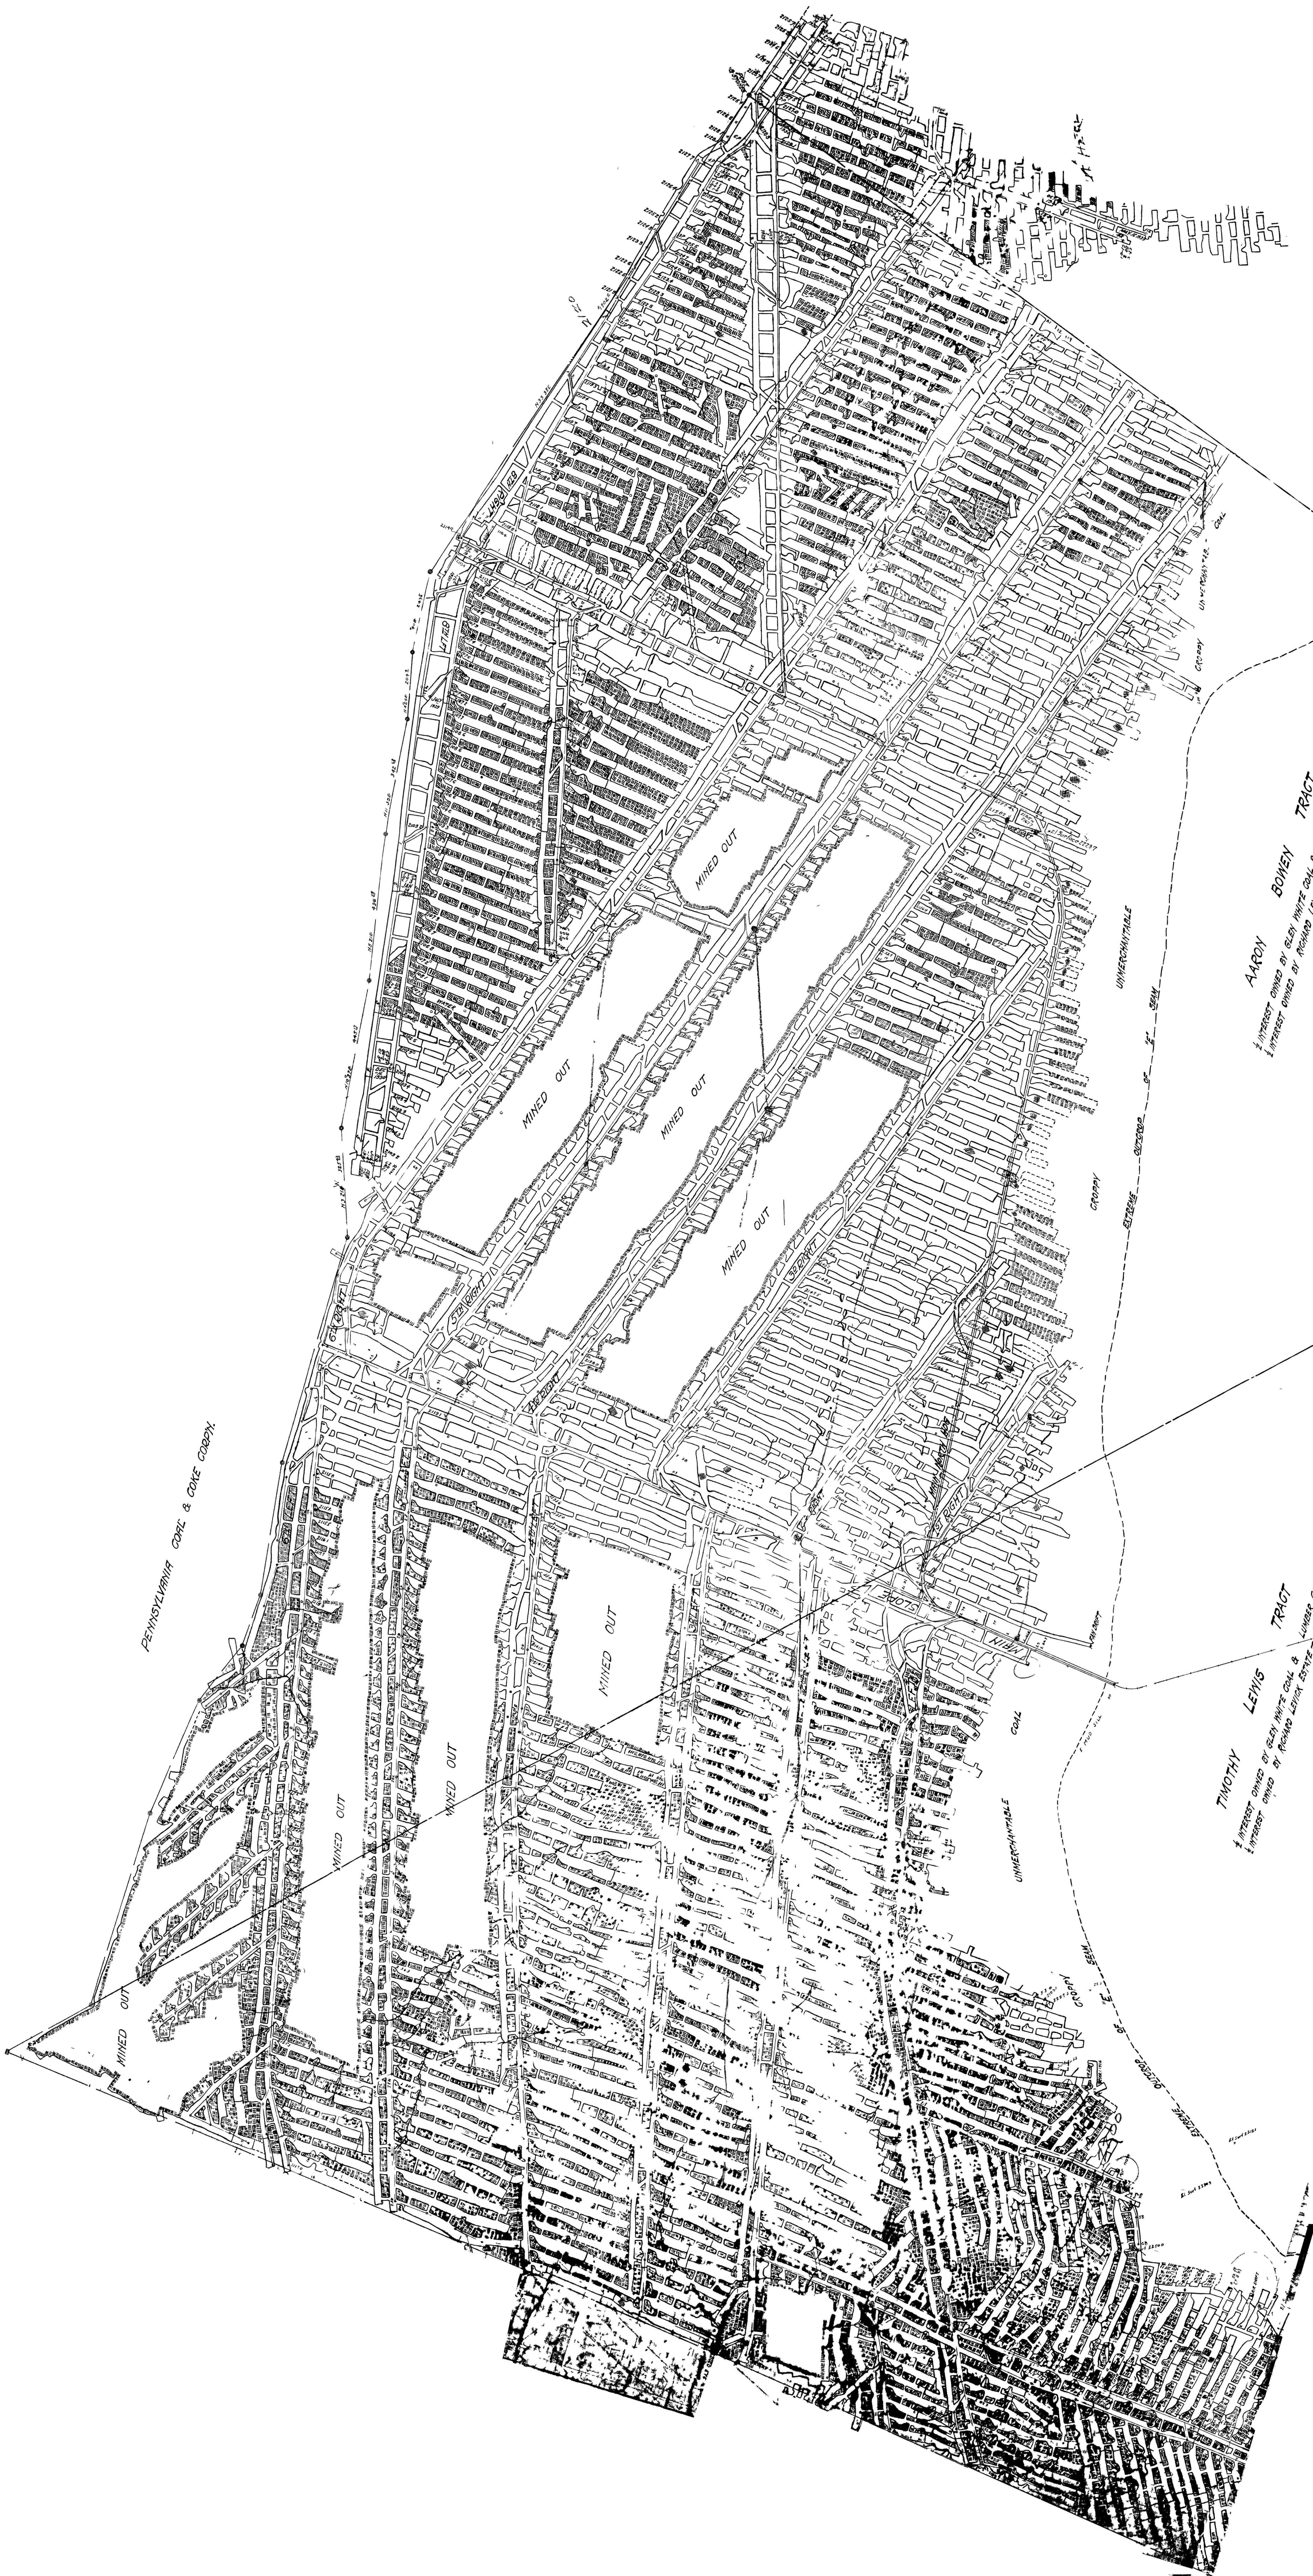

MARY JONES AND KENNY LEWIS TRACT

AARON BOWEN TRACT
INTEREST OWNED BY GLEN WHITE COAL & LUMBER CO.
INTEREST OWNED BY PENNSYLVANIA COAL & COKE CO. - LEASED TO GLEN WHITE COAL & LUMBER CO.

MAP OF THE
GLEN WHITE COAL & LUMBER CO'S
SLOPE MINE ON LEMMON OR E SEAM
SITUATE IN
Glen White, Blair Co., Pa.
SCALE 1/4 IN. = 1 MILE

TIMOTHY LEWIS TRACT
INTEREST OWNED BY GLEN WHITE COAL & LUMBER CO.
INTEREST OWNED BY PENNSYLVANIA COAL & COKE CO. - LEASED TO GLEN WHITE COAL & LUMBER CO.