


Gas Well
Coal 1907

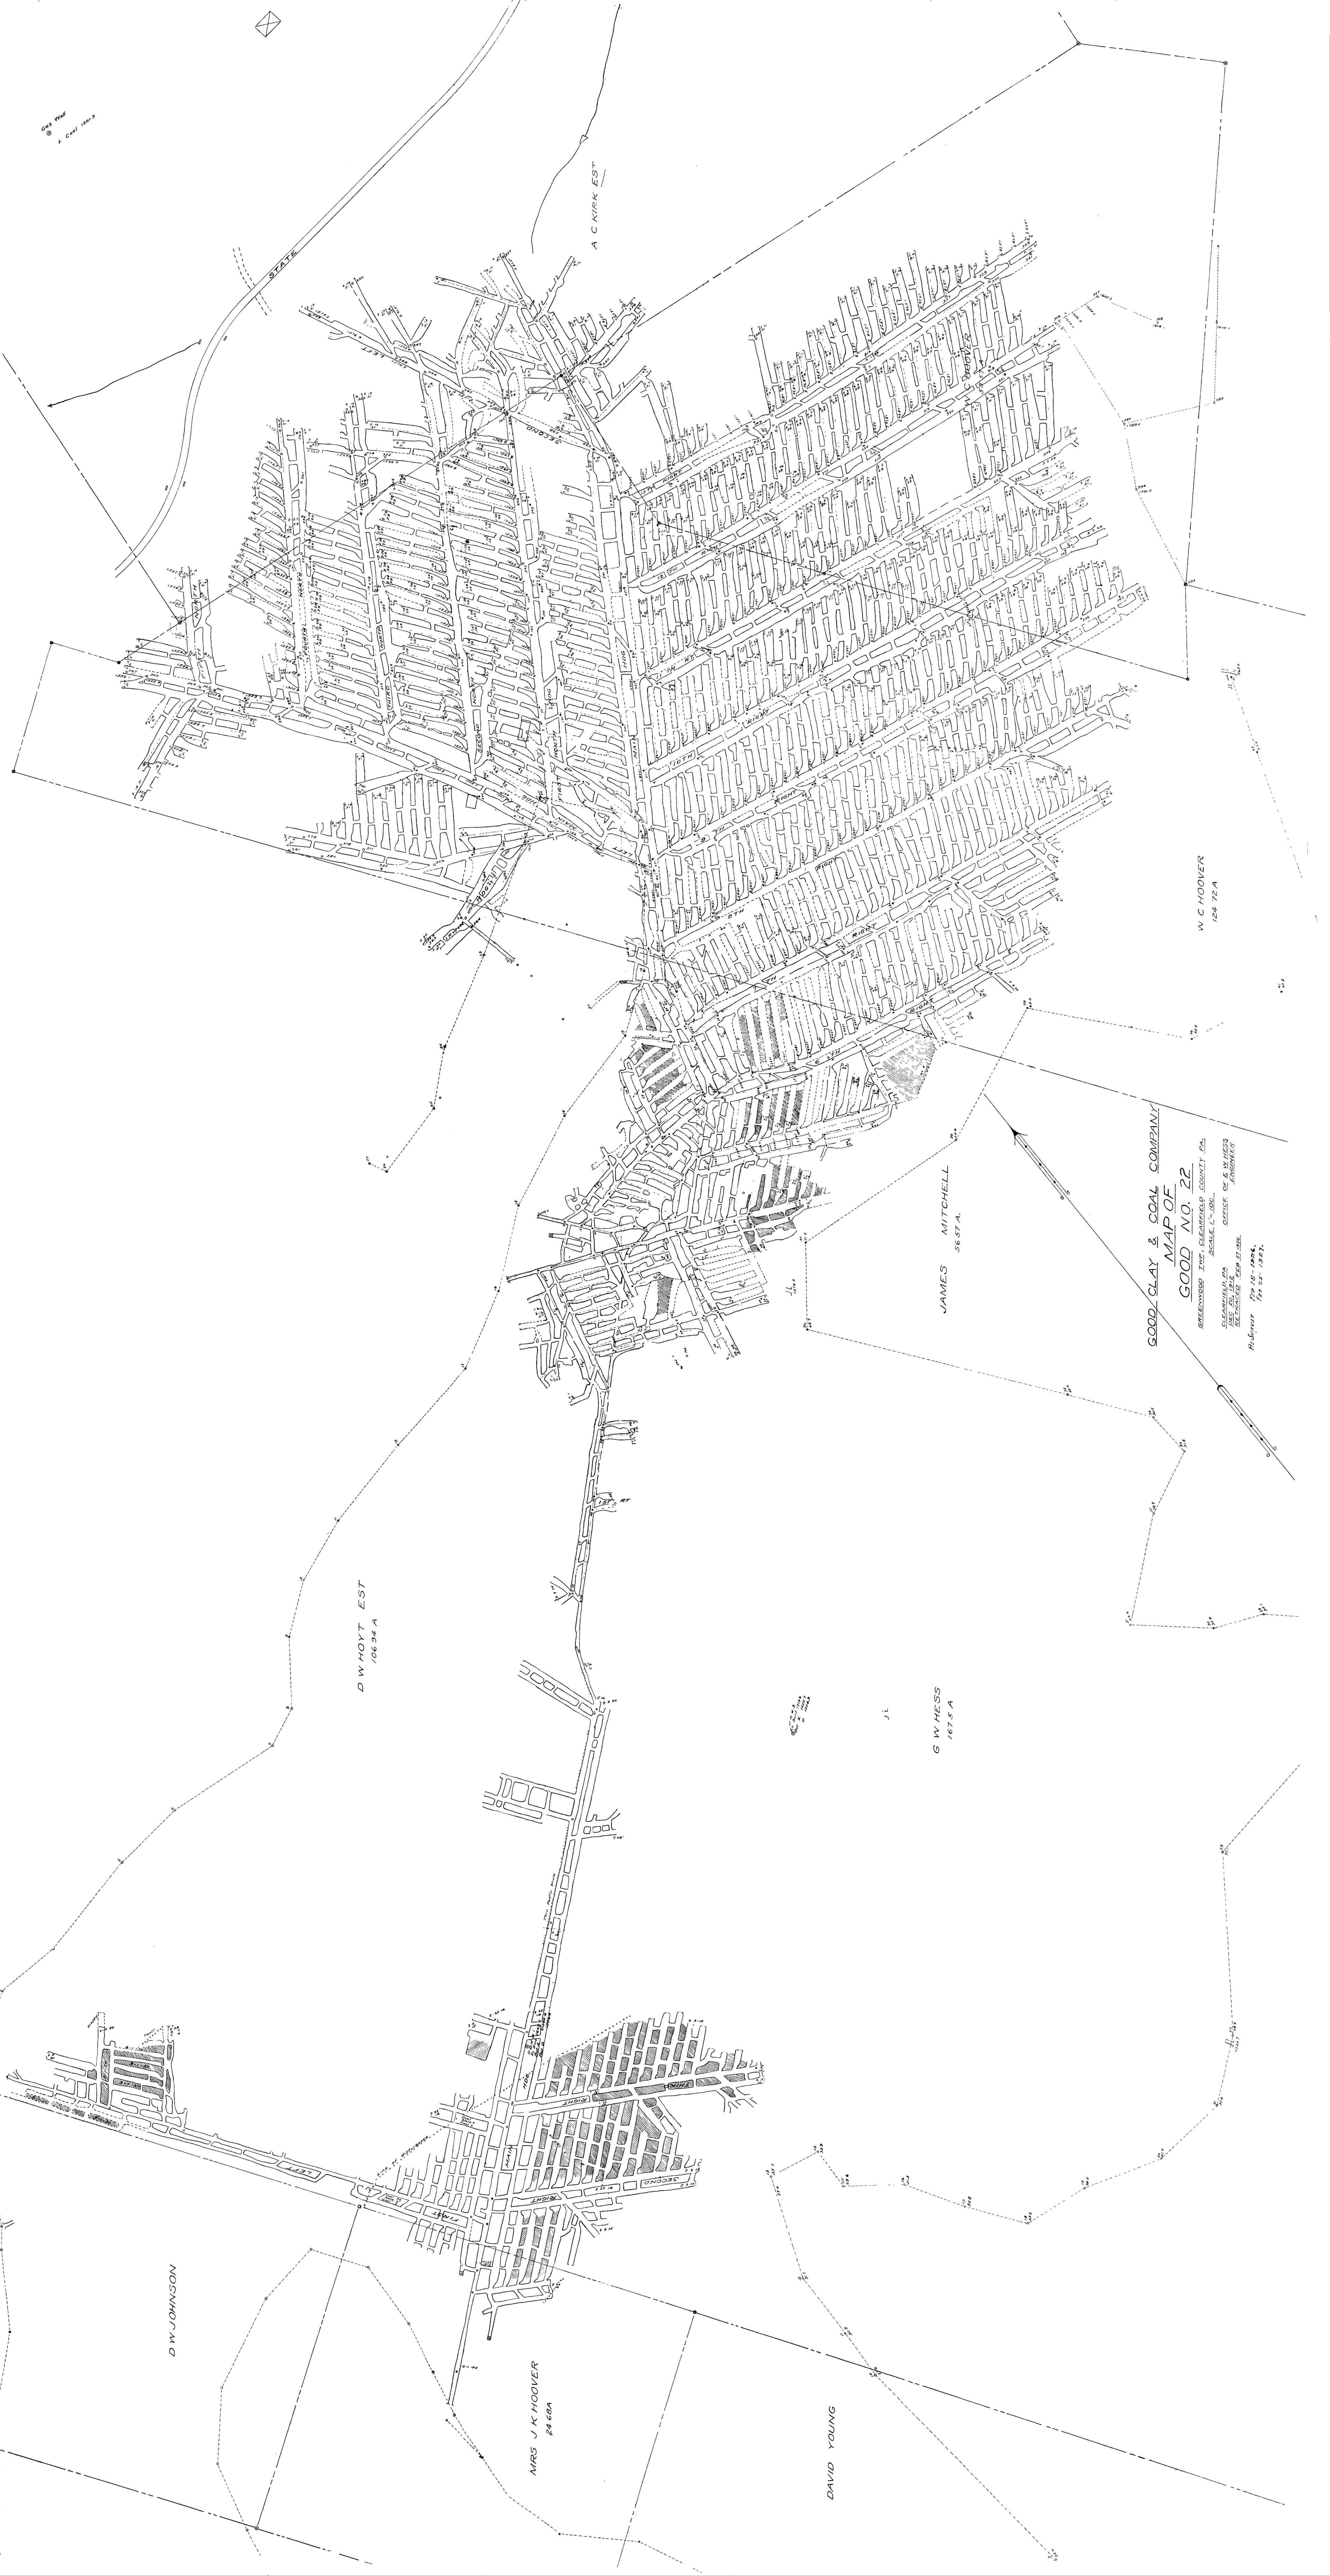

GOOD CLAY & COAL COMPANY
MAP OF
GOOD NO. 22

SCALE 1" = 100'
OFFICE OF E. W. HESS

W C HOOVER
124 72 A

JAMES MITCHELL
56 57 A

G W HESS
167 5 A

D W HOYT EST
106 34 A

D W JOHNSON

MRS J K HOOVER
24 68 A

DAVID YOUNG