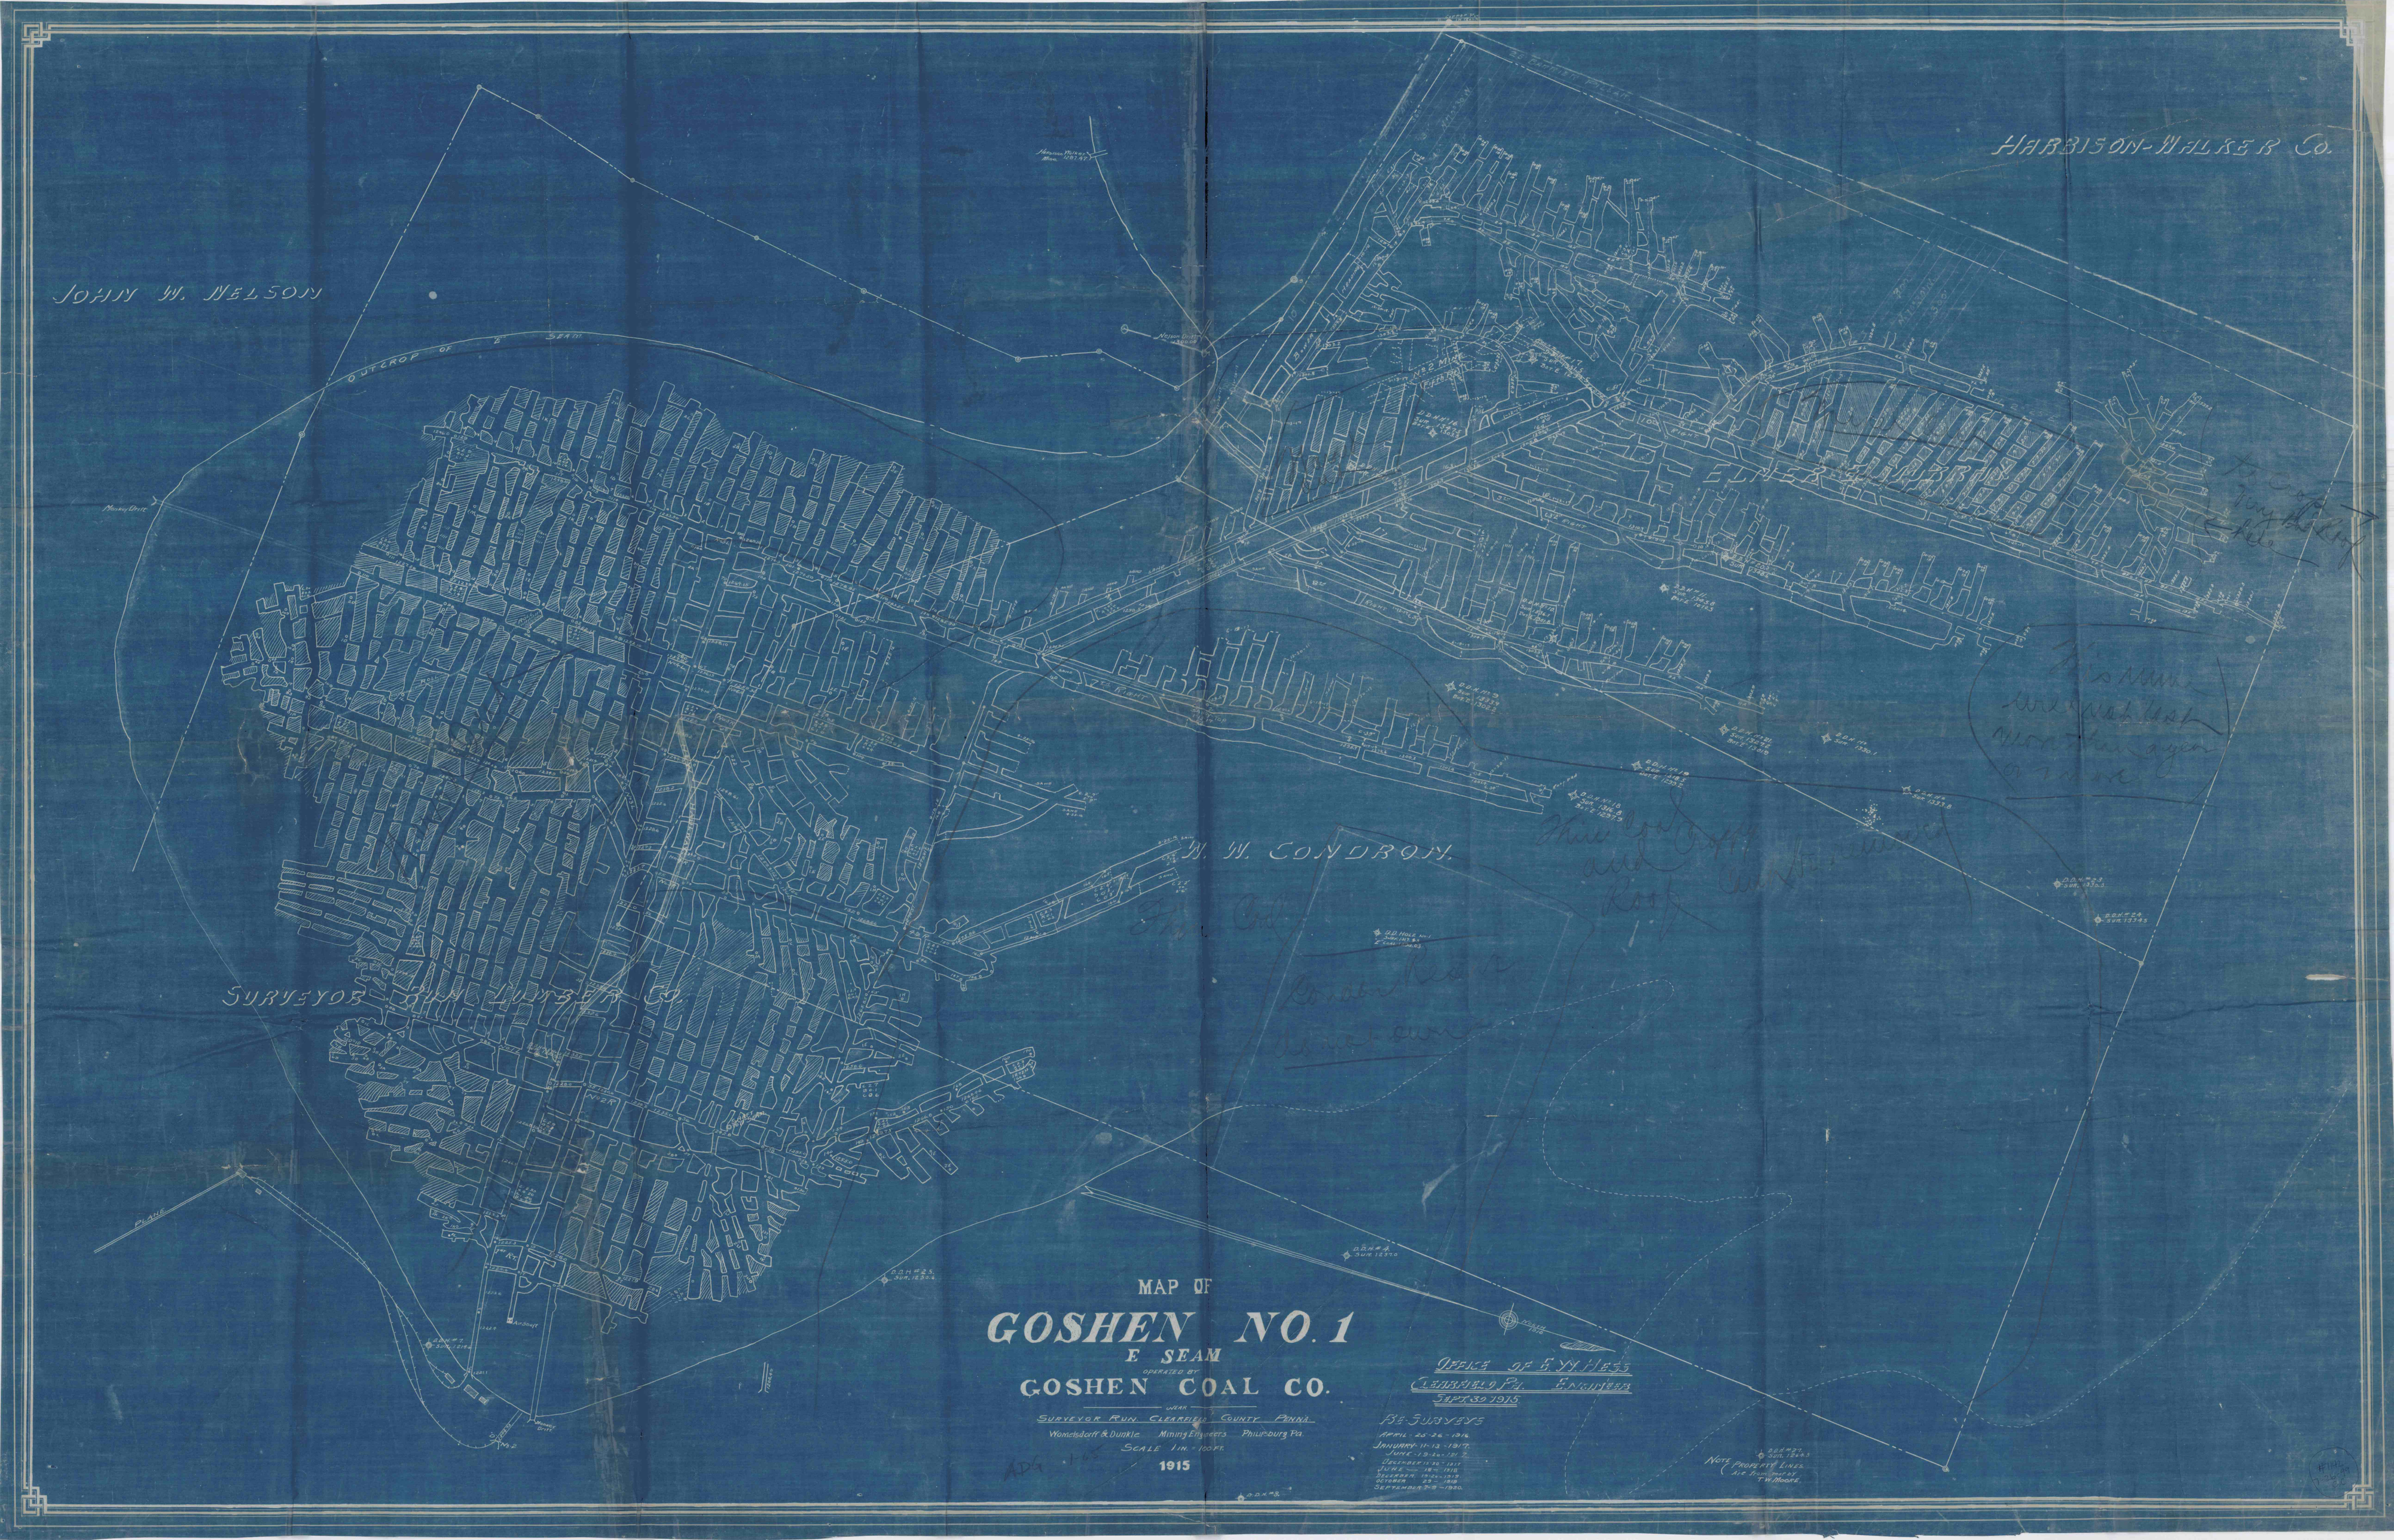
HARRISON-WALKER CO.
JOHN W. NELSON
OUTCROP OF E SEAM
W. W. CONDRON
SURVEYOR RUN LUMBER CO.
MAP OF
GOSHEN NO. 1
E SEAM
OPERATED BY
GOSHEN COAL CO.
NEAR
SURVEYOR RUN CLEARFIELD COUNTY PENNA.
Wonetsdorff & Dunkle Mining Engineers Philipsburg Pa.
SCALE 1 IN. = 100 FT.
1915
OFFICE OF E. M. HESS
CLEARFIELD PA. ENGINEER
SEPT. 30 1915.
RE-SURVEYS
APRIL 25-26-1916
JANUARY 11-13-1917
JUNE 13-24-1917
DECEMBER 11-26-1917
JUNE 1918
DECEMBER 1920-1919
OCTOBER 23-1919
SEPTEMBER 28-1920.
NOTE PROPERTY LINES
ARE APPROXIMATE
T.H. Moore.