


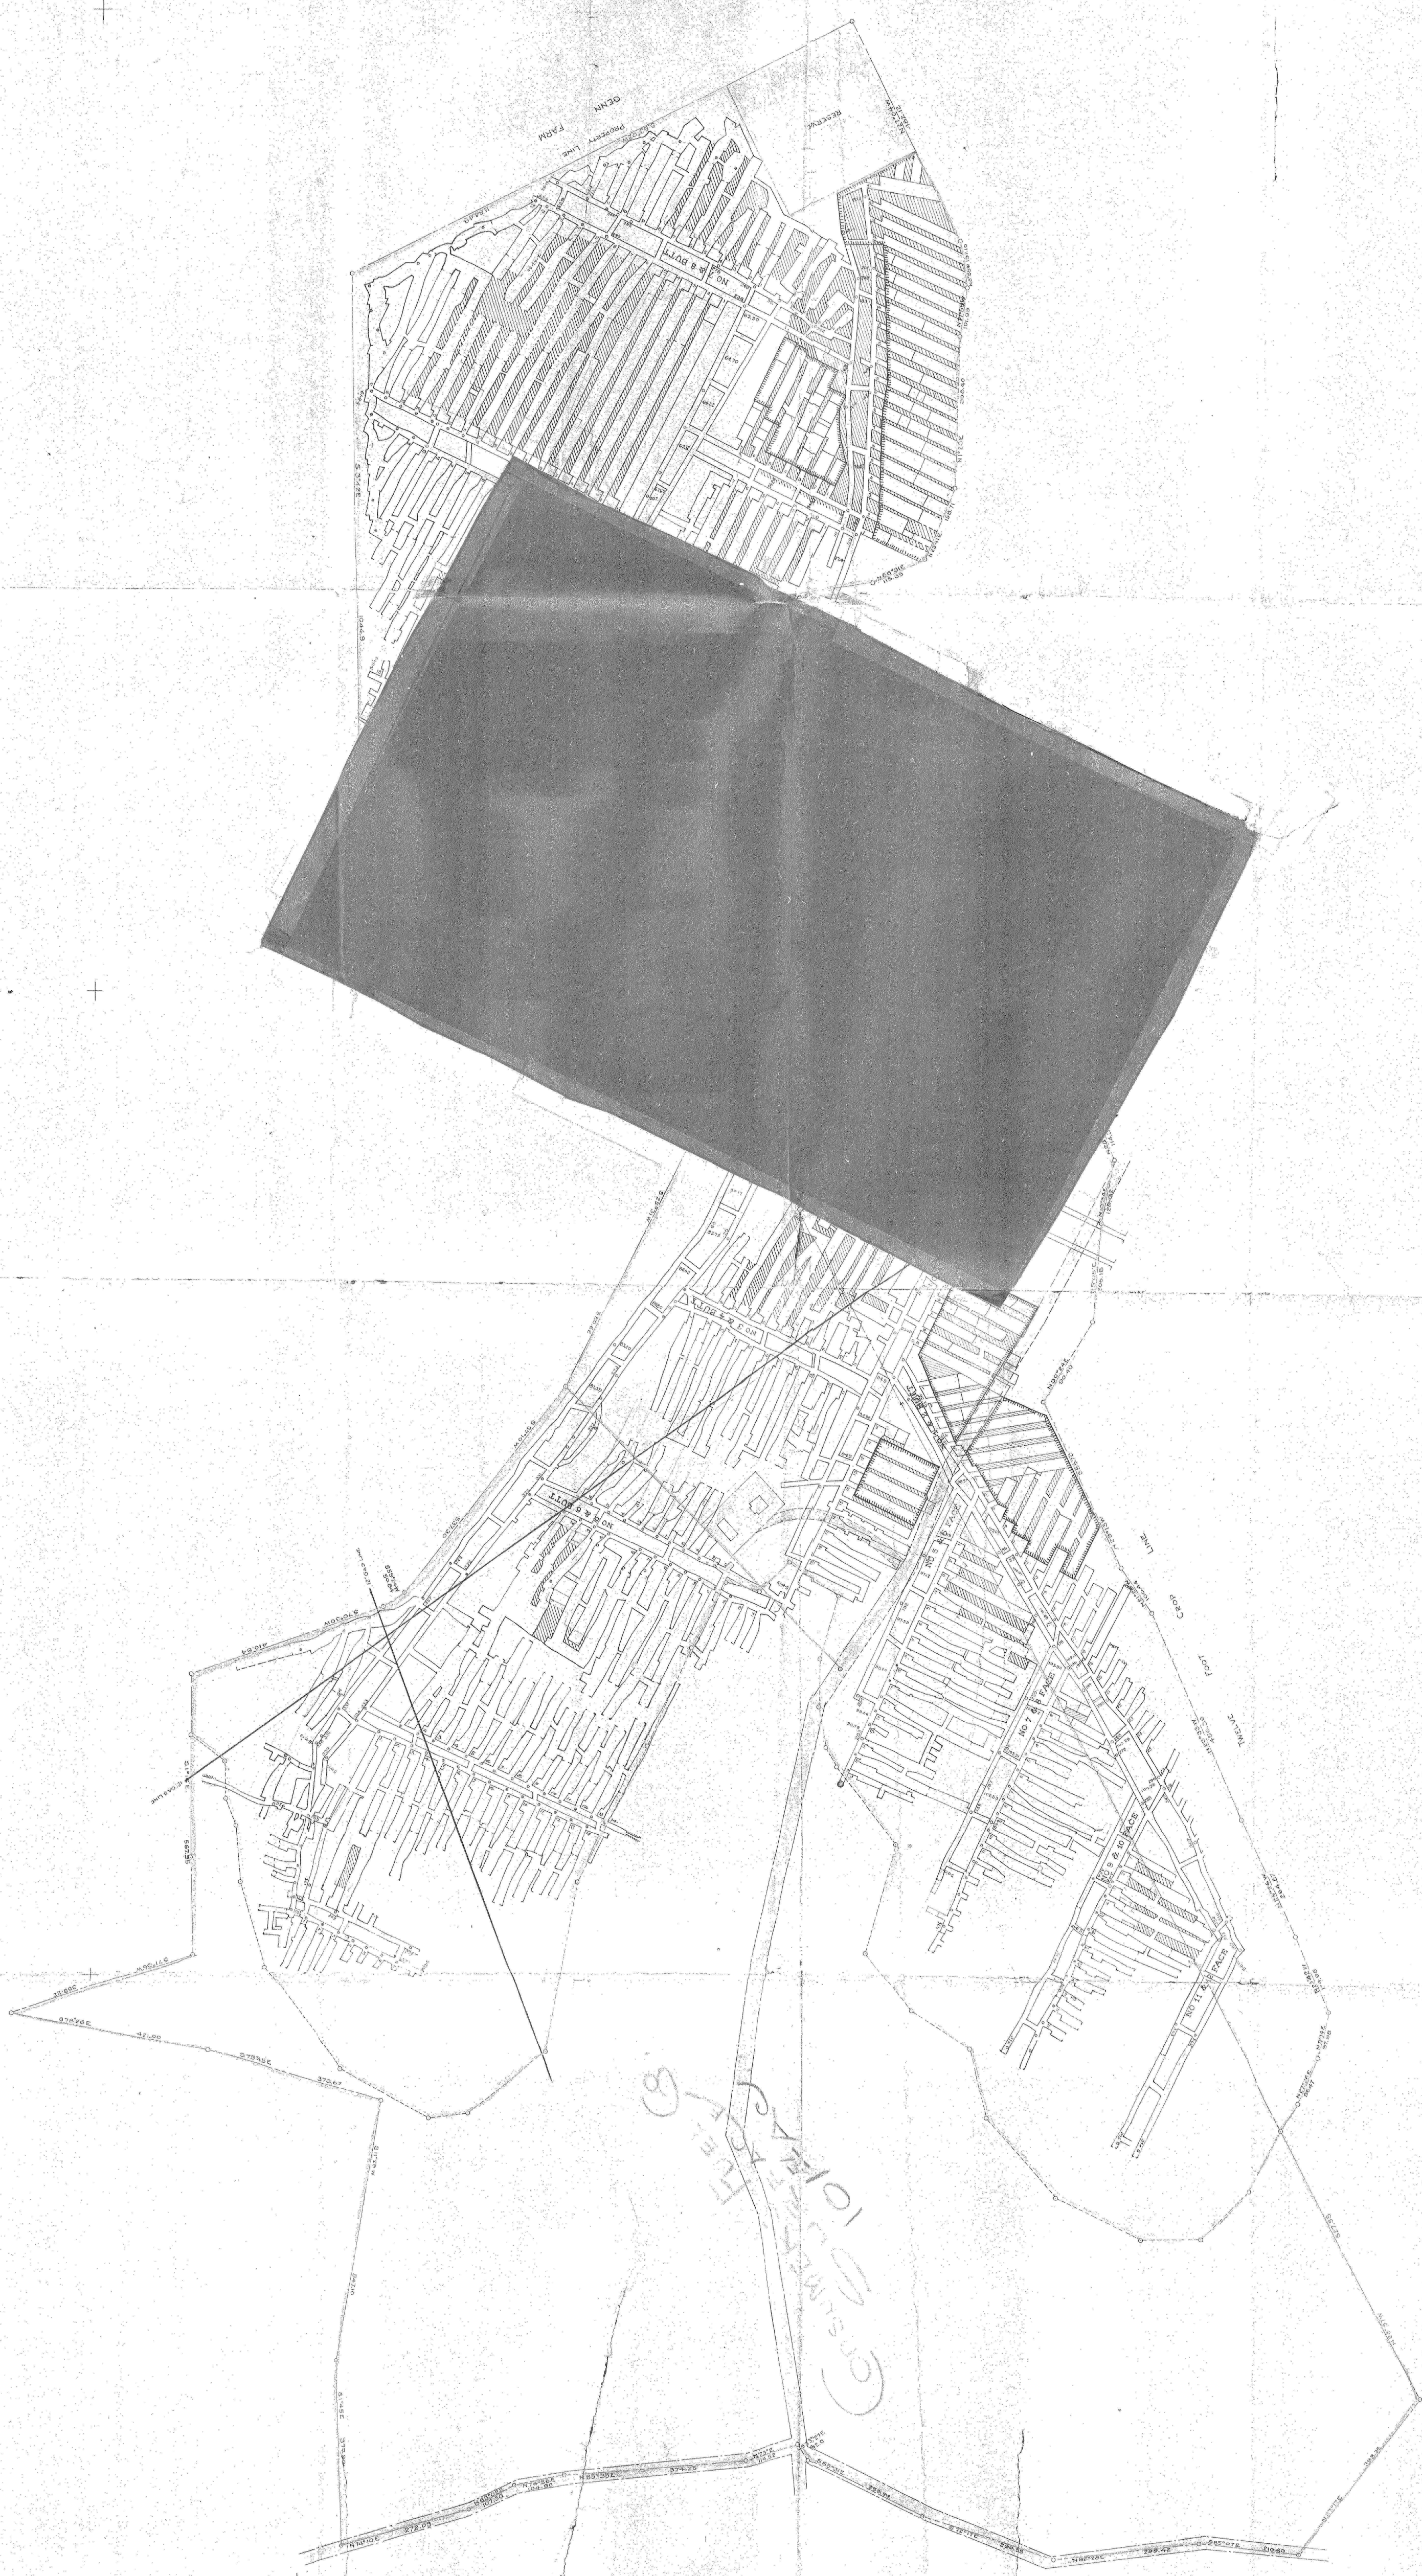

GOULD MINE
CONSUMERS FUEL CO.

SWOODEN TWP.
ALLEGHENY CO. PA.
MAY 26, 1918

CROP LINE of Pittsburgh Vein 32
SURFACE BOUNDARY 10/27/42

Dec. 31-1919