


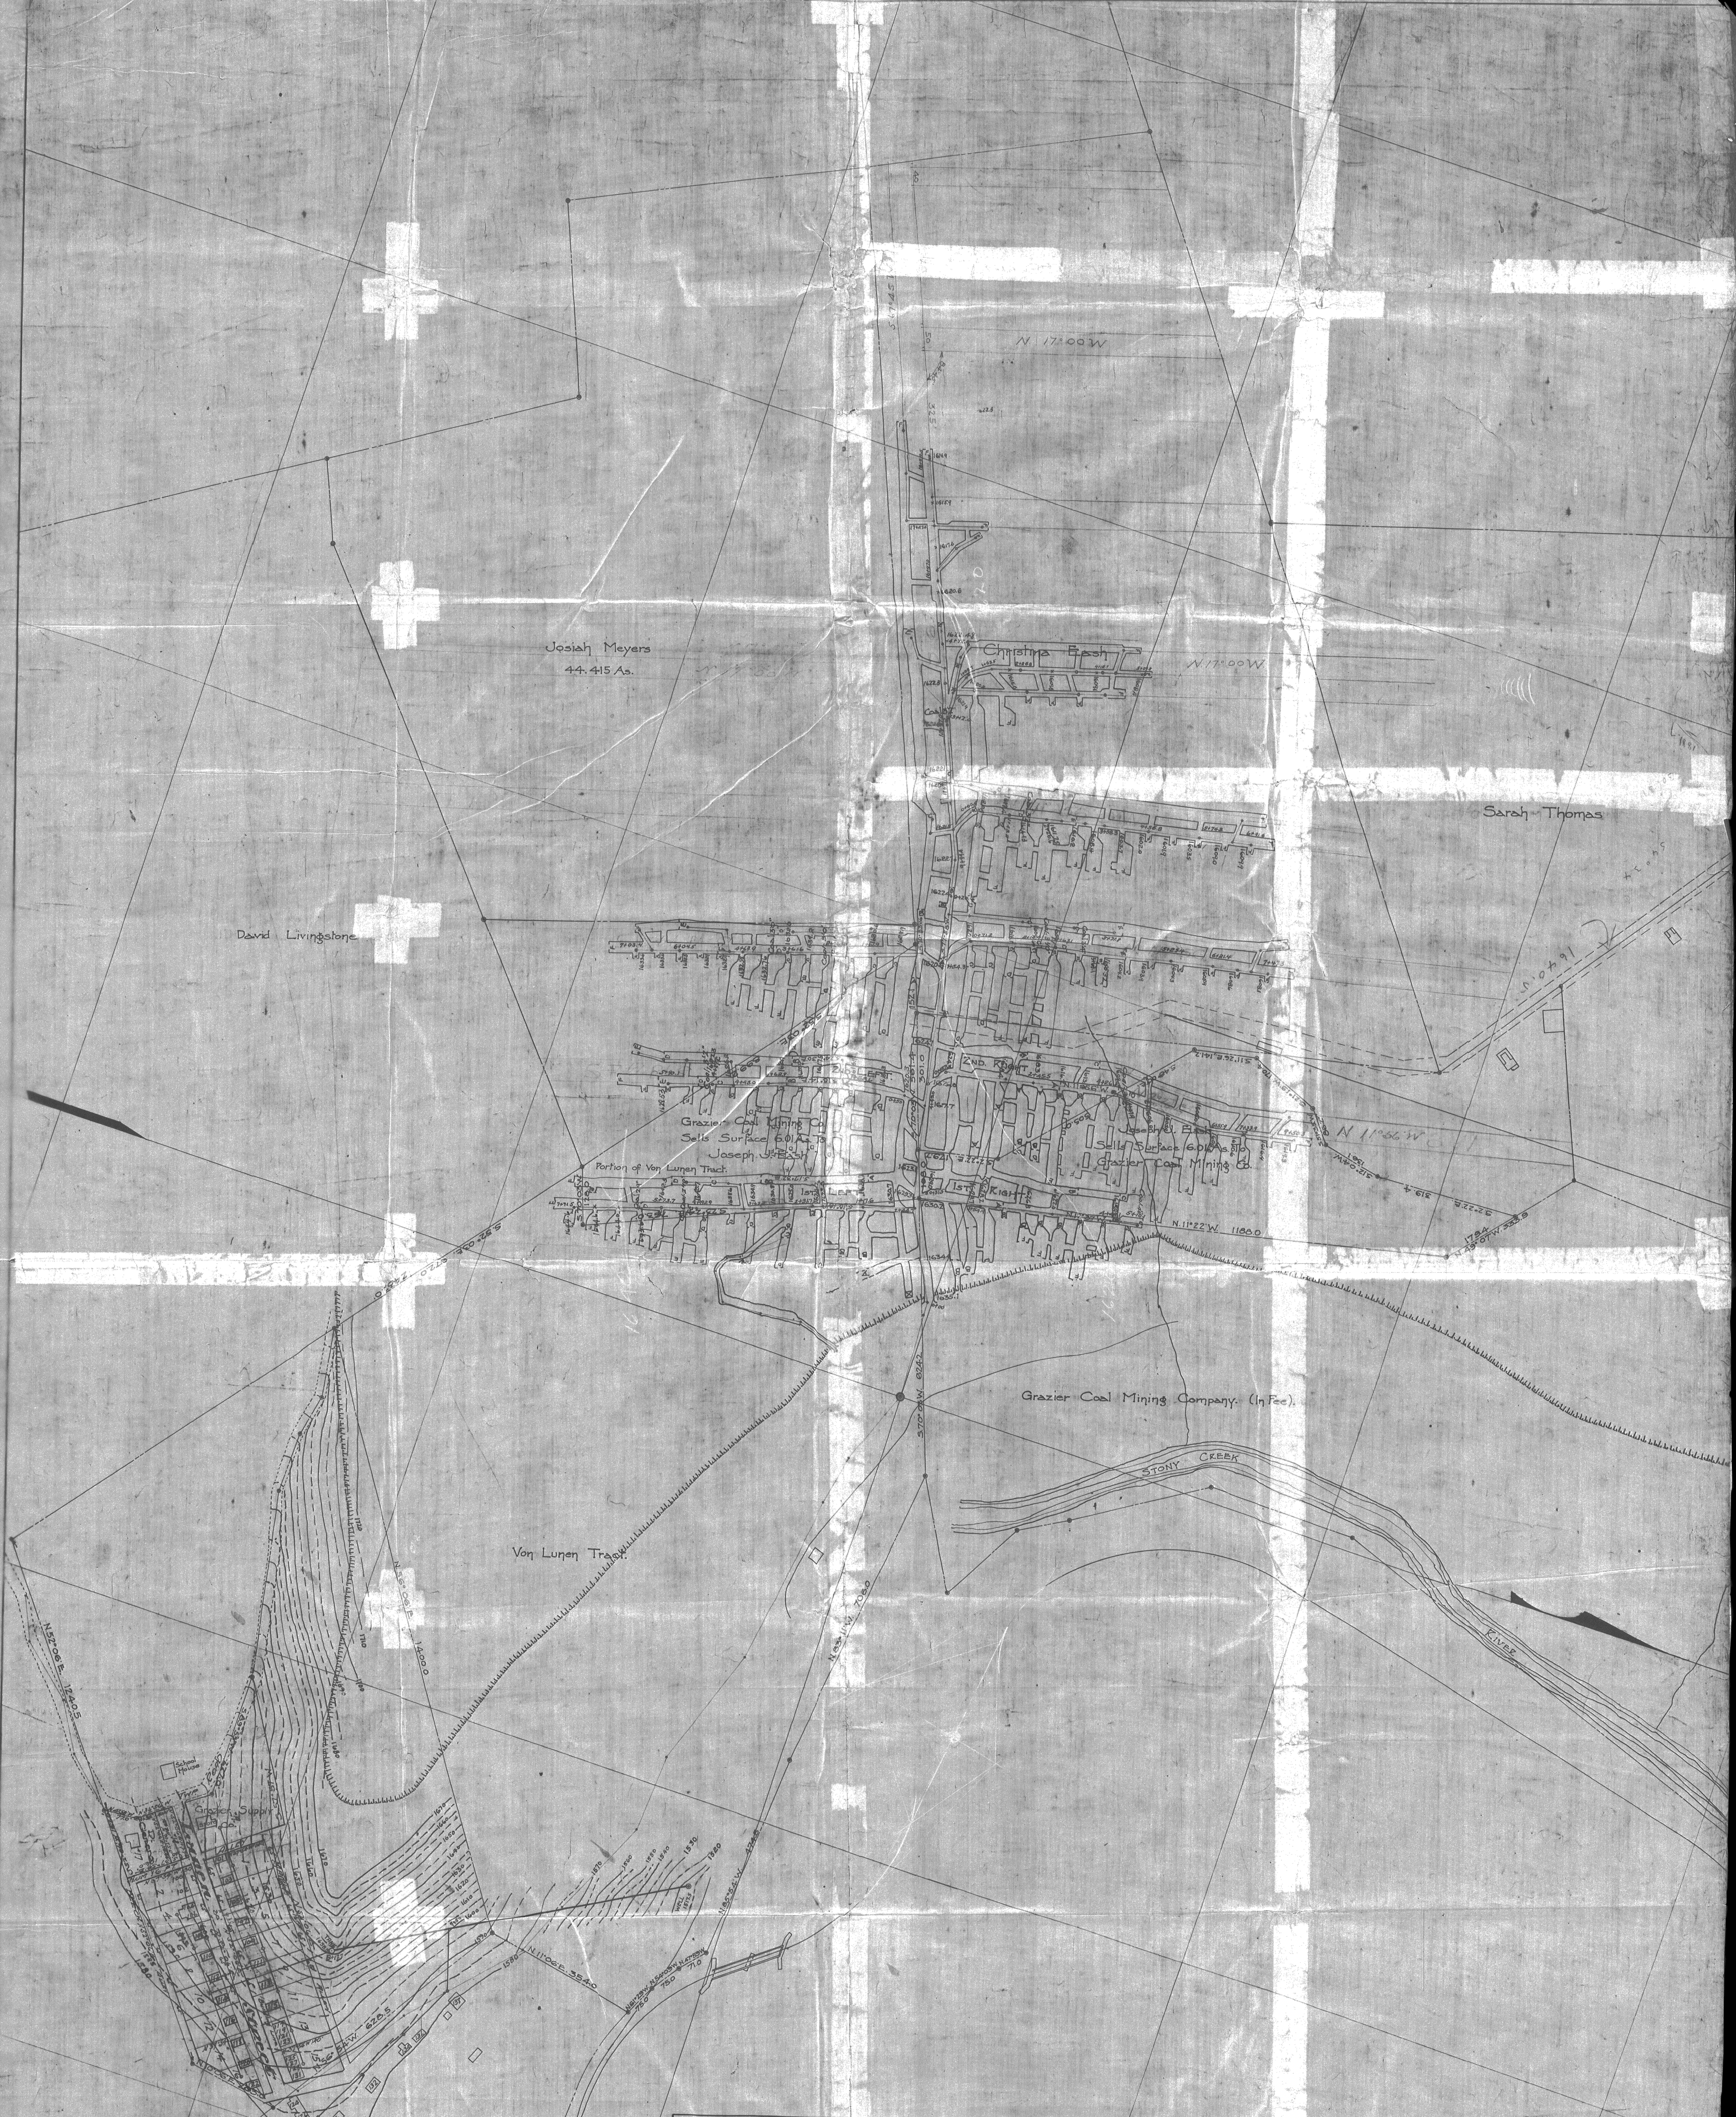

INDEX TO SURVEYS			
Letter	Date	Surveyed by	Plotted by
A	June 12, 1913	Edwin Eng. Co.	Edwin Eng. Co.
B	June 1, 1914	David Adams	David Adams
C	Oct. 26, 1914	E. M. Pace	E. M. Pace
D	Jan. 16, 1915	David Adams	David Adams
E	June 2, 1915	David Adams	David Adams
F	Jan. 16, 1916	E. M. Pace	E. M. Pace

GRAZIER COAL MINING CO.
 Showing
MINING OPERATIONS
 of
GRAZIER MINE No. 2.
 Situate in
 Conemaugh Township, Somerset County, Penna.
 Scale 1" = 100' June 15, 1914.
 C PRIME SEAM.

S. E. Dickey & Co.
 Civil & Mining Engrs.
 Johnstown, Penna.