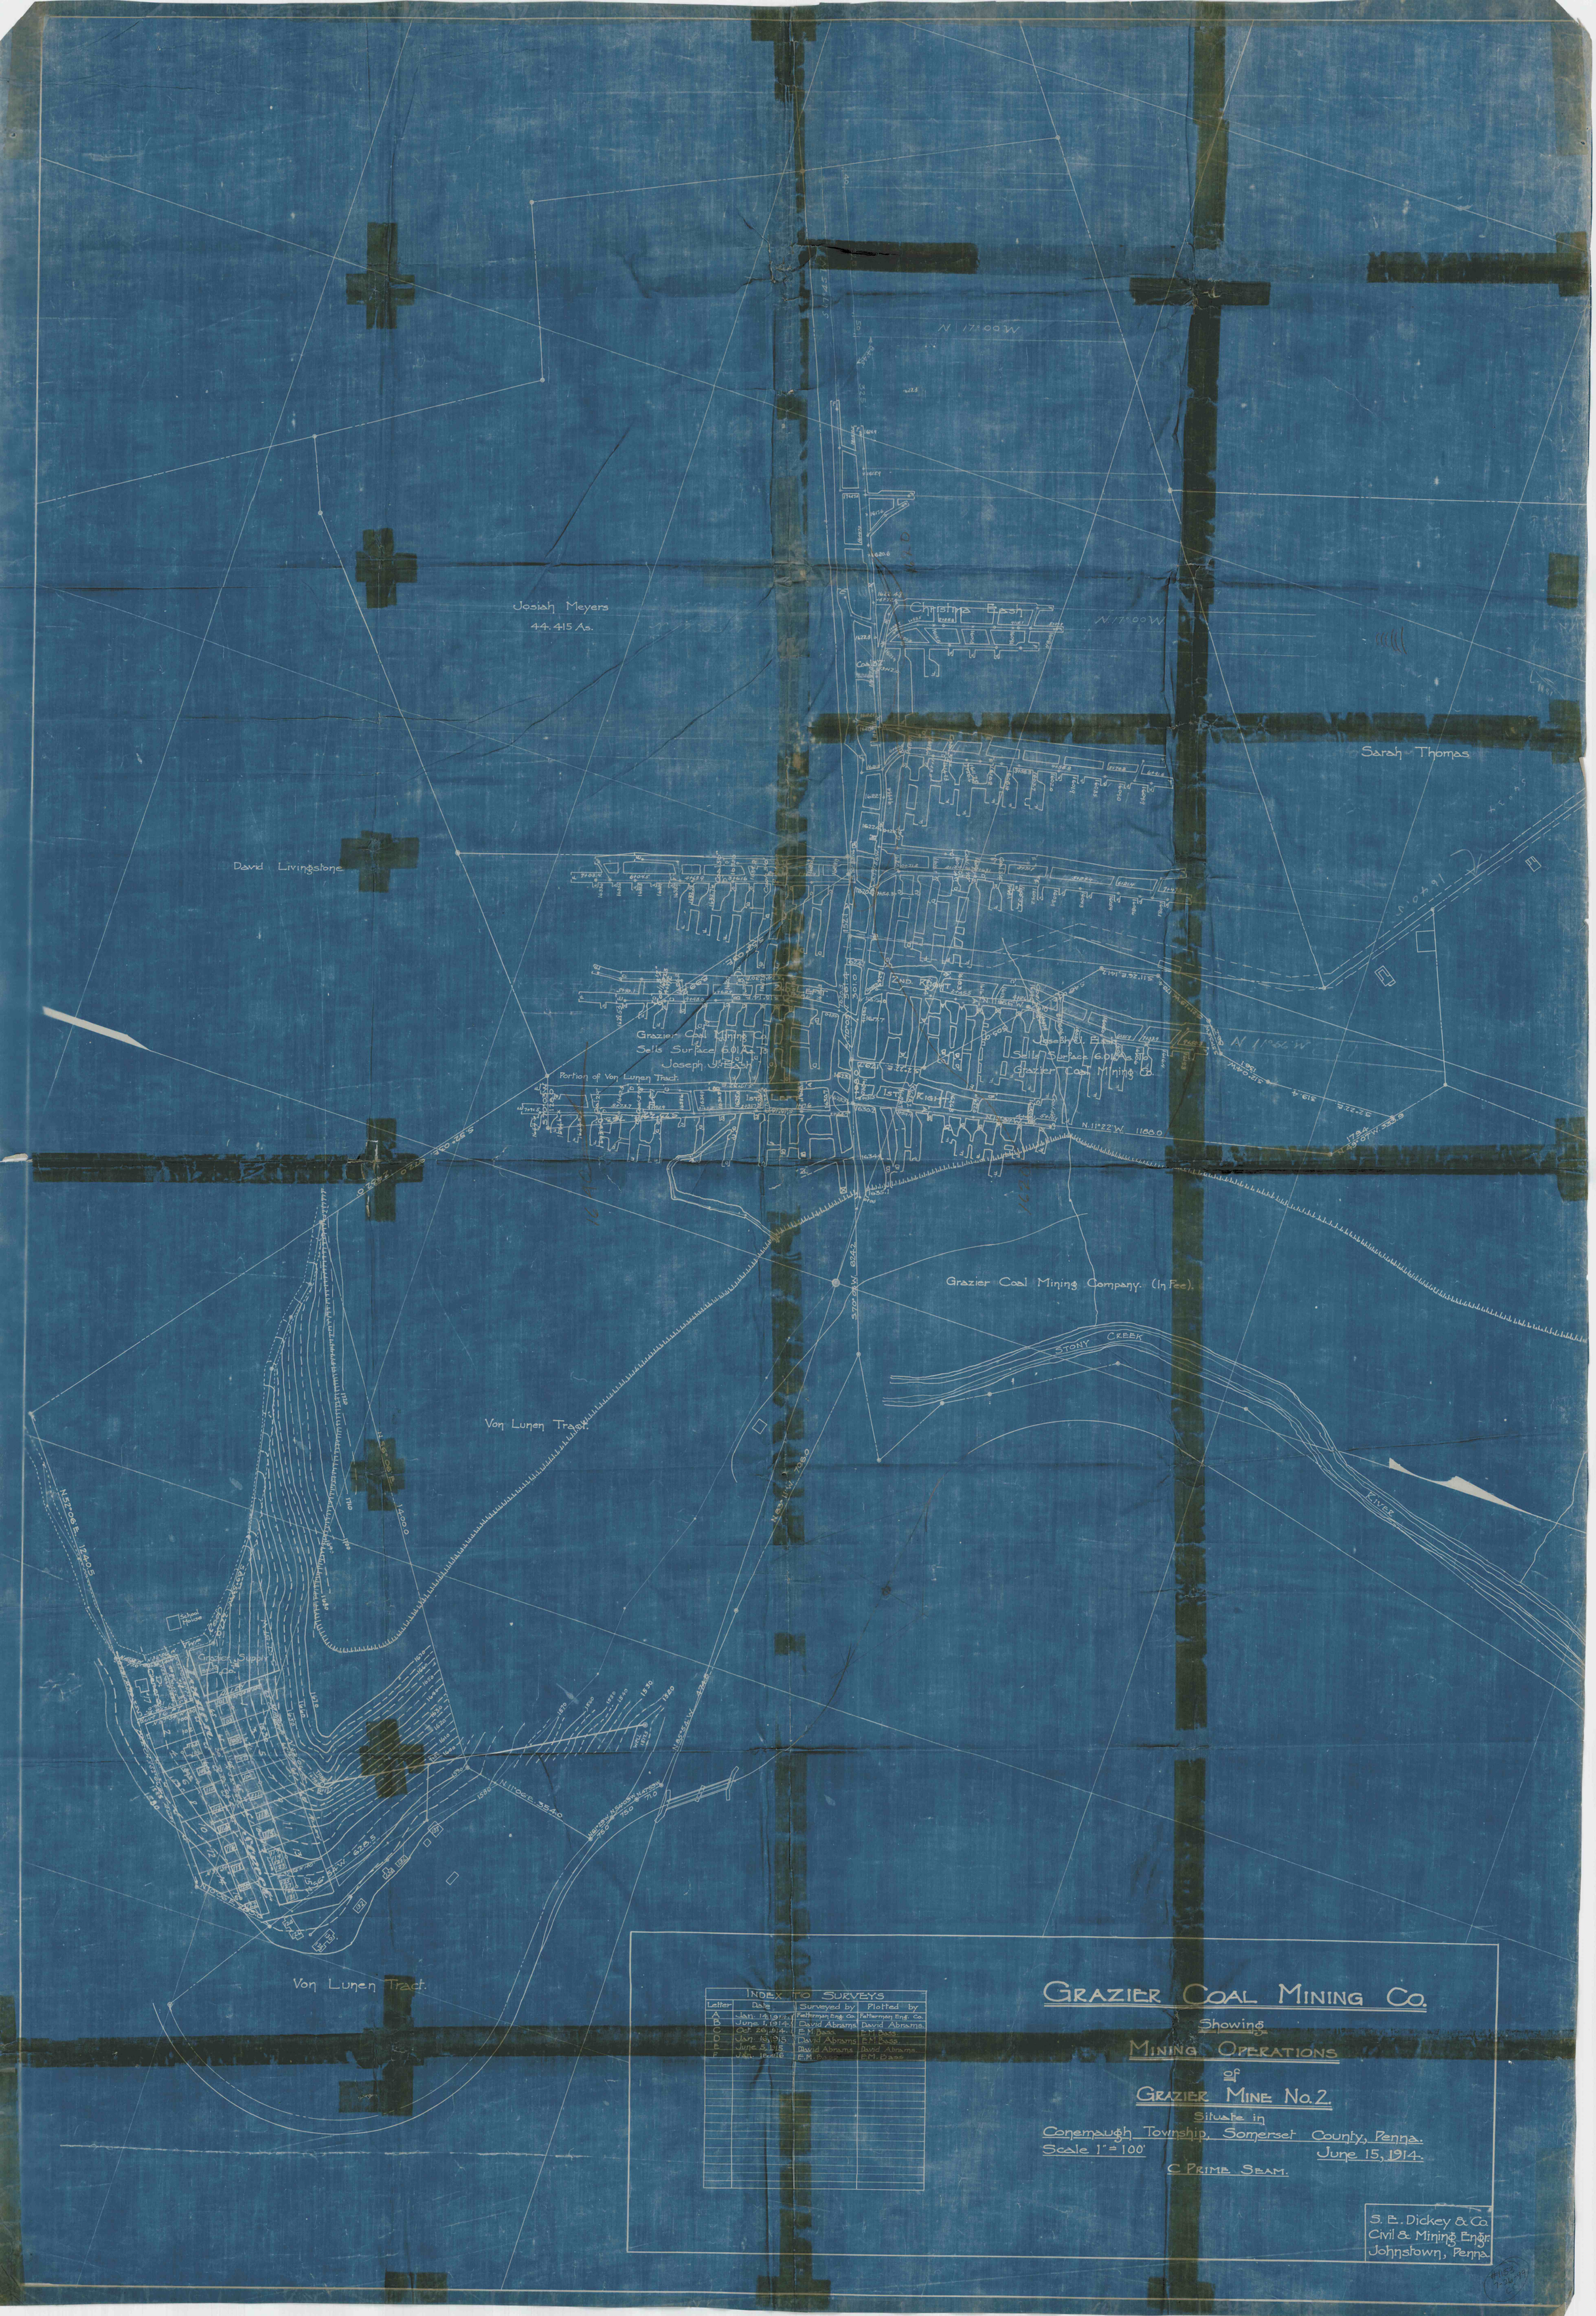
Josiah Meyers
44.415 As.
Christine Bash
N.17°00W
Sarah Thomas
David Livingstone
2ND. RIGHT
Grazier Coal Mining Co.
Sells Surface 6.01 As to
Joseph J. Bash
Portion of Von Lunen Tract.
Joseph J. Bash
Sells Surface 6.01 As to
Grazier Coal Mining Co.
1ST. RIGHT
N.11°22'W. 1180
Grazier Coal Mining Company. (In Fee).
STONY CREEK
RIVER
Von Lunen Tract.
School House
Grazier Supply Co.
N.52°06'E. 12405
N.11°06'E. 3540
Von Lunen Tract.
INDEX TO SURVEYS
Letter | Date | Surveyed by | Plotted by
A | Jan. 14, 1912 | Patterson Eng. Co. | Patterson Eng. Co.
B | June 1, 1914 | David Abrams | David Abrams
C | Oct. 26, 1914 | E.M. Bass | E.M. Bass
D | Jan. 16, 1915 | David Abrams | E.M. Bass
E | June 5, 1915 | David Abrams | David Abrams
F | Jan. 16, 1916 | E.M. Bass | E.M. Bass
GRAZIER COAL MINING CO.
Showing
MINING OPERATIONS
of
GRAZIER MINE No. 2.
Situate in
Conemaugh Township, Somerset County, Penna.
Scale 1" = 100'
June 15, 1914.
C PRIME SEAM.
S. E. Dickey & Co.
Civil & Mining Engr.
Johnstown, Penna.