




Topography compiled from aerial photography taken April, 1967
Aerial Map Service Co. Pittsburgh, Pennsylvania for

DEEP MINE SAFETY

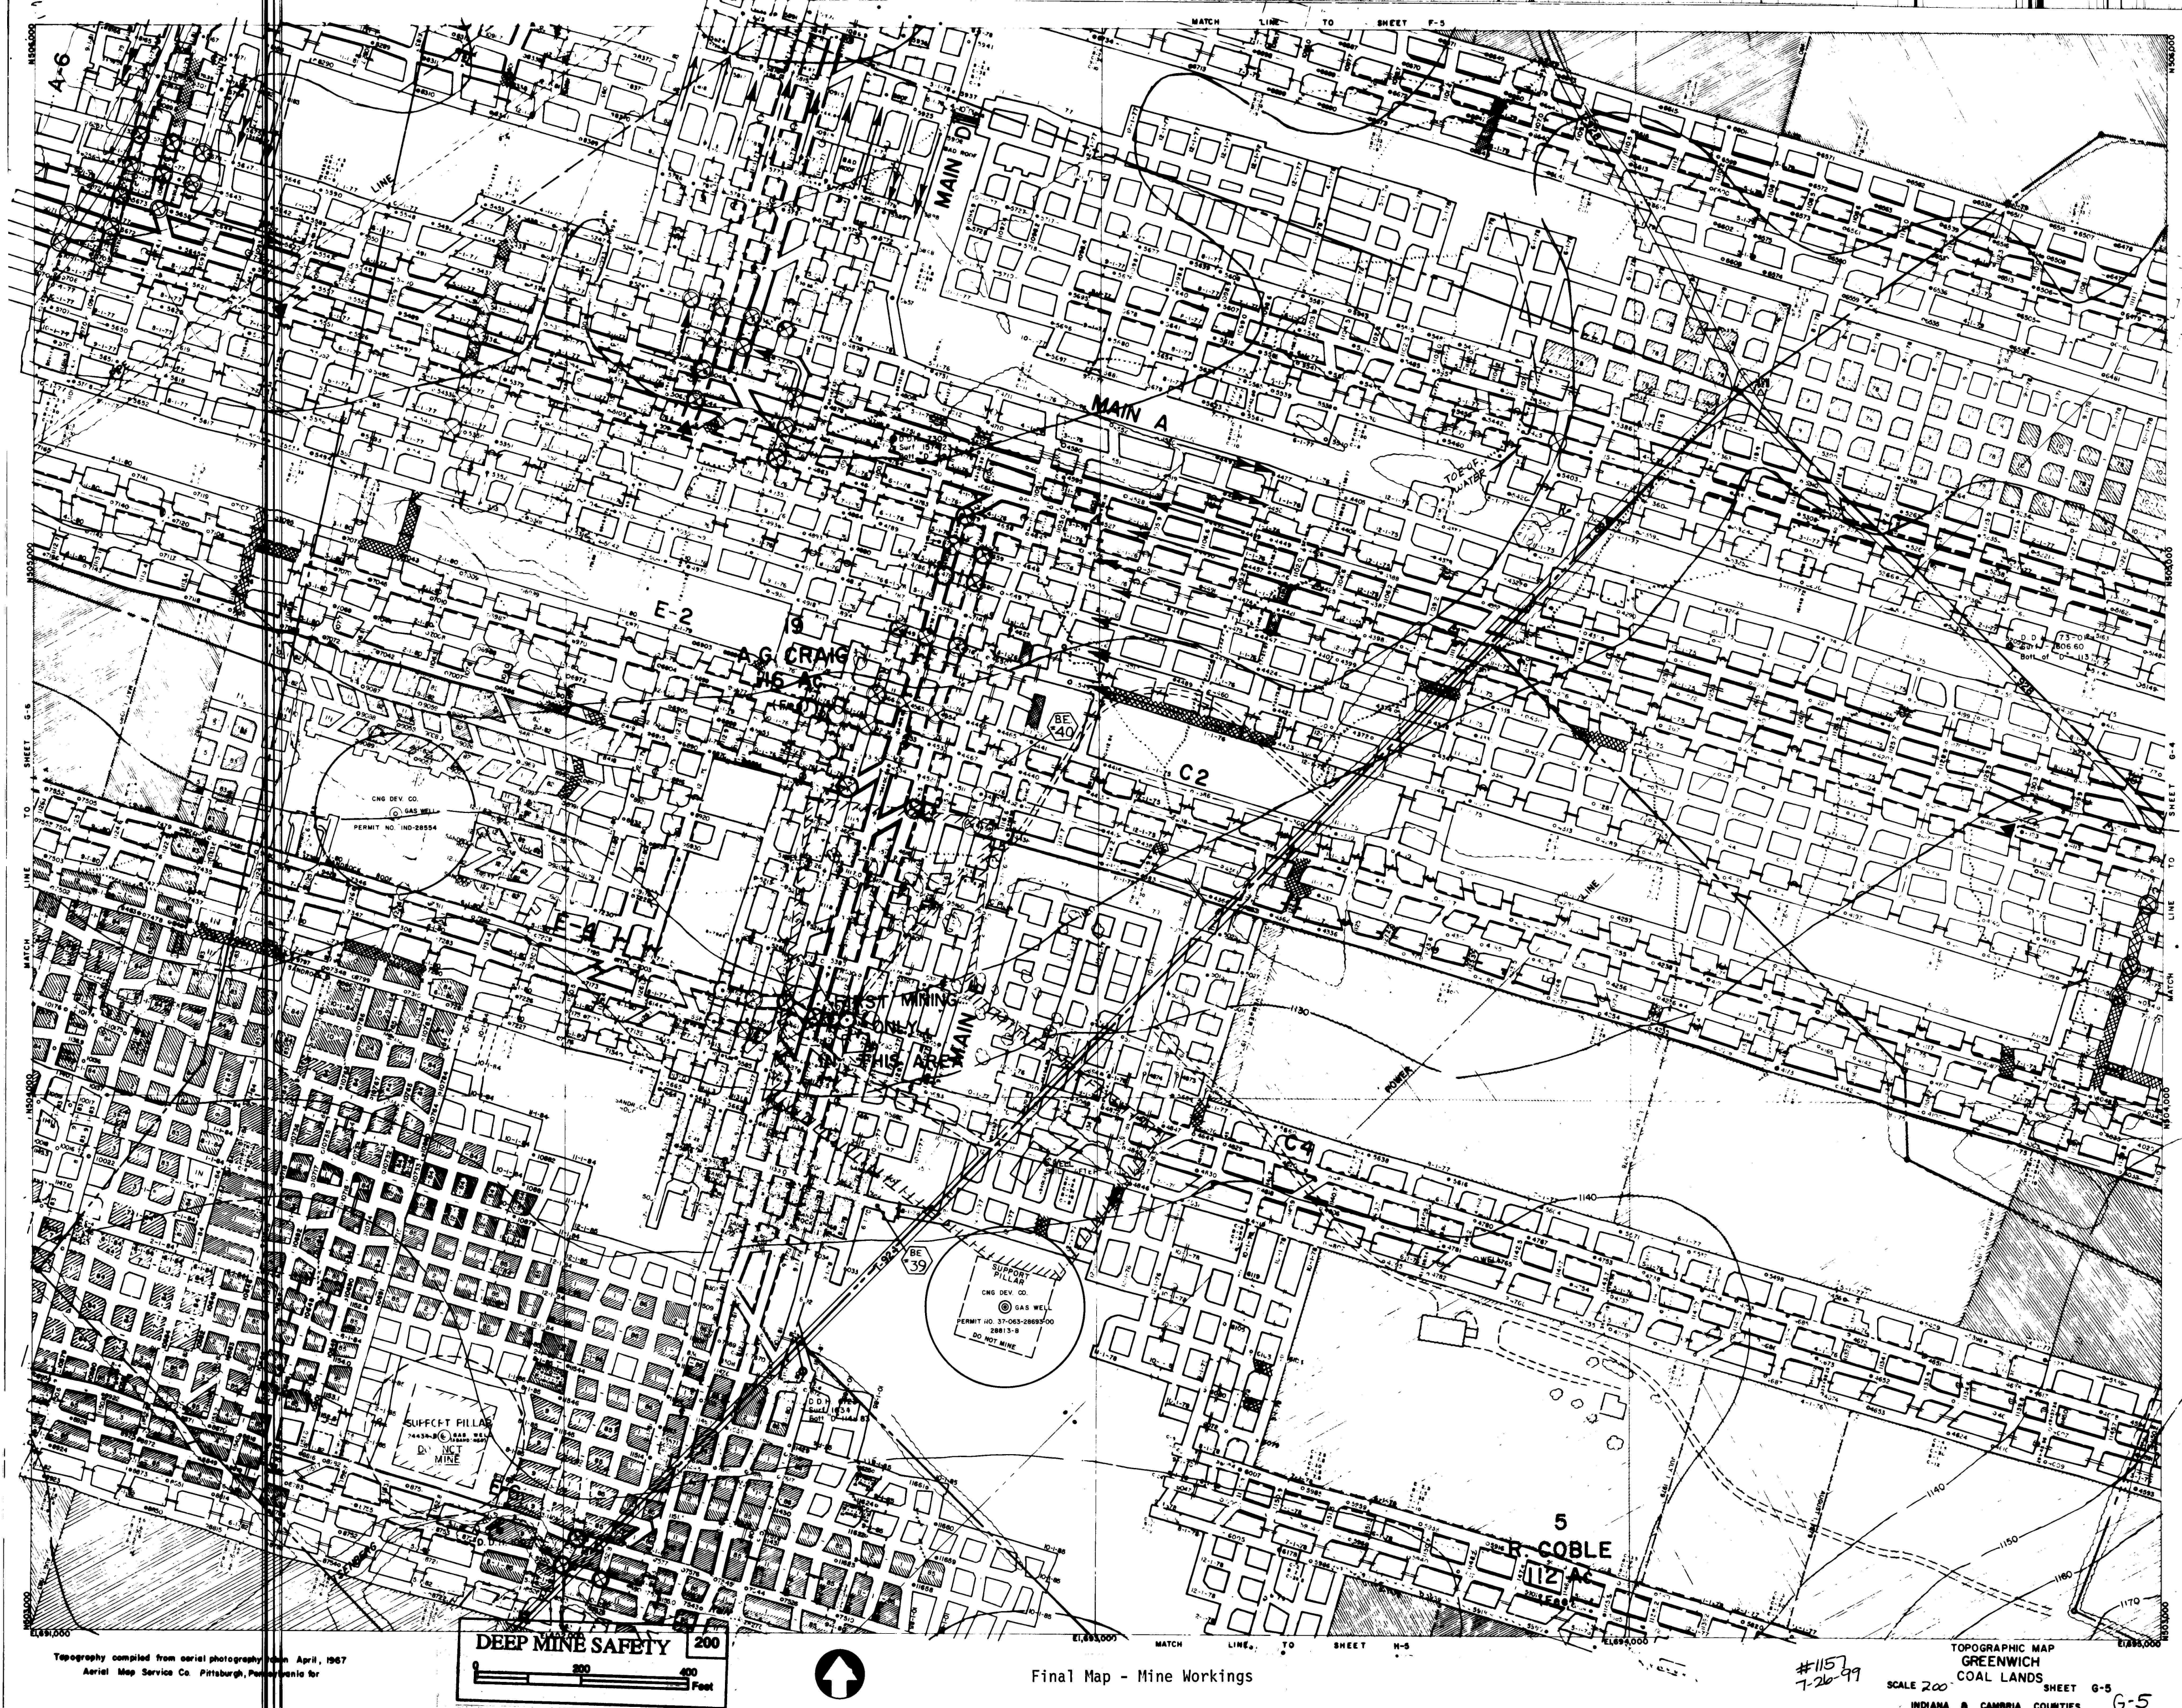

Final Map - Mine Workings

TOPOGRAPHIC MAP
GREENWICH
COAL LANDS

SCALE 200' COAL LANDS SHEET G-5
INDIANA & CAMBRIA COUNTIES (7)

G-5