


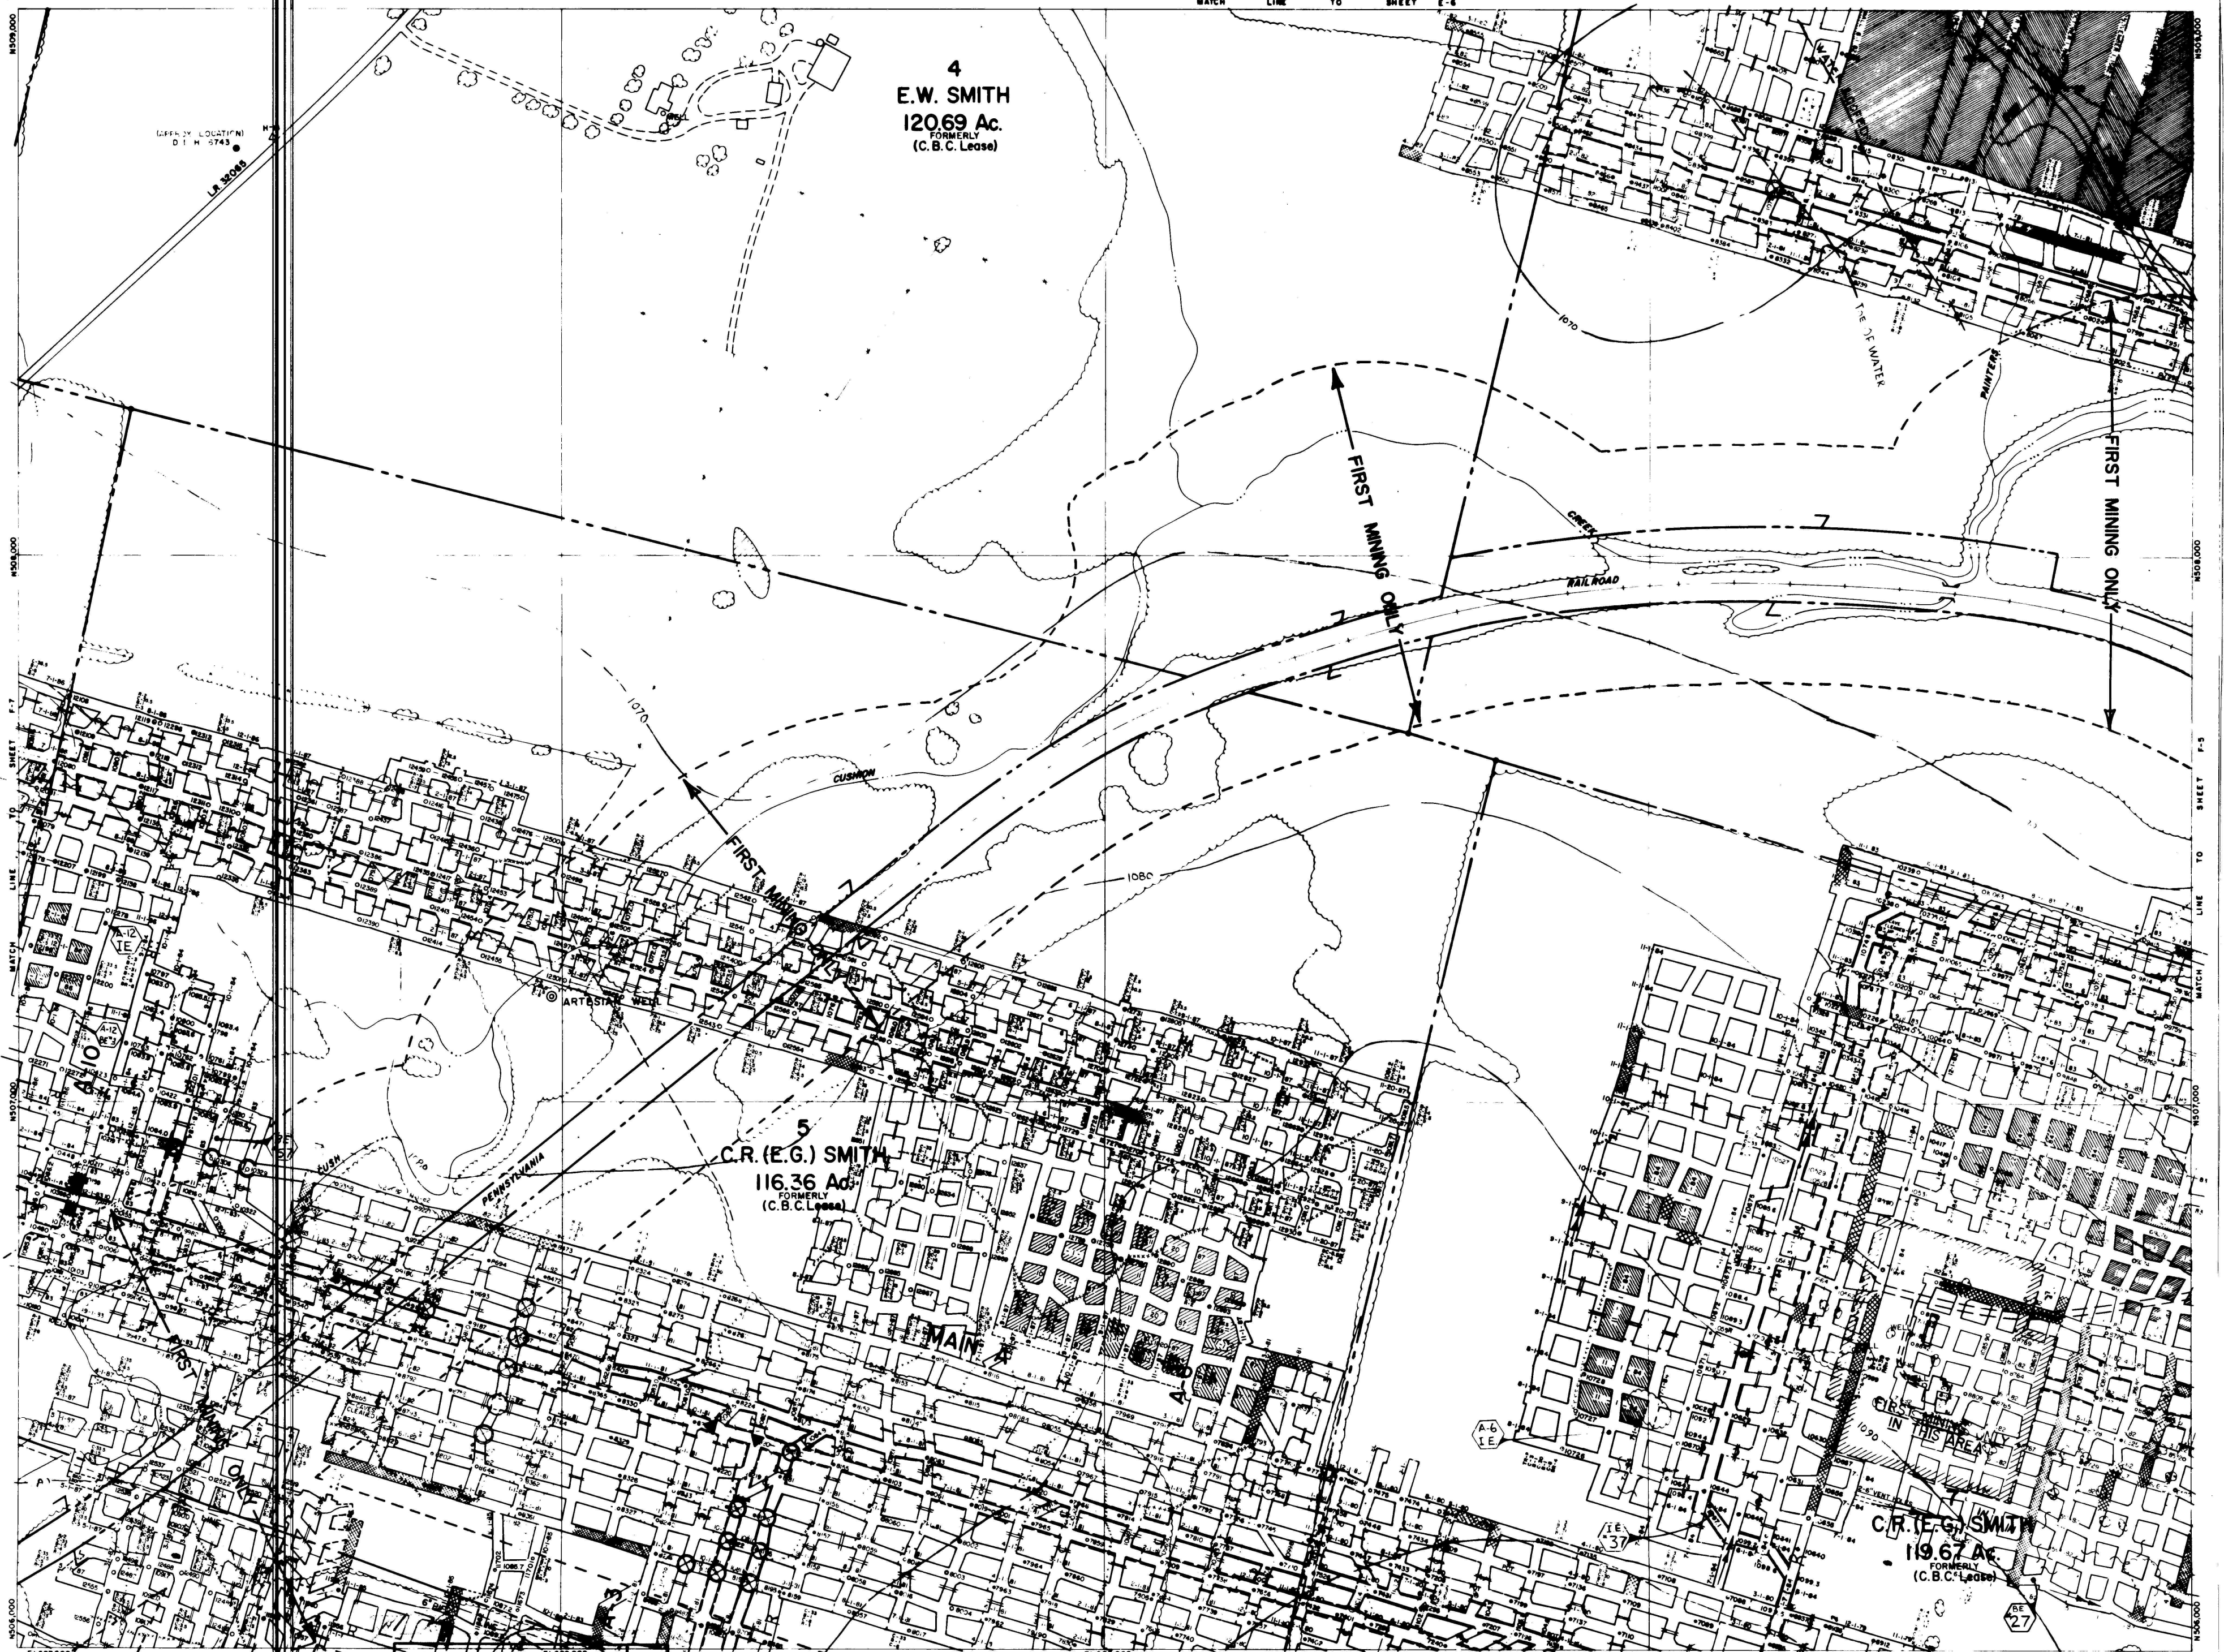

4
E.W. SMITH
120.69 Ac.
FORMERLY
(C.B.C. Lease)

5
C.R. (E.G.) SMITH
116.36 Ac.
FORMERLY
(C.B.C. Lease)

C.R. (E.G.) SMITH
119.67 Ac.
FORMERLY
(C.B.C. Lease)

Topography compiled from aerial photography taken April, 1967
Aerial Map Service Co. Pittsburgh, Pennsylvania

DEEP MINE SAFETY

200 Feet



Final Map - Mine Workings

#1157
7-26-99
SCALE 200
TOPOGRAPHIC MAP
GREENWICH
COAL LANDS
SHEET F-6
INDIANA & CAMBRIA COUNTIES