




Topography compiled from aerial photography taken April, 1967
Aerial Map Service Co. Pittsburgh, Pennsylvania

DEEP MINE SAFETY

0 100 200 Feet

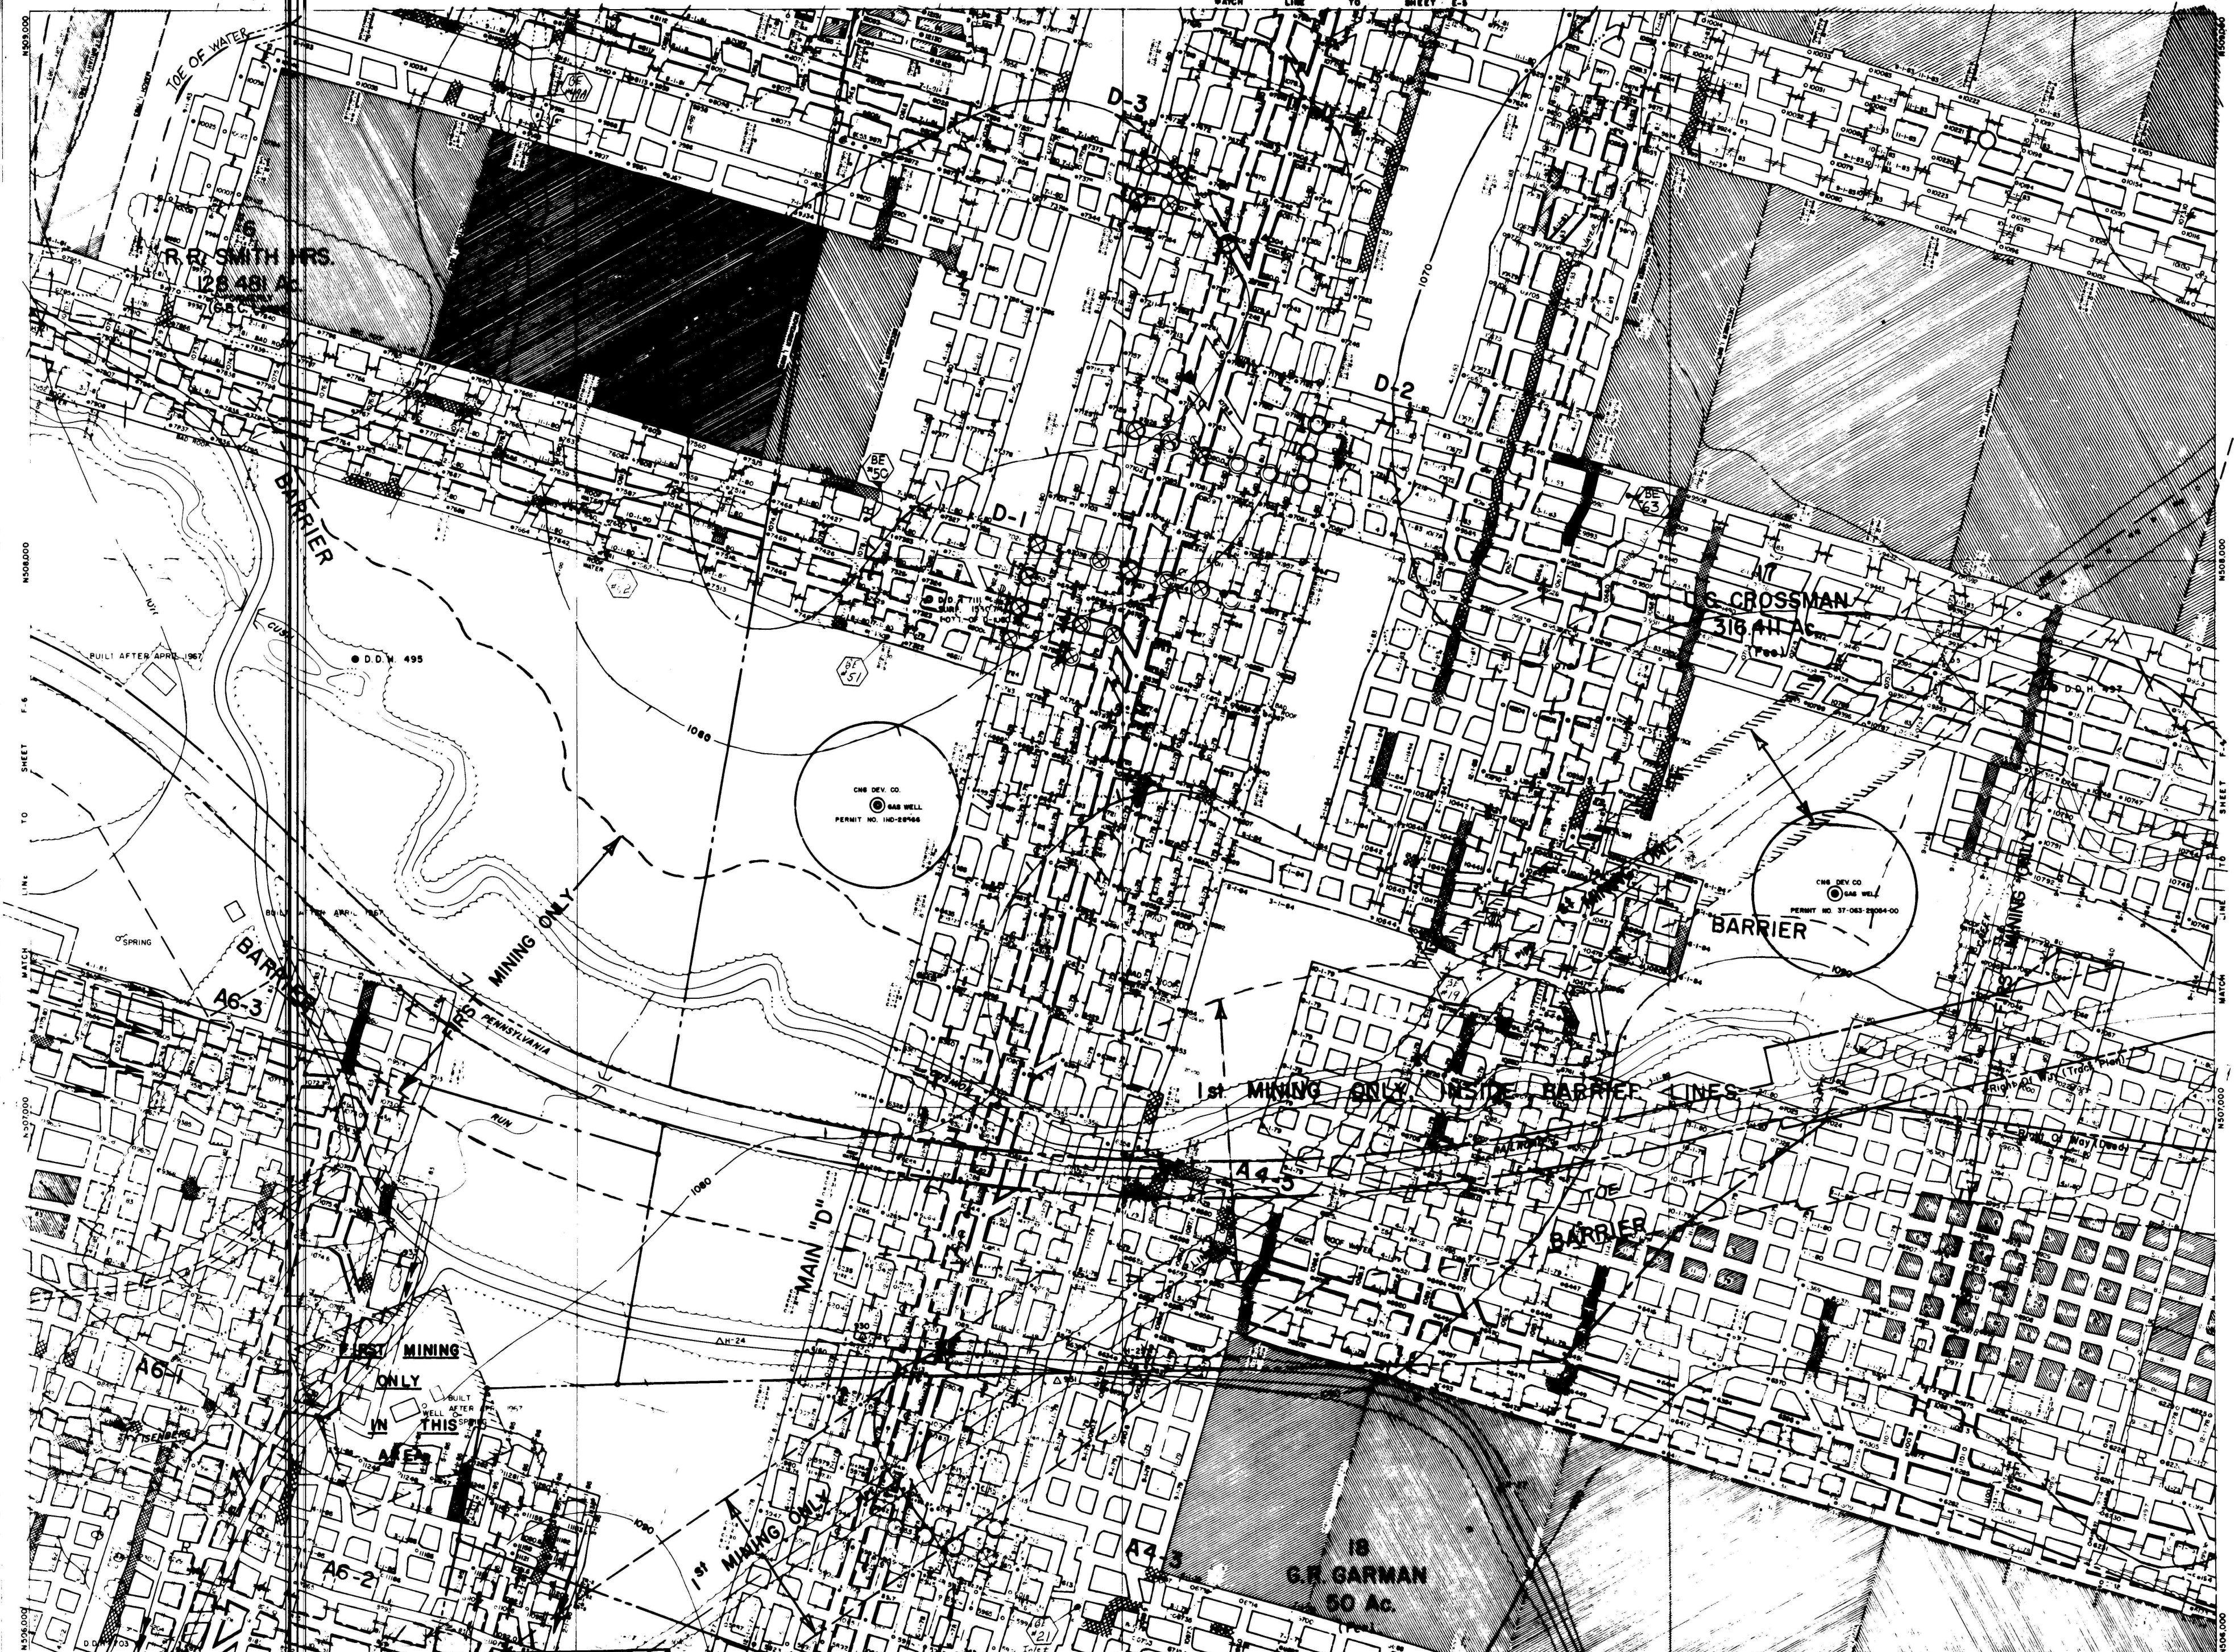

Final Map - Mine Workings

#1157
7-26-99

TOPOGRAPHIC MAP
GREENWICH
COAL LANDS
SCALE 200
INDIANA & CAMBRIA COUNTIES
SHEET F-5