


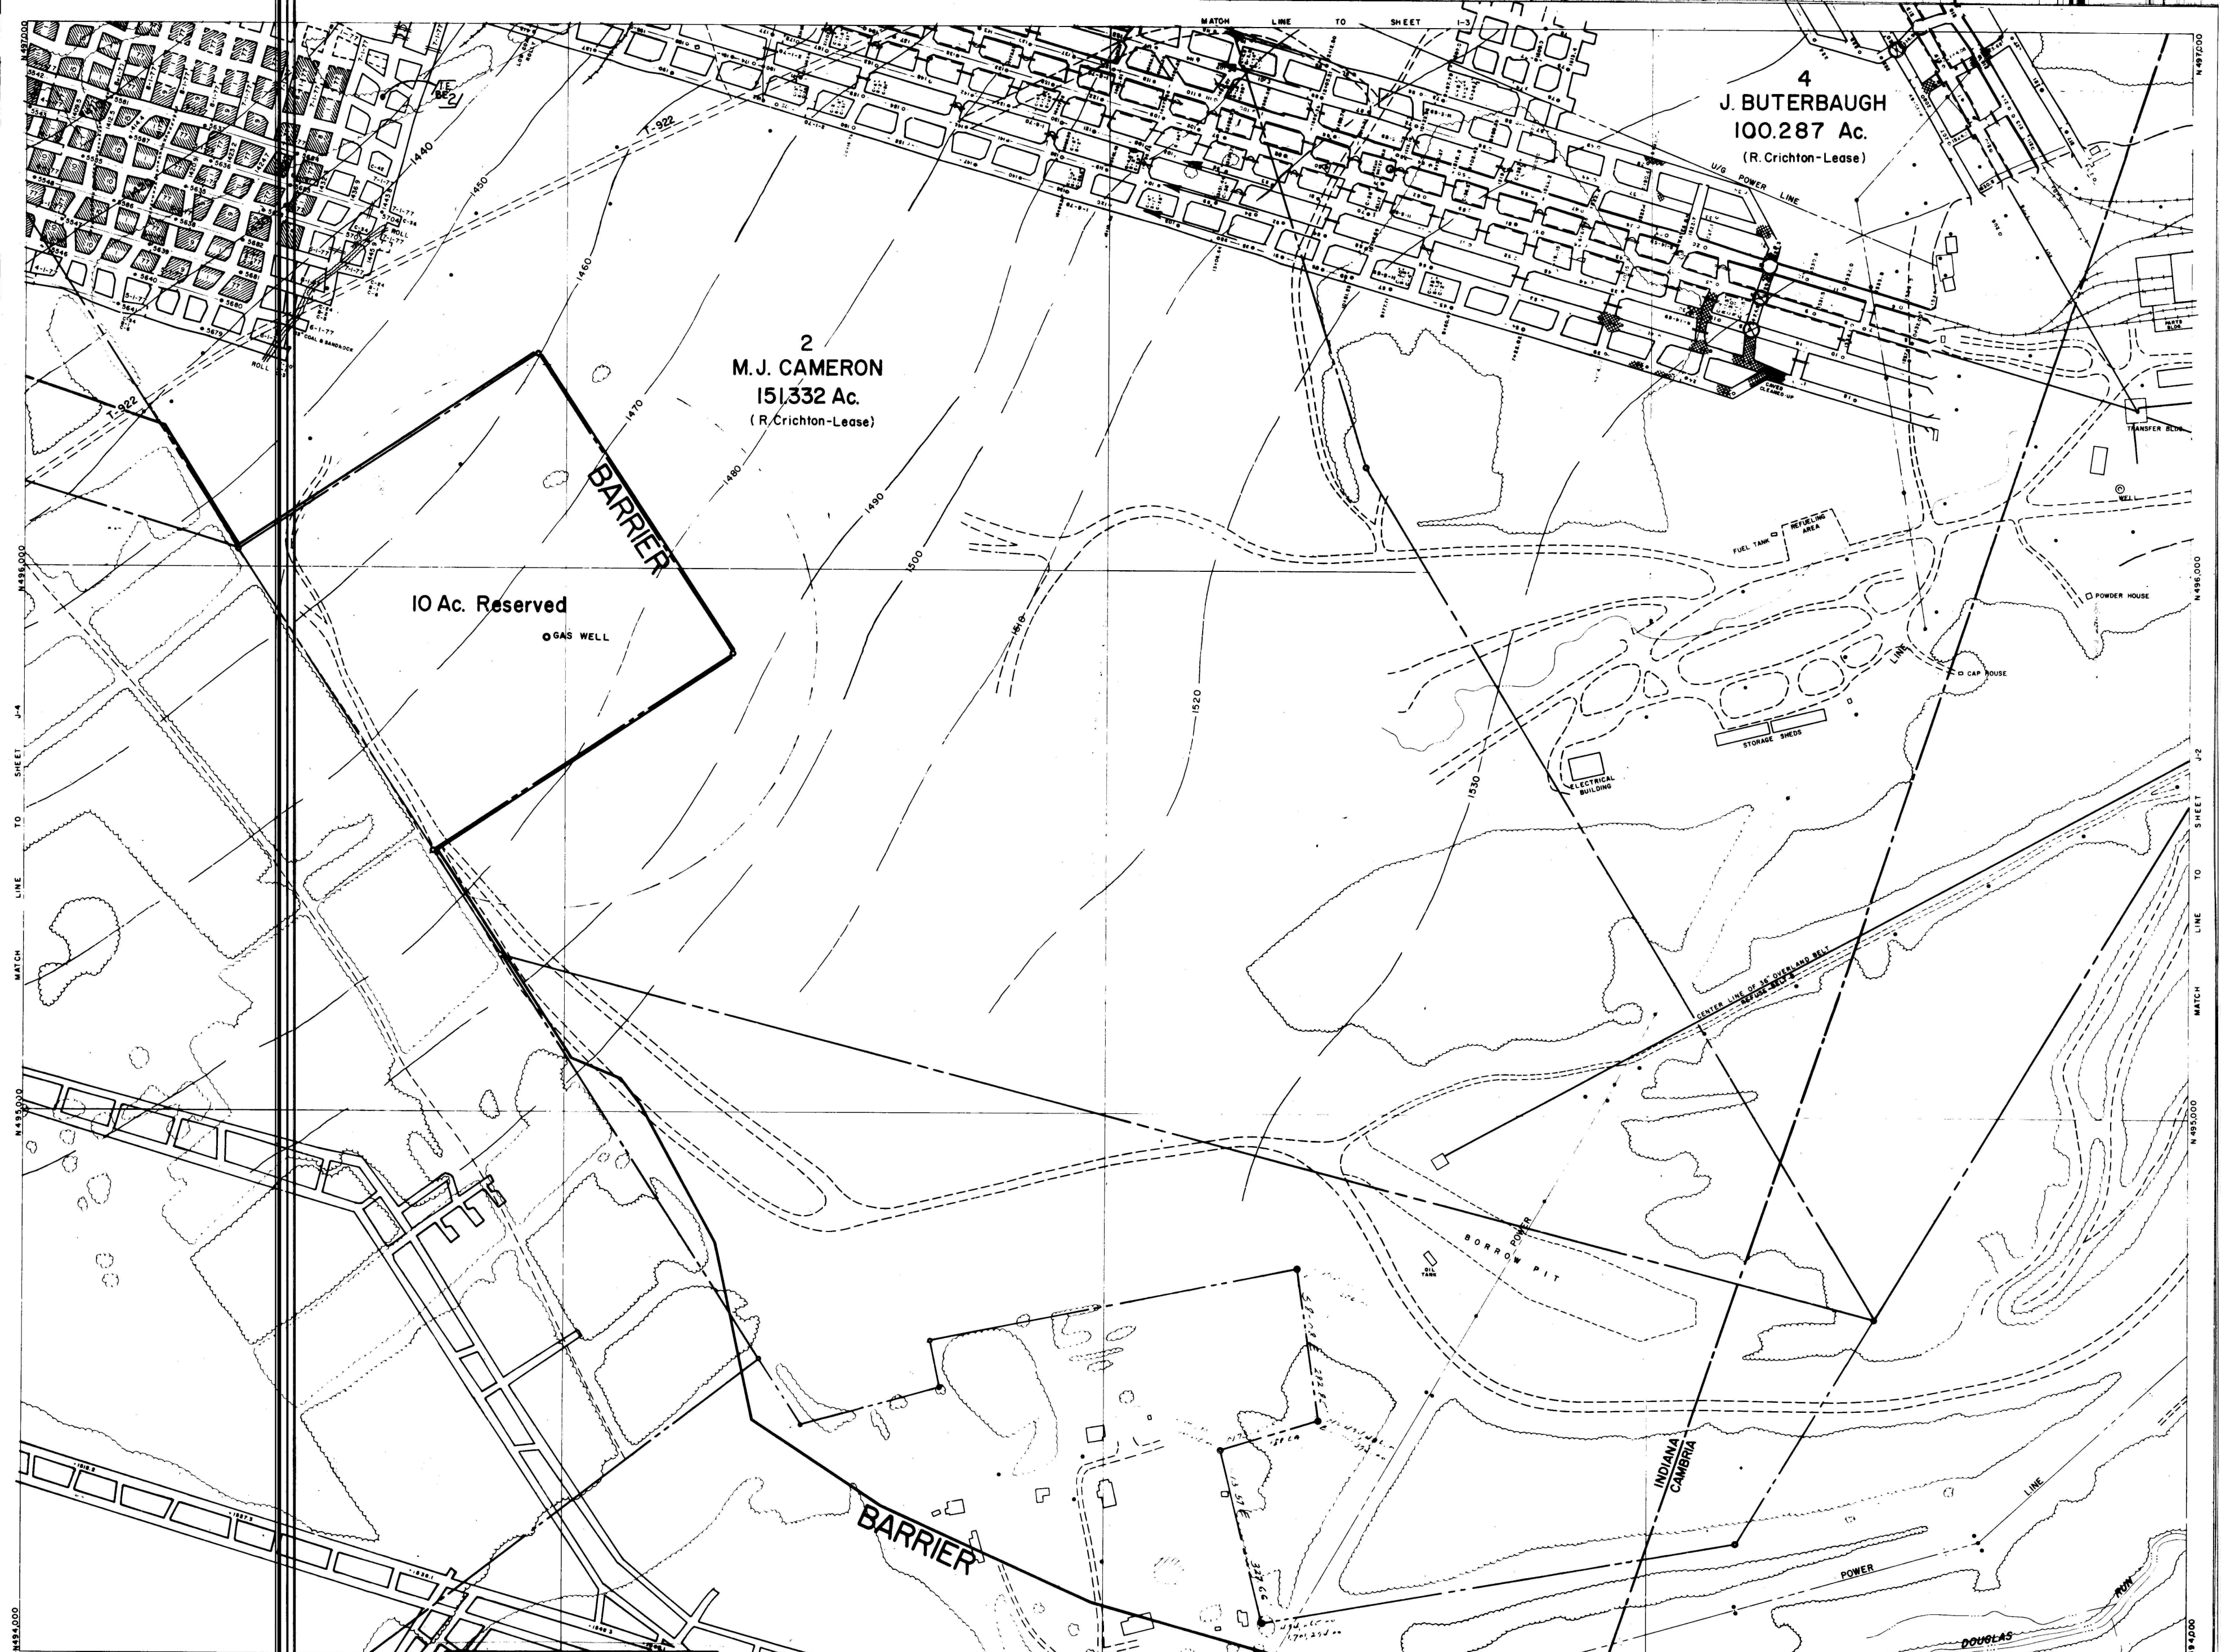

4
J. BUTERBAUGH
100.287 Ac.
(R. Crichton-Lease)

2
M.J. CAMERON
151,332 Ac.
(R. Crichton-Lease)

10 Ac. Reserved

BARRIER

BARRIER

INDIANA
CAMBRIA

Topography compiled from aerial photography taken April, 1967
Aerial Map Service Co. Pittsburgh, Pennsylvania for

DEEP MINE SAFETY 200
0 200 400 Feet



Final Map - Mine Workings

MAIN COMPLEX U.S.B.M. No. 36-05031

#1157
7-26-99

GREENWICH COLLIERIES CO.
MINE NO. 1 U.S.B.M. No. 36-02405-0
MINE NO. 2 U.S.B.M. No. 36-02404-0
Location GREEN TWP. INDIANA CO., PA
Address Box 367 EDENSBURG, PA. 15831

TOPOGRAPHIC MAP
GREENWICH
COAL LANDS
SCALE 200
INDIANA & CAMBRIA COUNTIES
SHEET J-3

J-3