


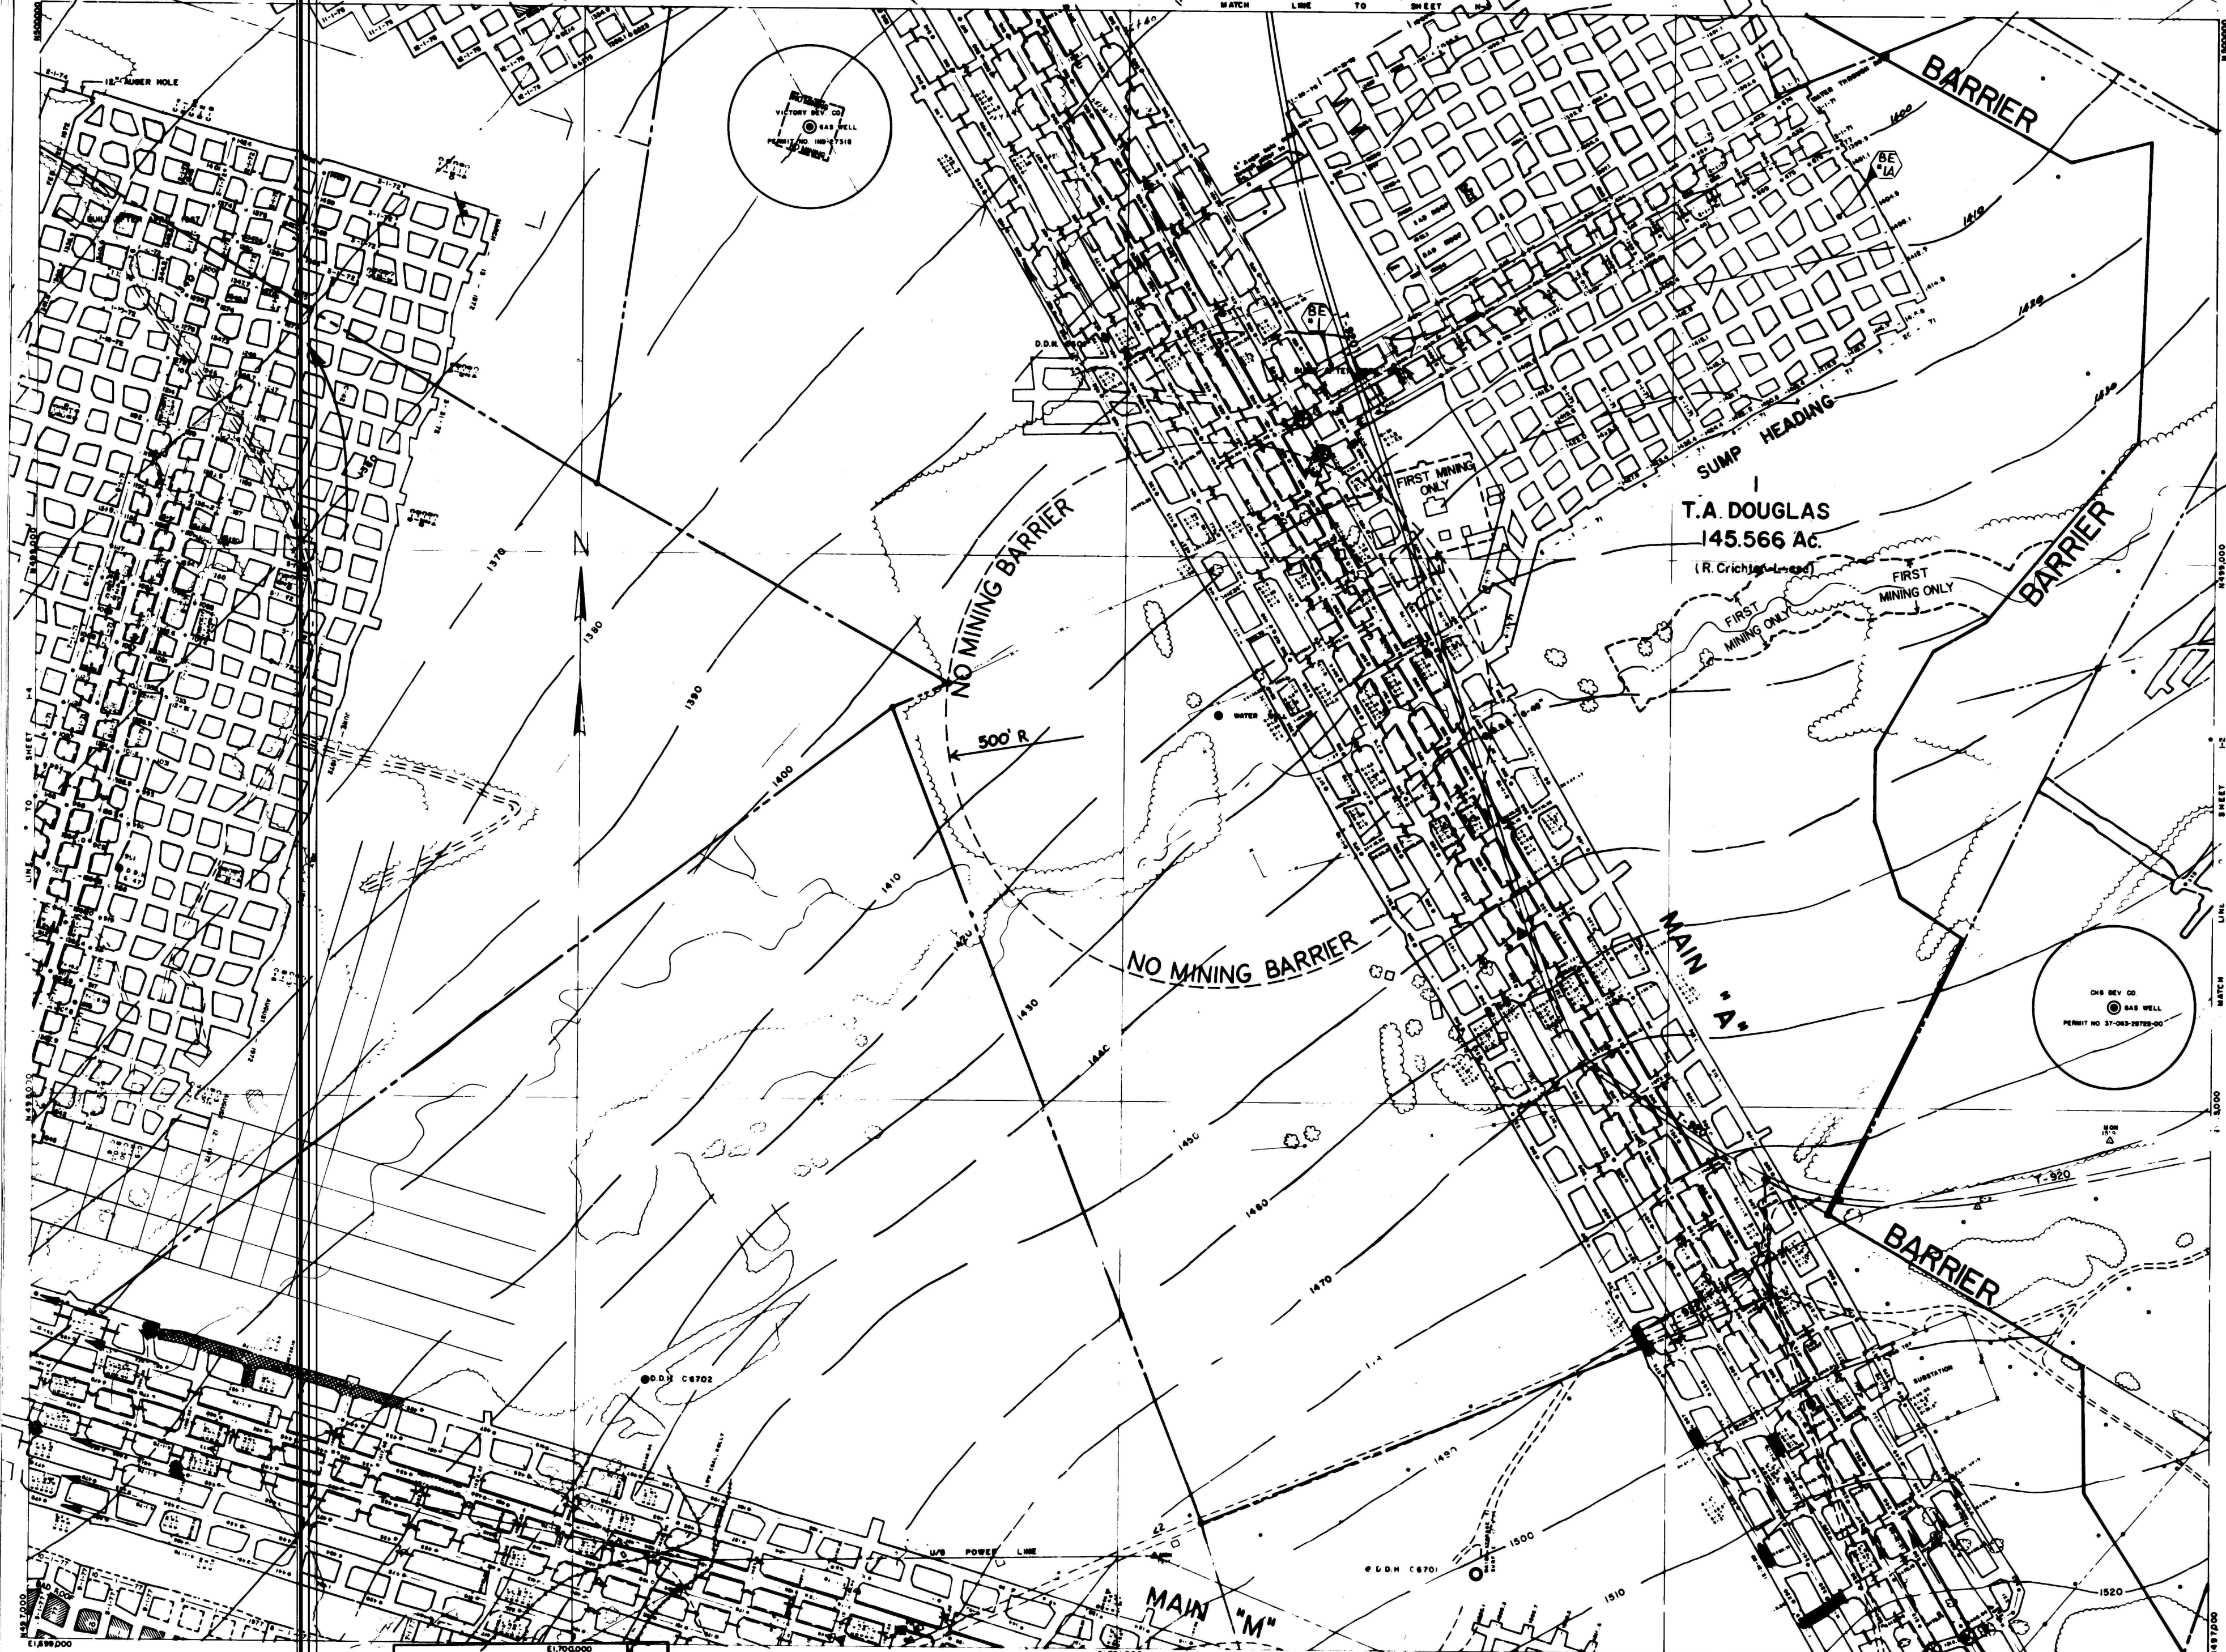

Topography compiled from aerial photography taken July, 1967  
Aerial Map Service Co. Pittsburgh, Pennsylvania

**DEEP MINE SAFETY** 200

0 200 400 Feet



Final Map - Mine Workings

#1157  
7-26-99

TOPOGRAPHIC MAP  
GREENWICH  
COAL LANDS  
SCALE 200  
SHEET 1-3  
1-3