



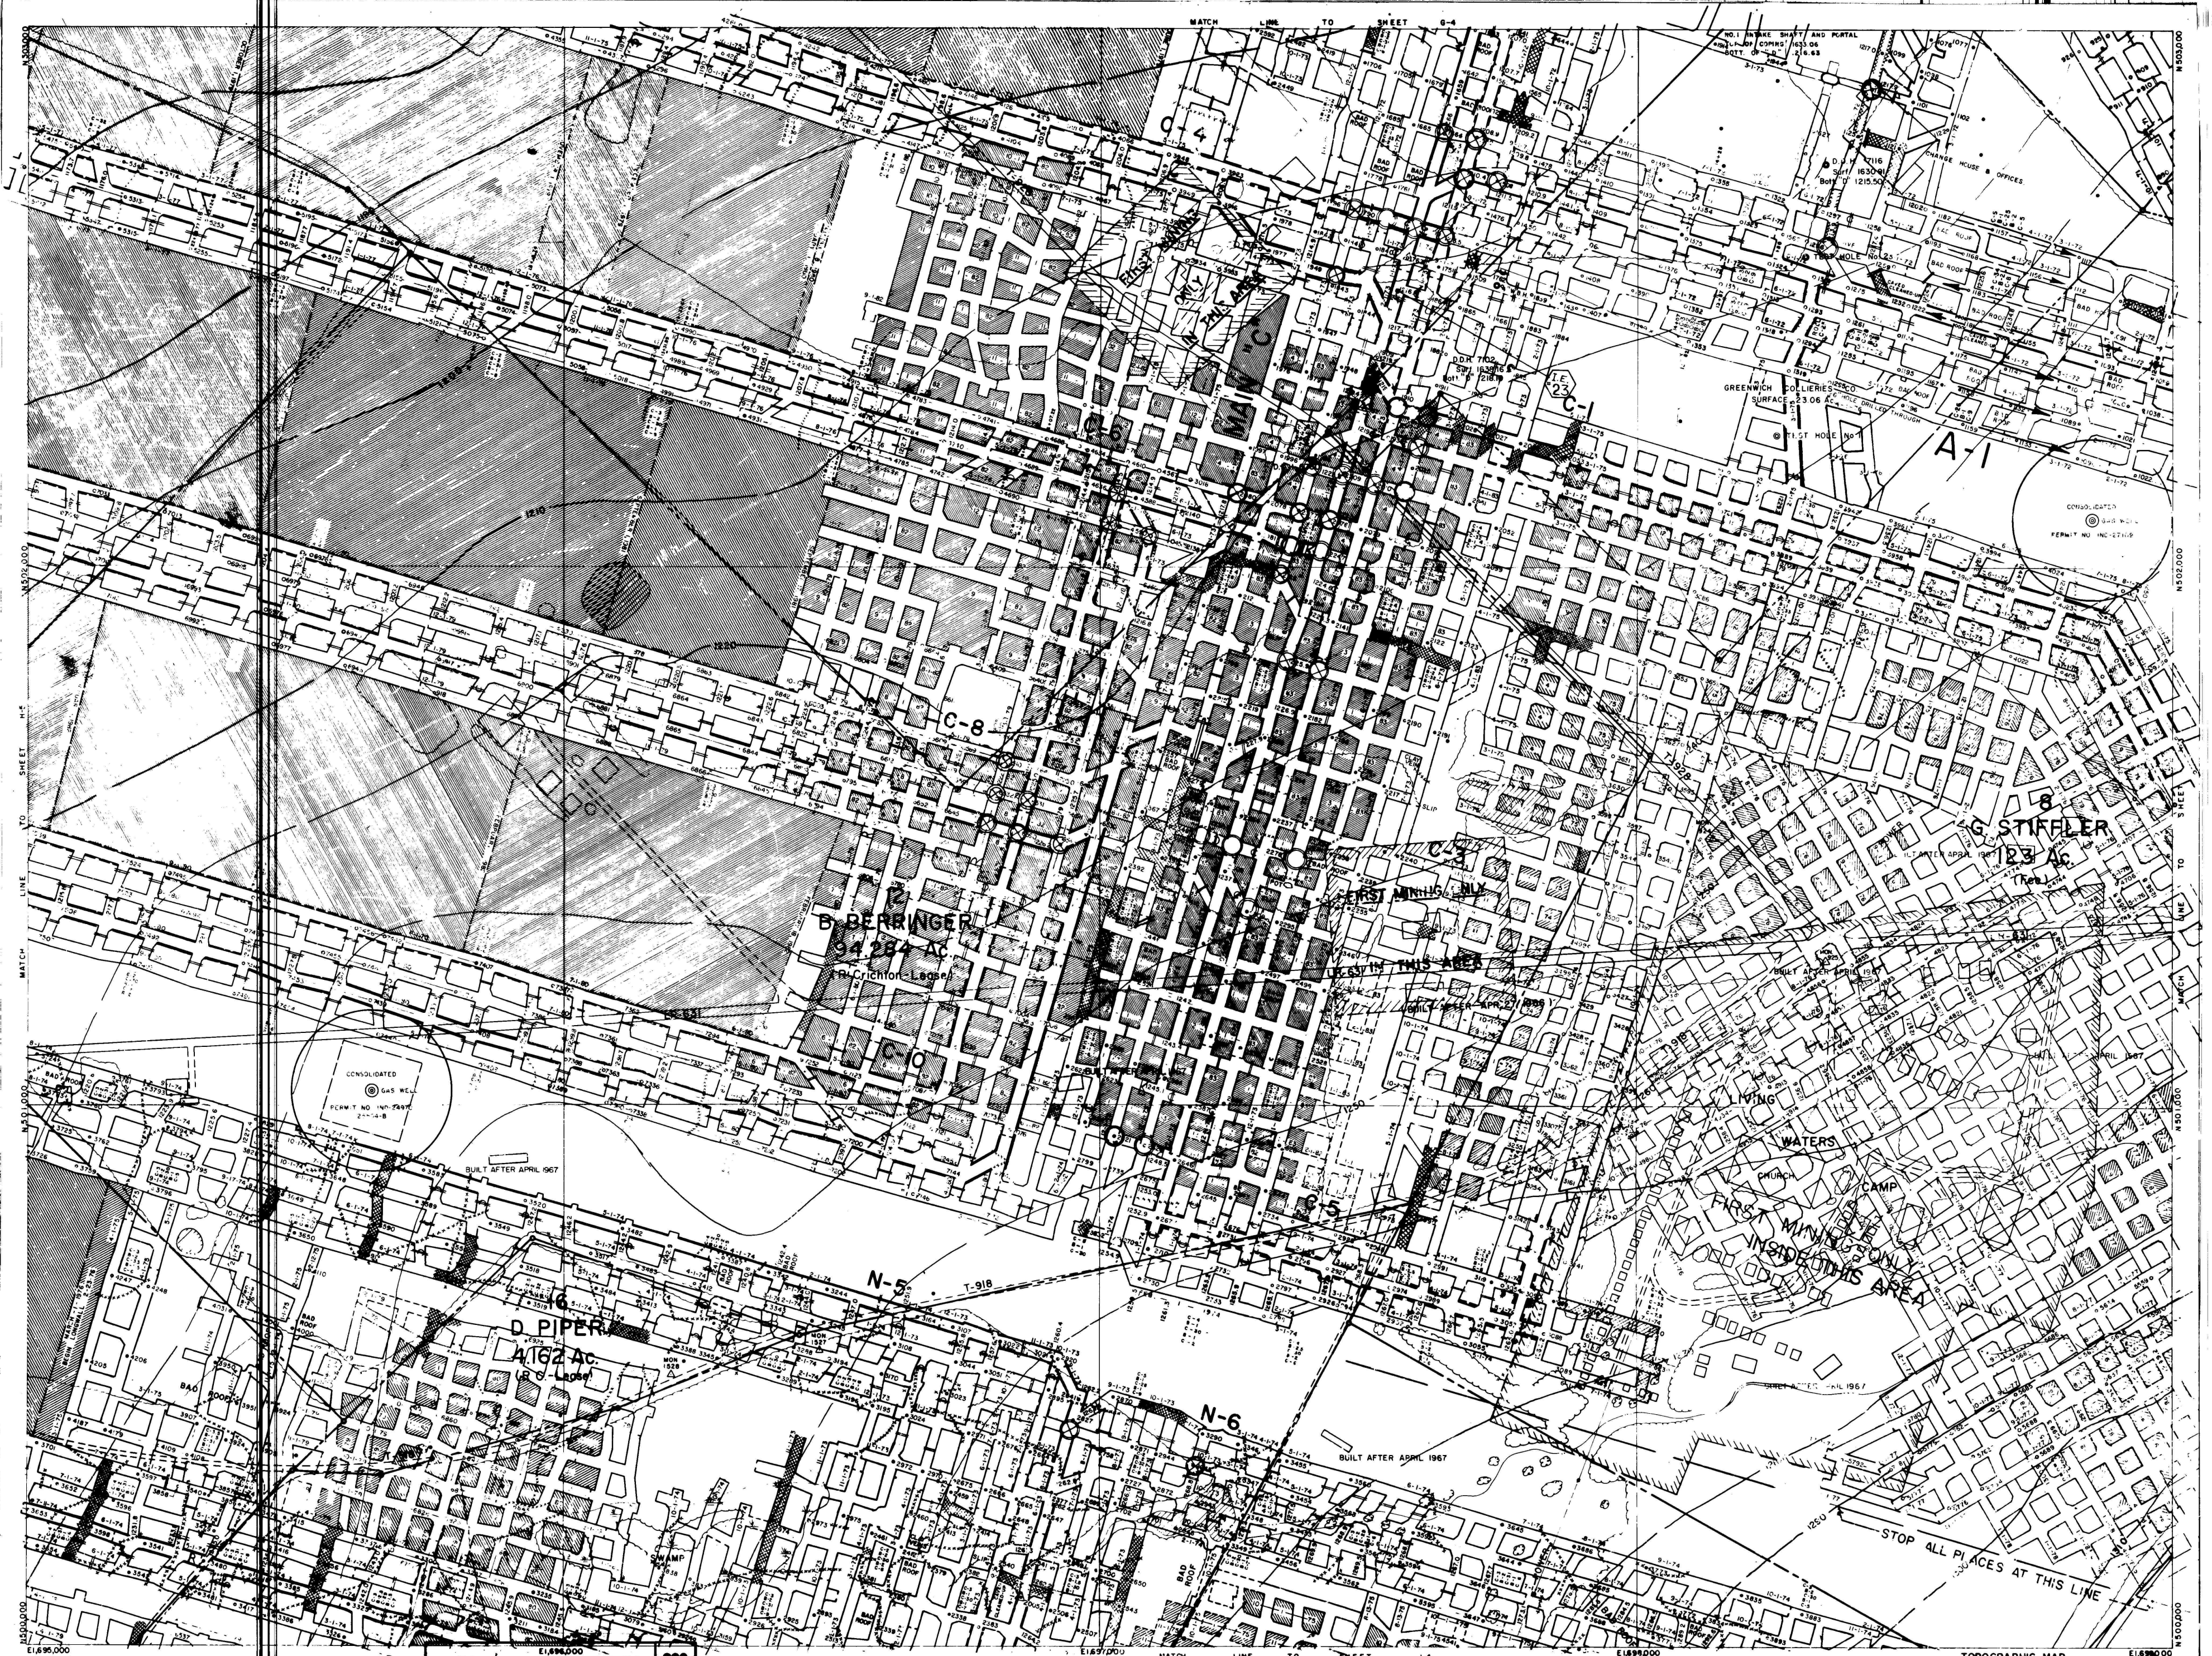

Topography compiled from aerial photography taken April, 1967
Aerial Map Service Co. Pittsburgh, Pennsylvania for

DEEP MINE SAFETY **200**

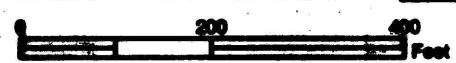

Final Map - Mine Workings

#1157
7-26-99

GREENWICH
COAL LANDS

SCALE 200

SHEET H-4

INDIANA & CAMBRIA COUNTIES

4-4