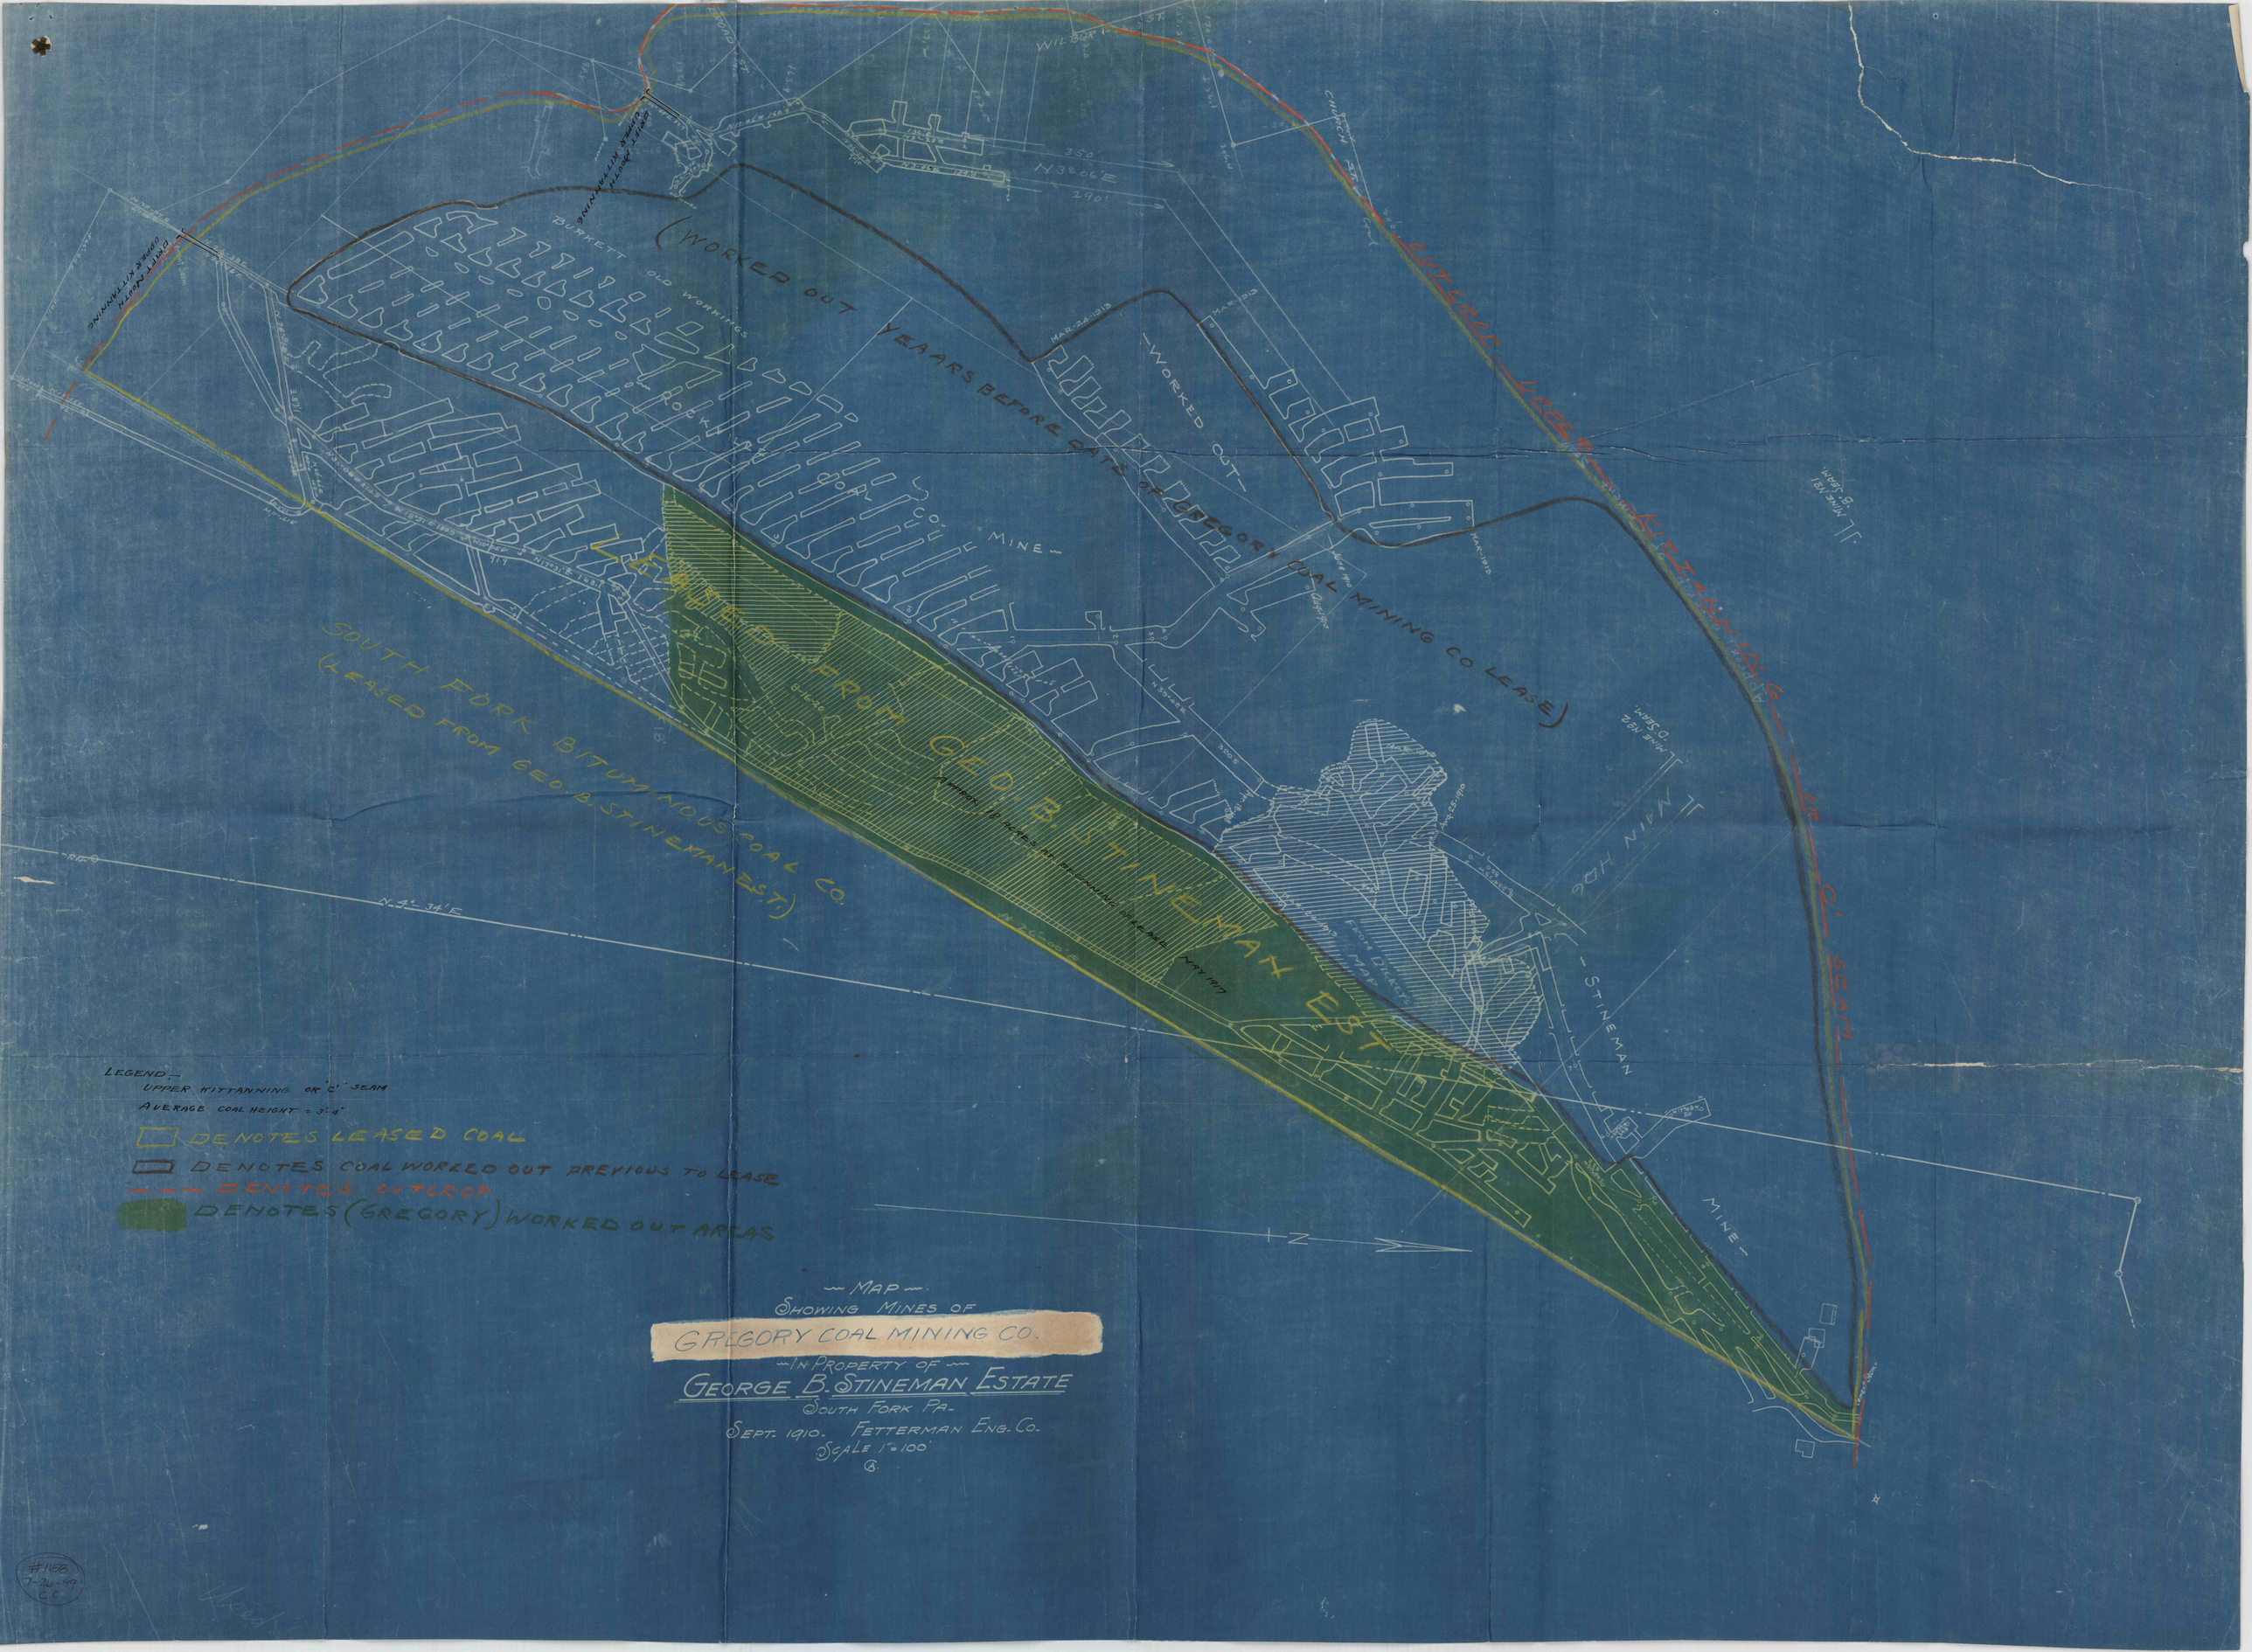
(WORKED OUT YEARS BEFORE DATE OF GREGORY COAL MINING CO LEASE)
(WORKED OUT
BURKETT OLD WORKINGS
ROOKERY
MINE
SOUTH FORK BITUMINOUS COAL CO.
(LEASED FROM GEO. B. STINEMAN EST.)
LEASED FROM GEO. B. STINEMAN EST
STINEMAN
MINE
UPPER WITTANNING
"C" SEAM
N 3° 34' E
N 39°06' E
N 39°45' E
WILBUR
CHURCH
MAR 24 1913
MAR 1913
MAR 25 1910
MAY 1917
MINE NO 1
"B" SEAM
MINE NO 2
"D" SEAM
LEGEND—
UPPER WITTANNING OR "C" SEAM
AVERAGE COAL HEIGHT = 3' 4"
DENOTES LEASED COAL
DENOTES COAL WORKED OUT PREVIOUS TO LEASE
DENOTES OUTCROP
DENOTES (GREGORY) WORKED OUT AREAS
MAP
SHOWING MINES OF
GREGORY COAL MINING CO.
IN PROPERTY OF
GEORGE B. STINEMAN ESTATE
SOUTH FORK PA.
SEPT. 1910. FETTERMAN ENG. CO.
SCALE 1" = 100'

#168
7-26-99
C.C.