#15
5-28-94
CD

8-1-5-21

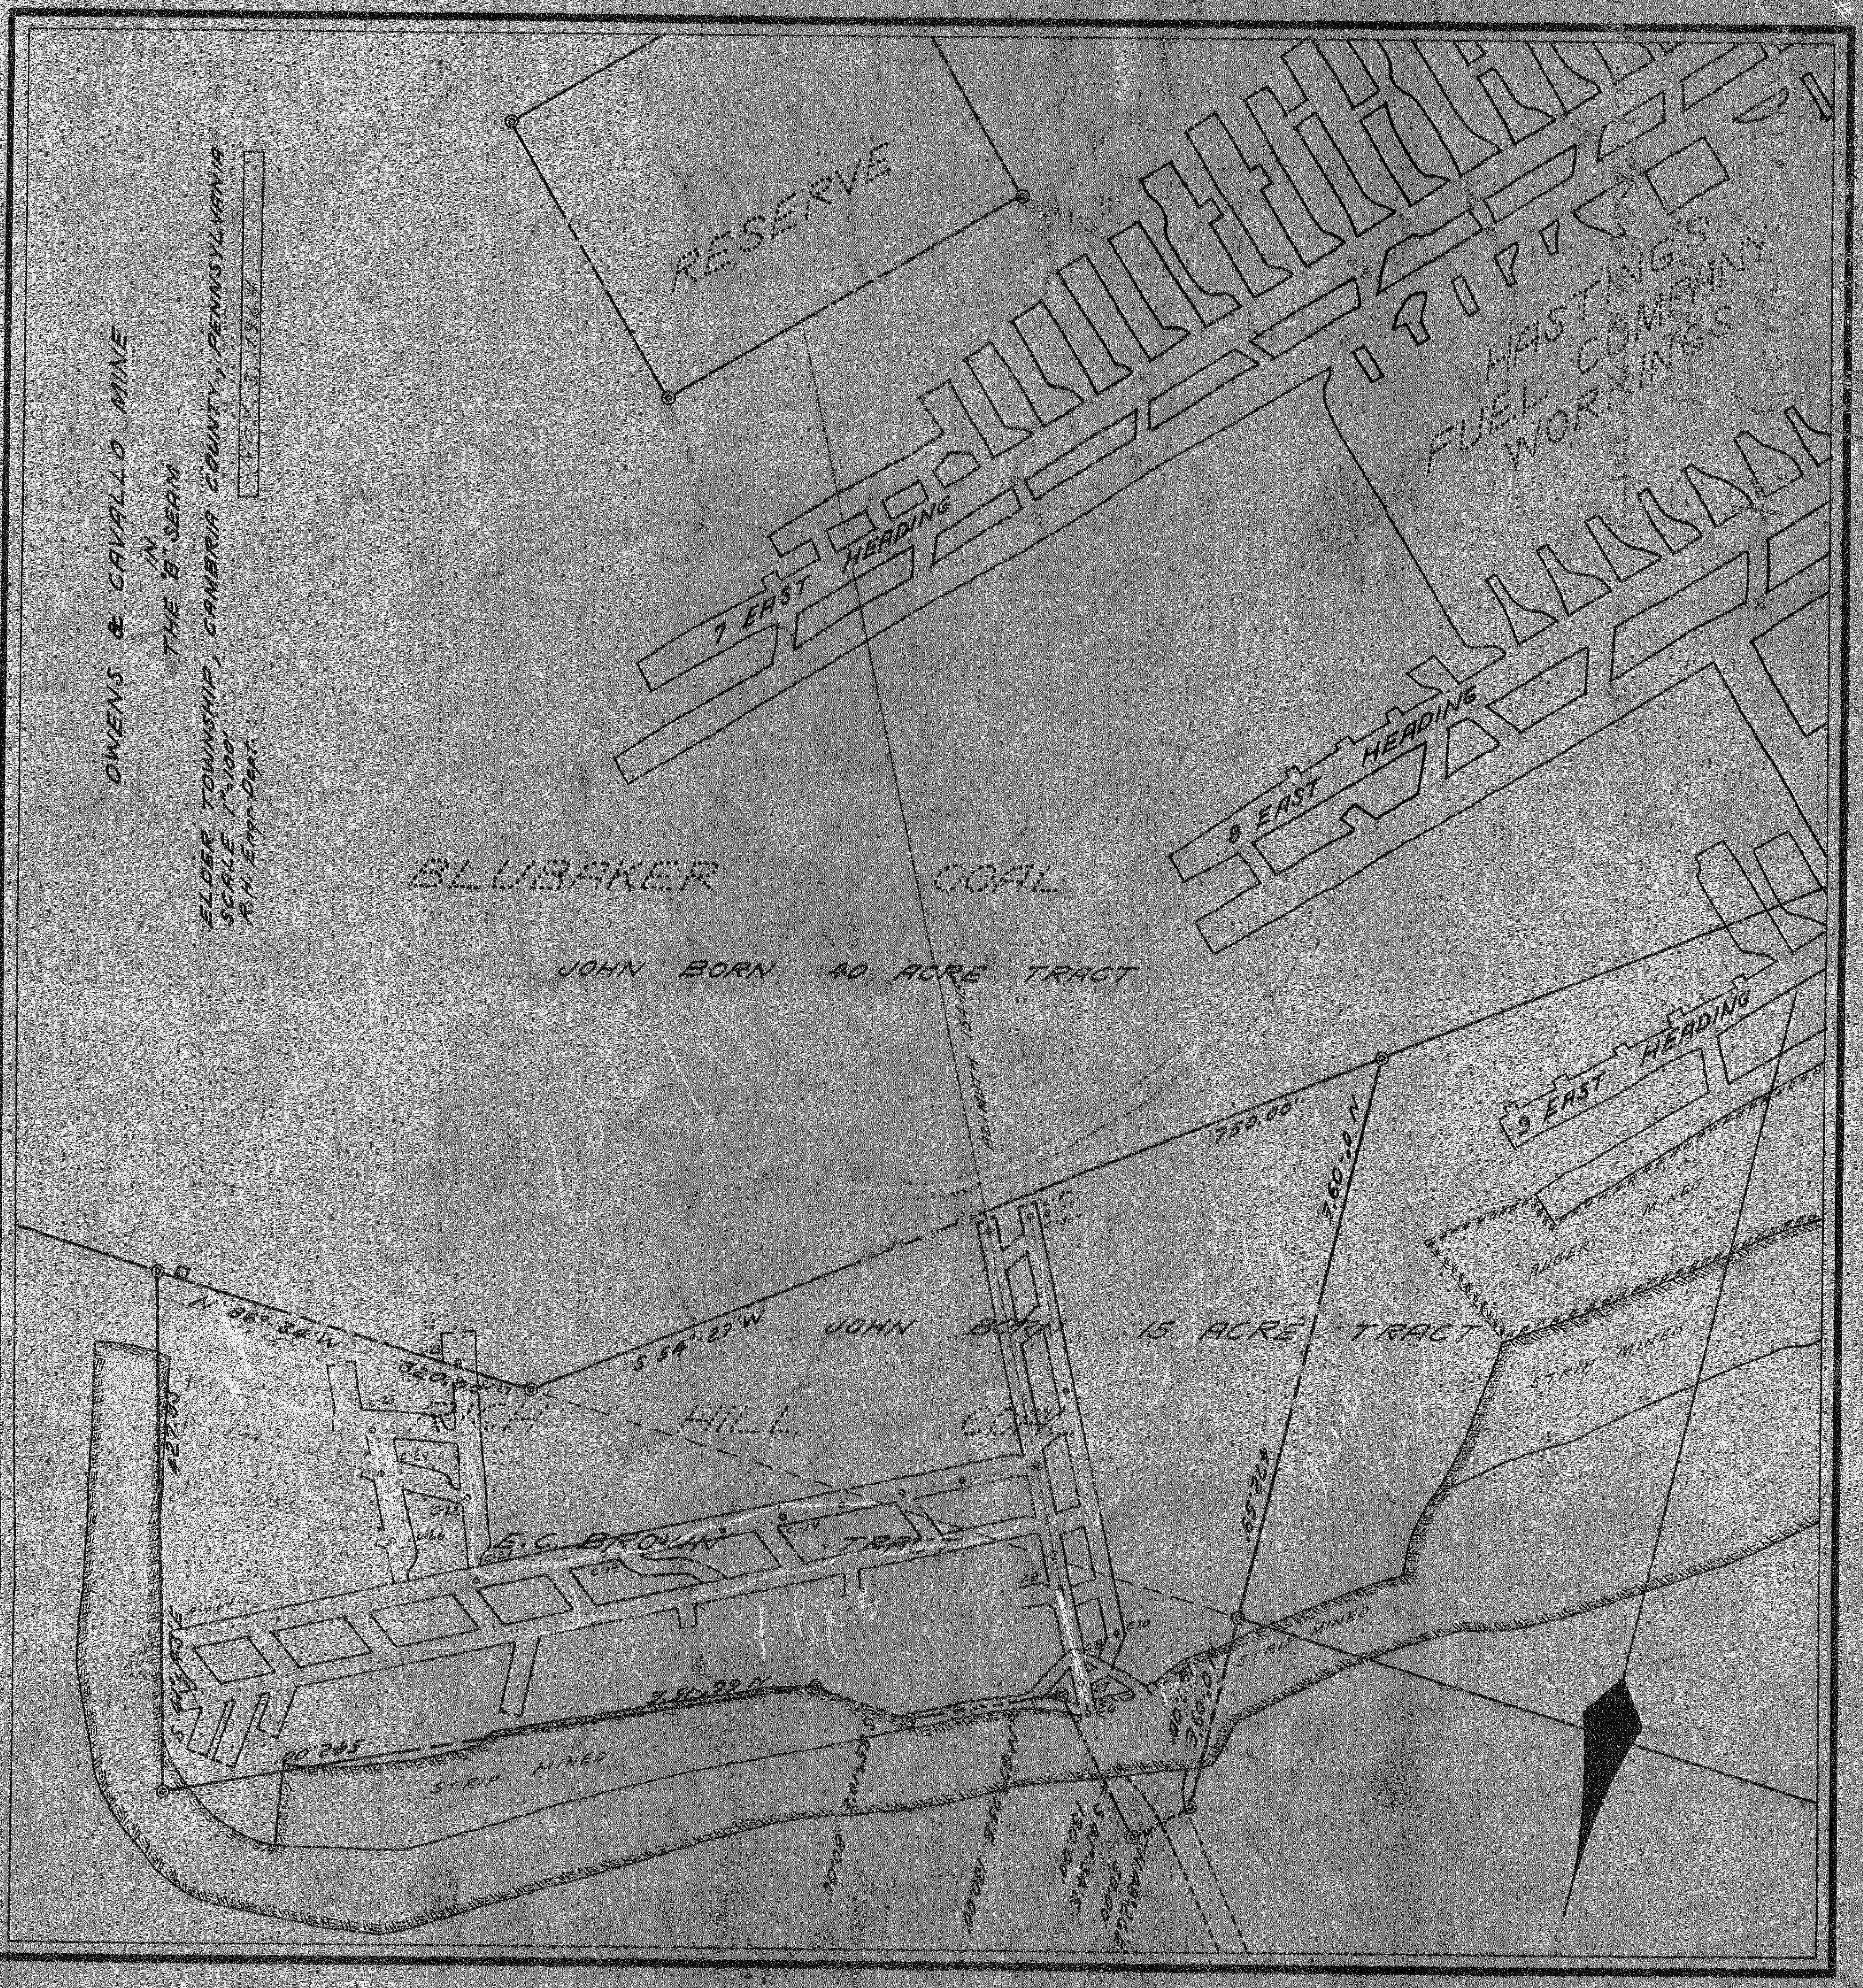

OWENS & CAVALLO MINE
IN
THE "B" SEAM

ELDER TOWNSHIP, CAMBRIA COUNTY, PENNSYLVANIA
SCALE 1"=100'
R.H. Engr. Dept.

NOV. 3, 1964