


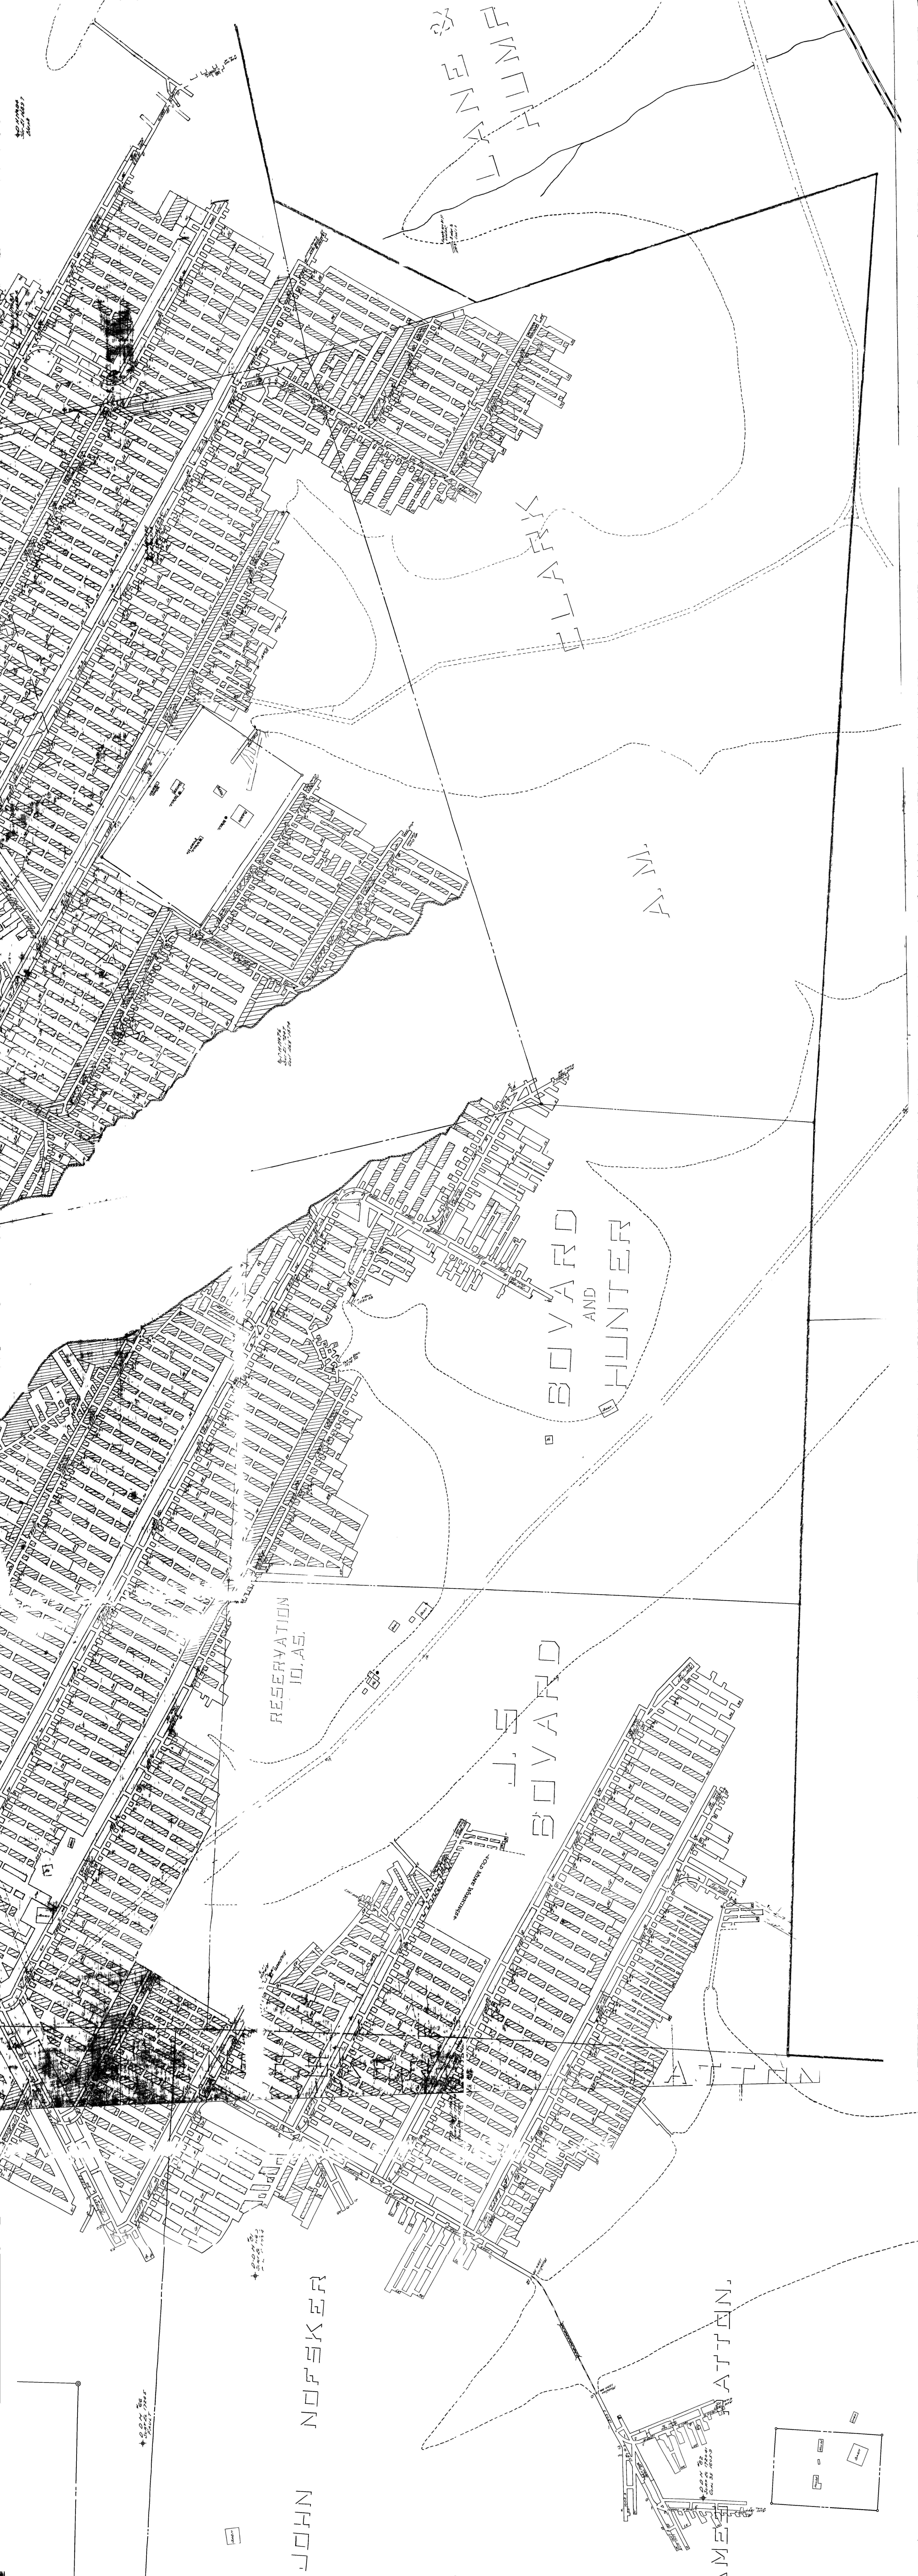




BOYARD
AND
HUNTER

RESERVATION
10.45.

BOYARD

JOHN NOFSKER

ATTEN

ATTEN

