




D.D.H. No. 277
 27'-0" SURFACE
 0'-5" DARK SANDY SHALE
 3'-11" FINE CLAY
 5'-6" LIMESTONE & FINE CLAY
 BOT.

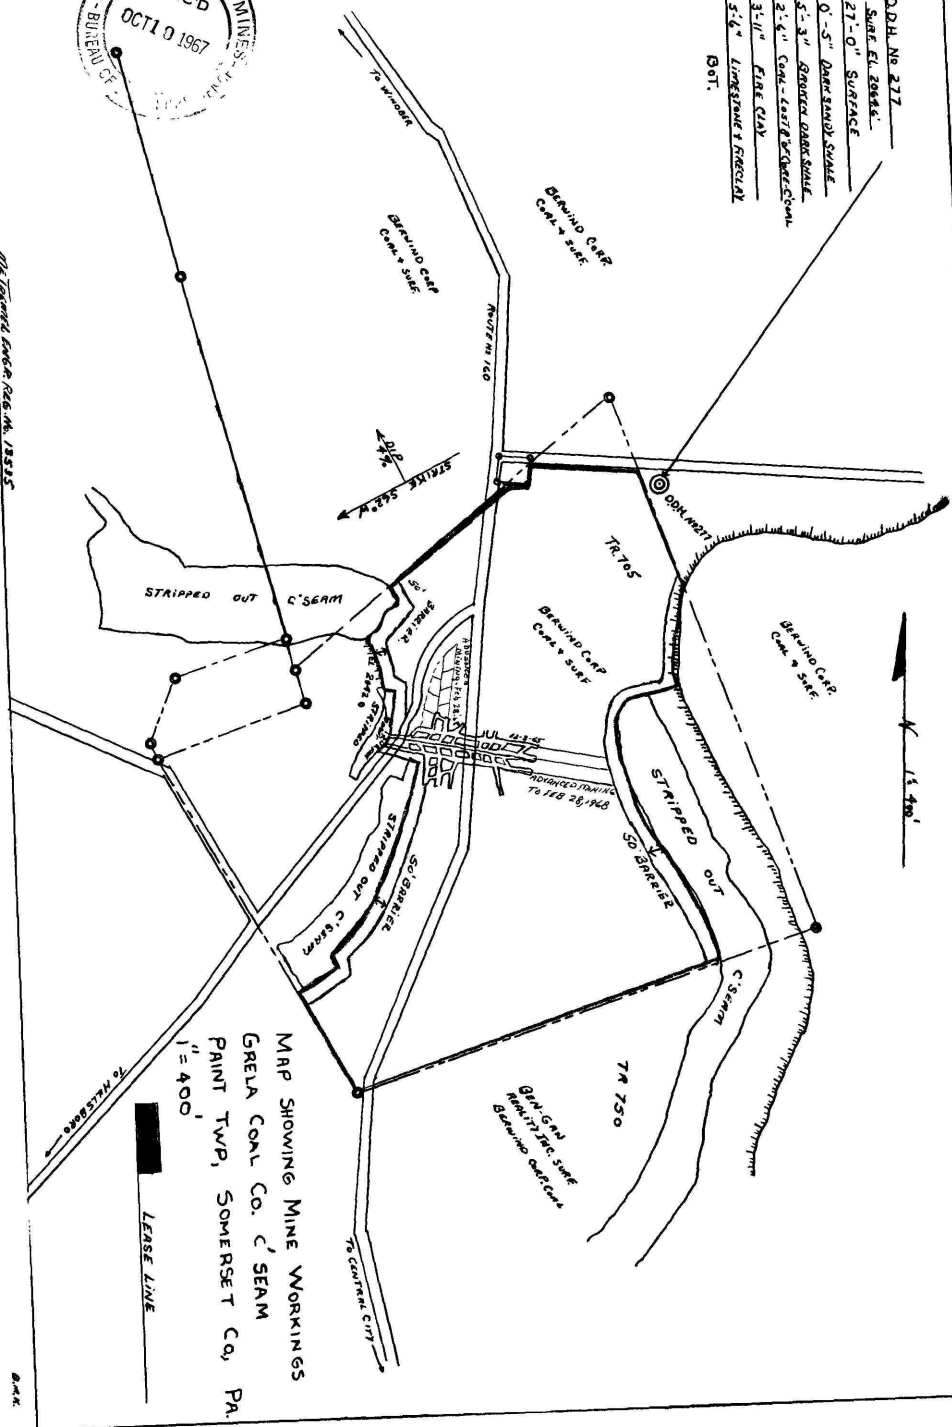

MAP SHOWING MINE WORKINGS
 GRETA COAL CO. C' SEAM
 PAINT TWP, SOMERSET CO., PA.
 1" = 400'

LEASE LINE

