


Nick Barndt

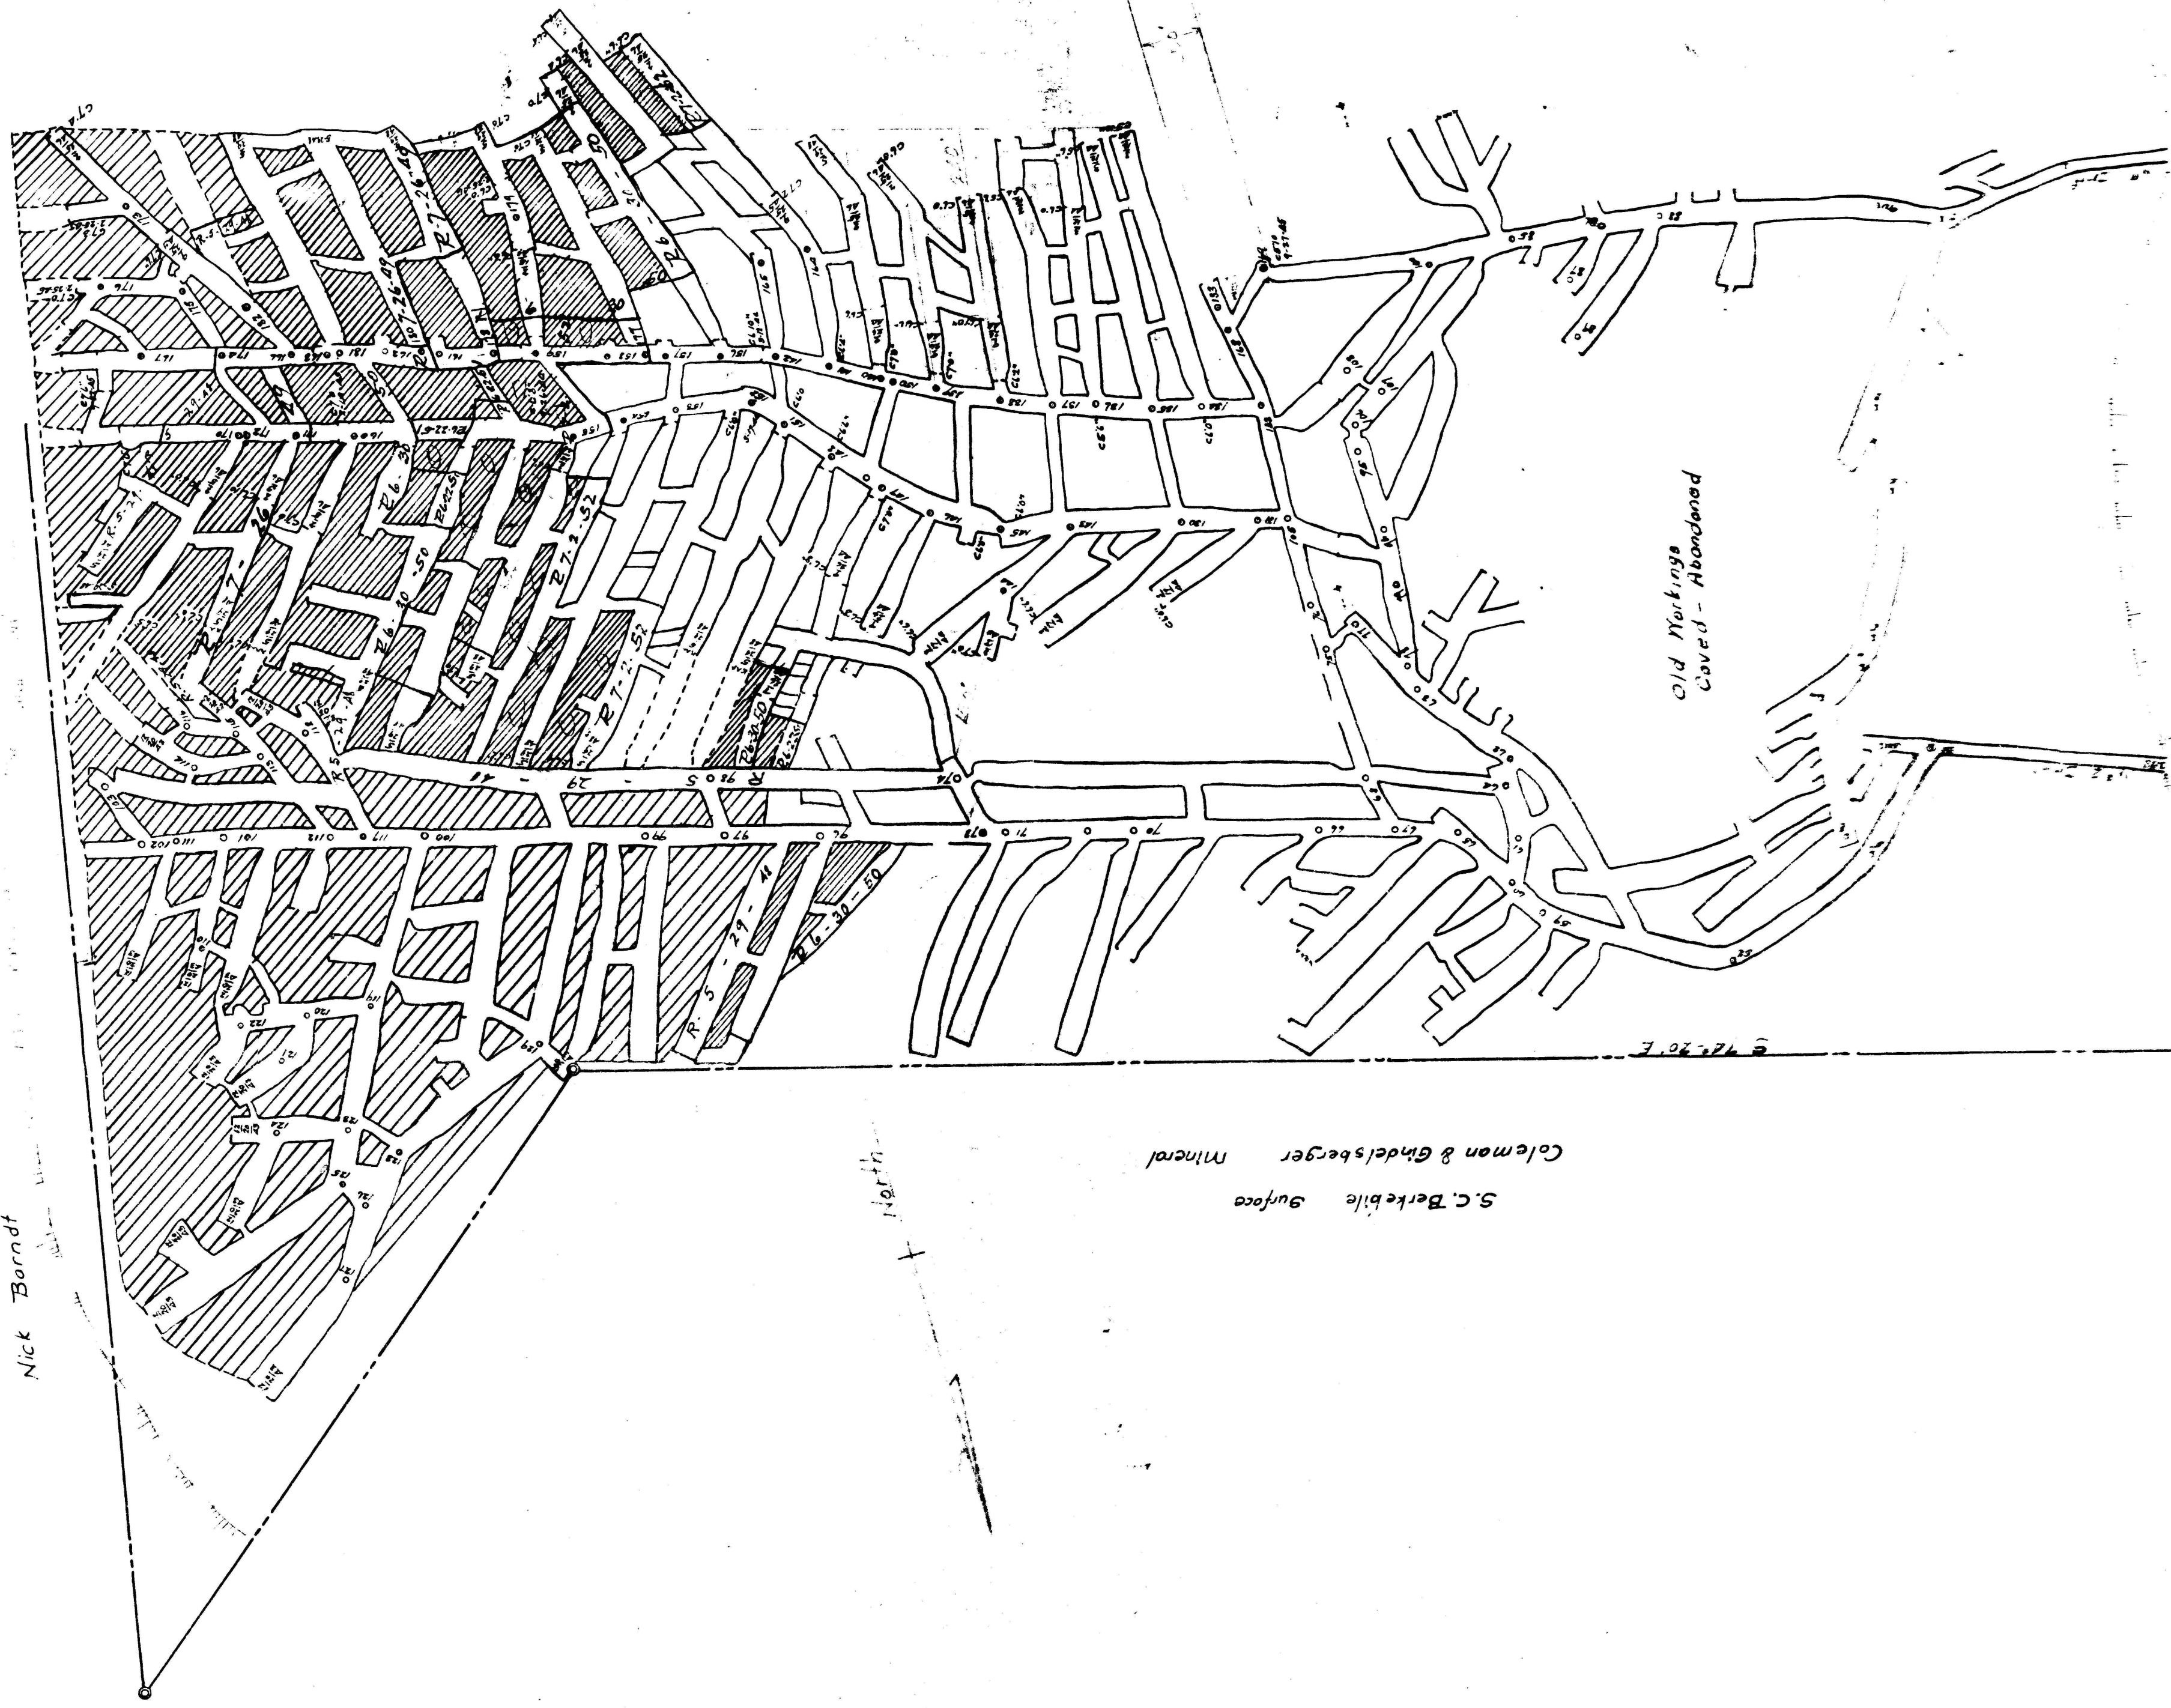

S.C. Berkeley Surface
Coleman & Gindelsberger Mineral

Old workings
Covered - Abandoned

South

DDH

2.00
2.00
2.00

0.75
0.75

