


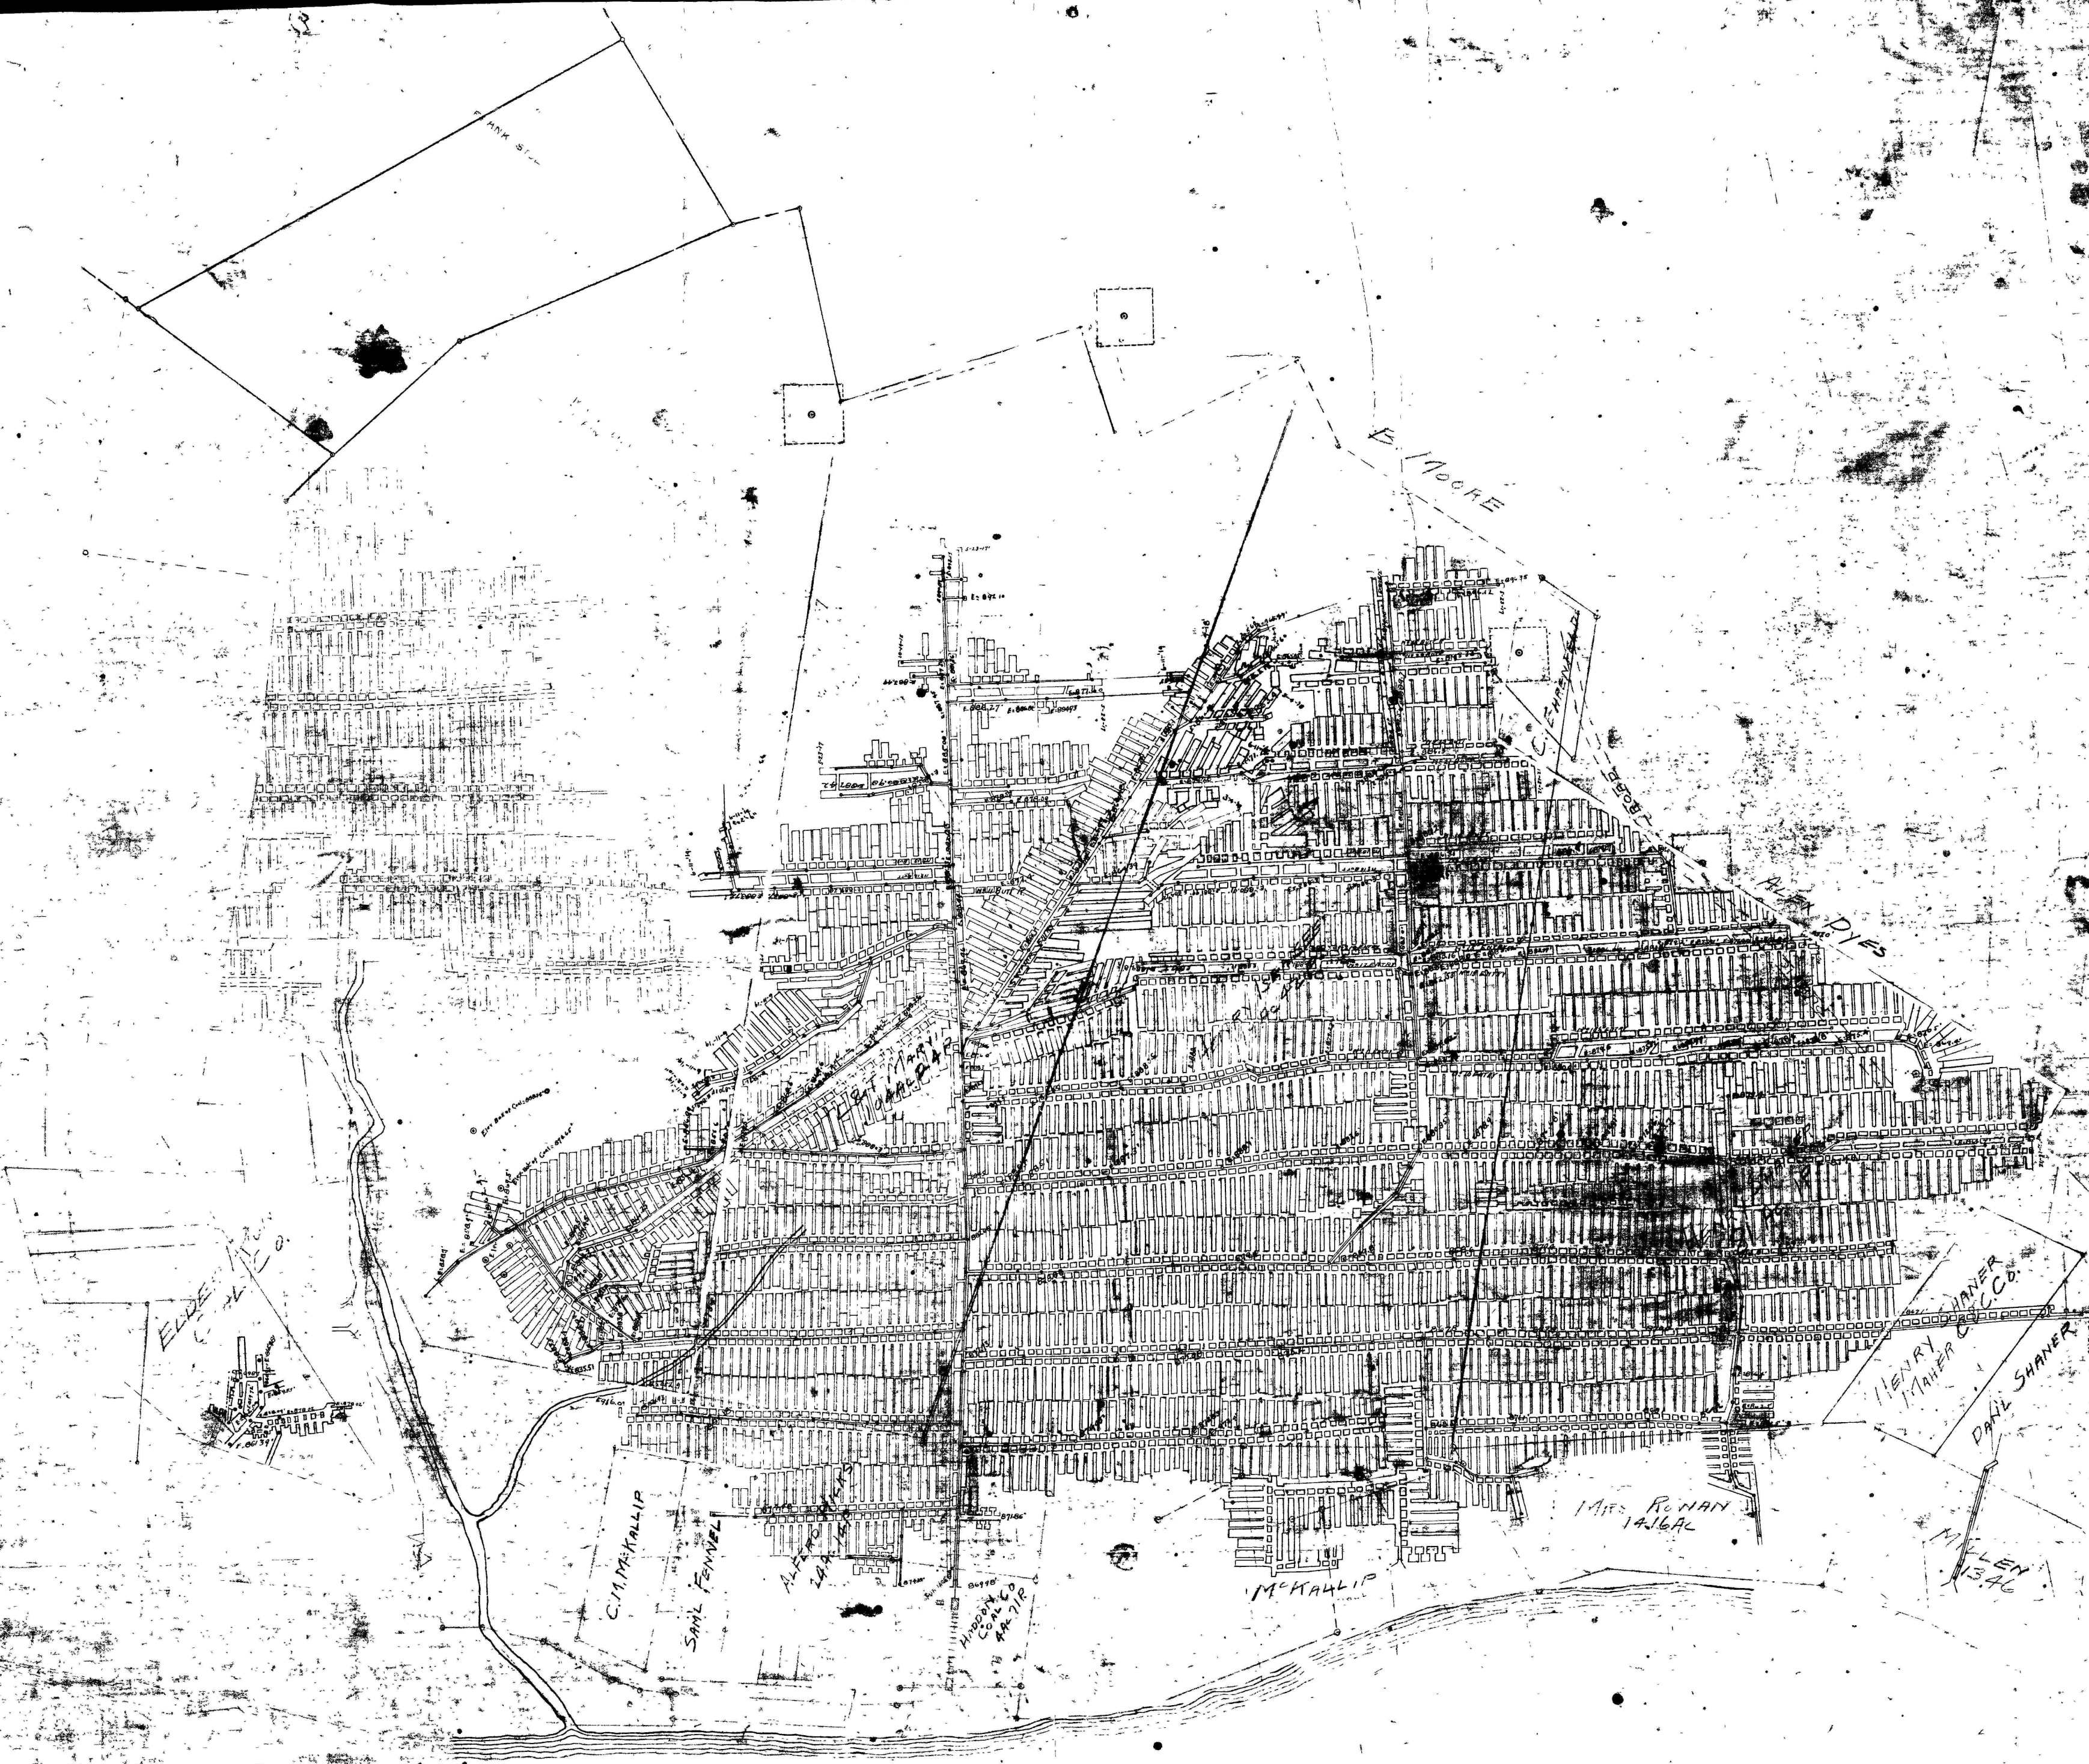

HADDON COAL CO'S MINE
situated in
GILPIN TWP. ARMSTRONG CO. PA.
Scale 1" = 200'

E. WATERS, Eng'r