



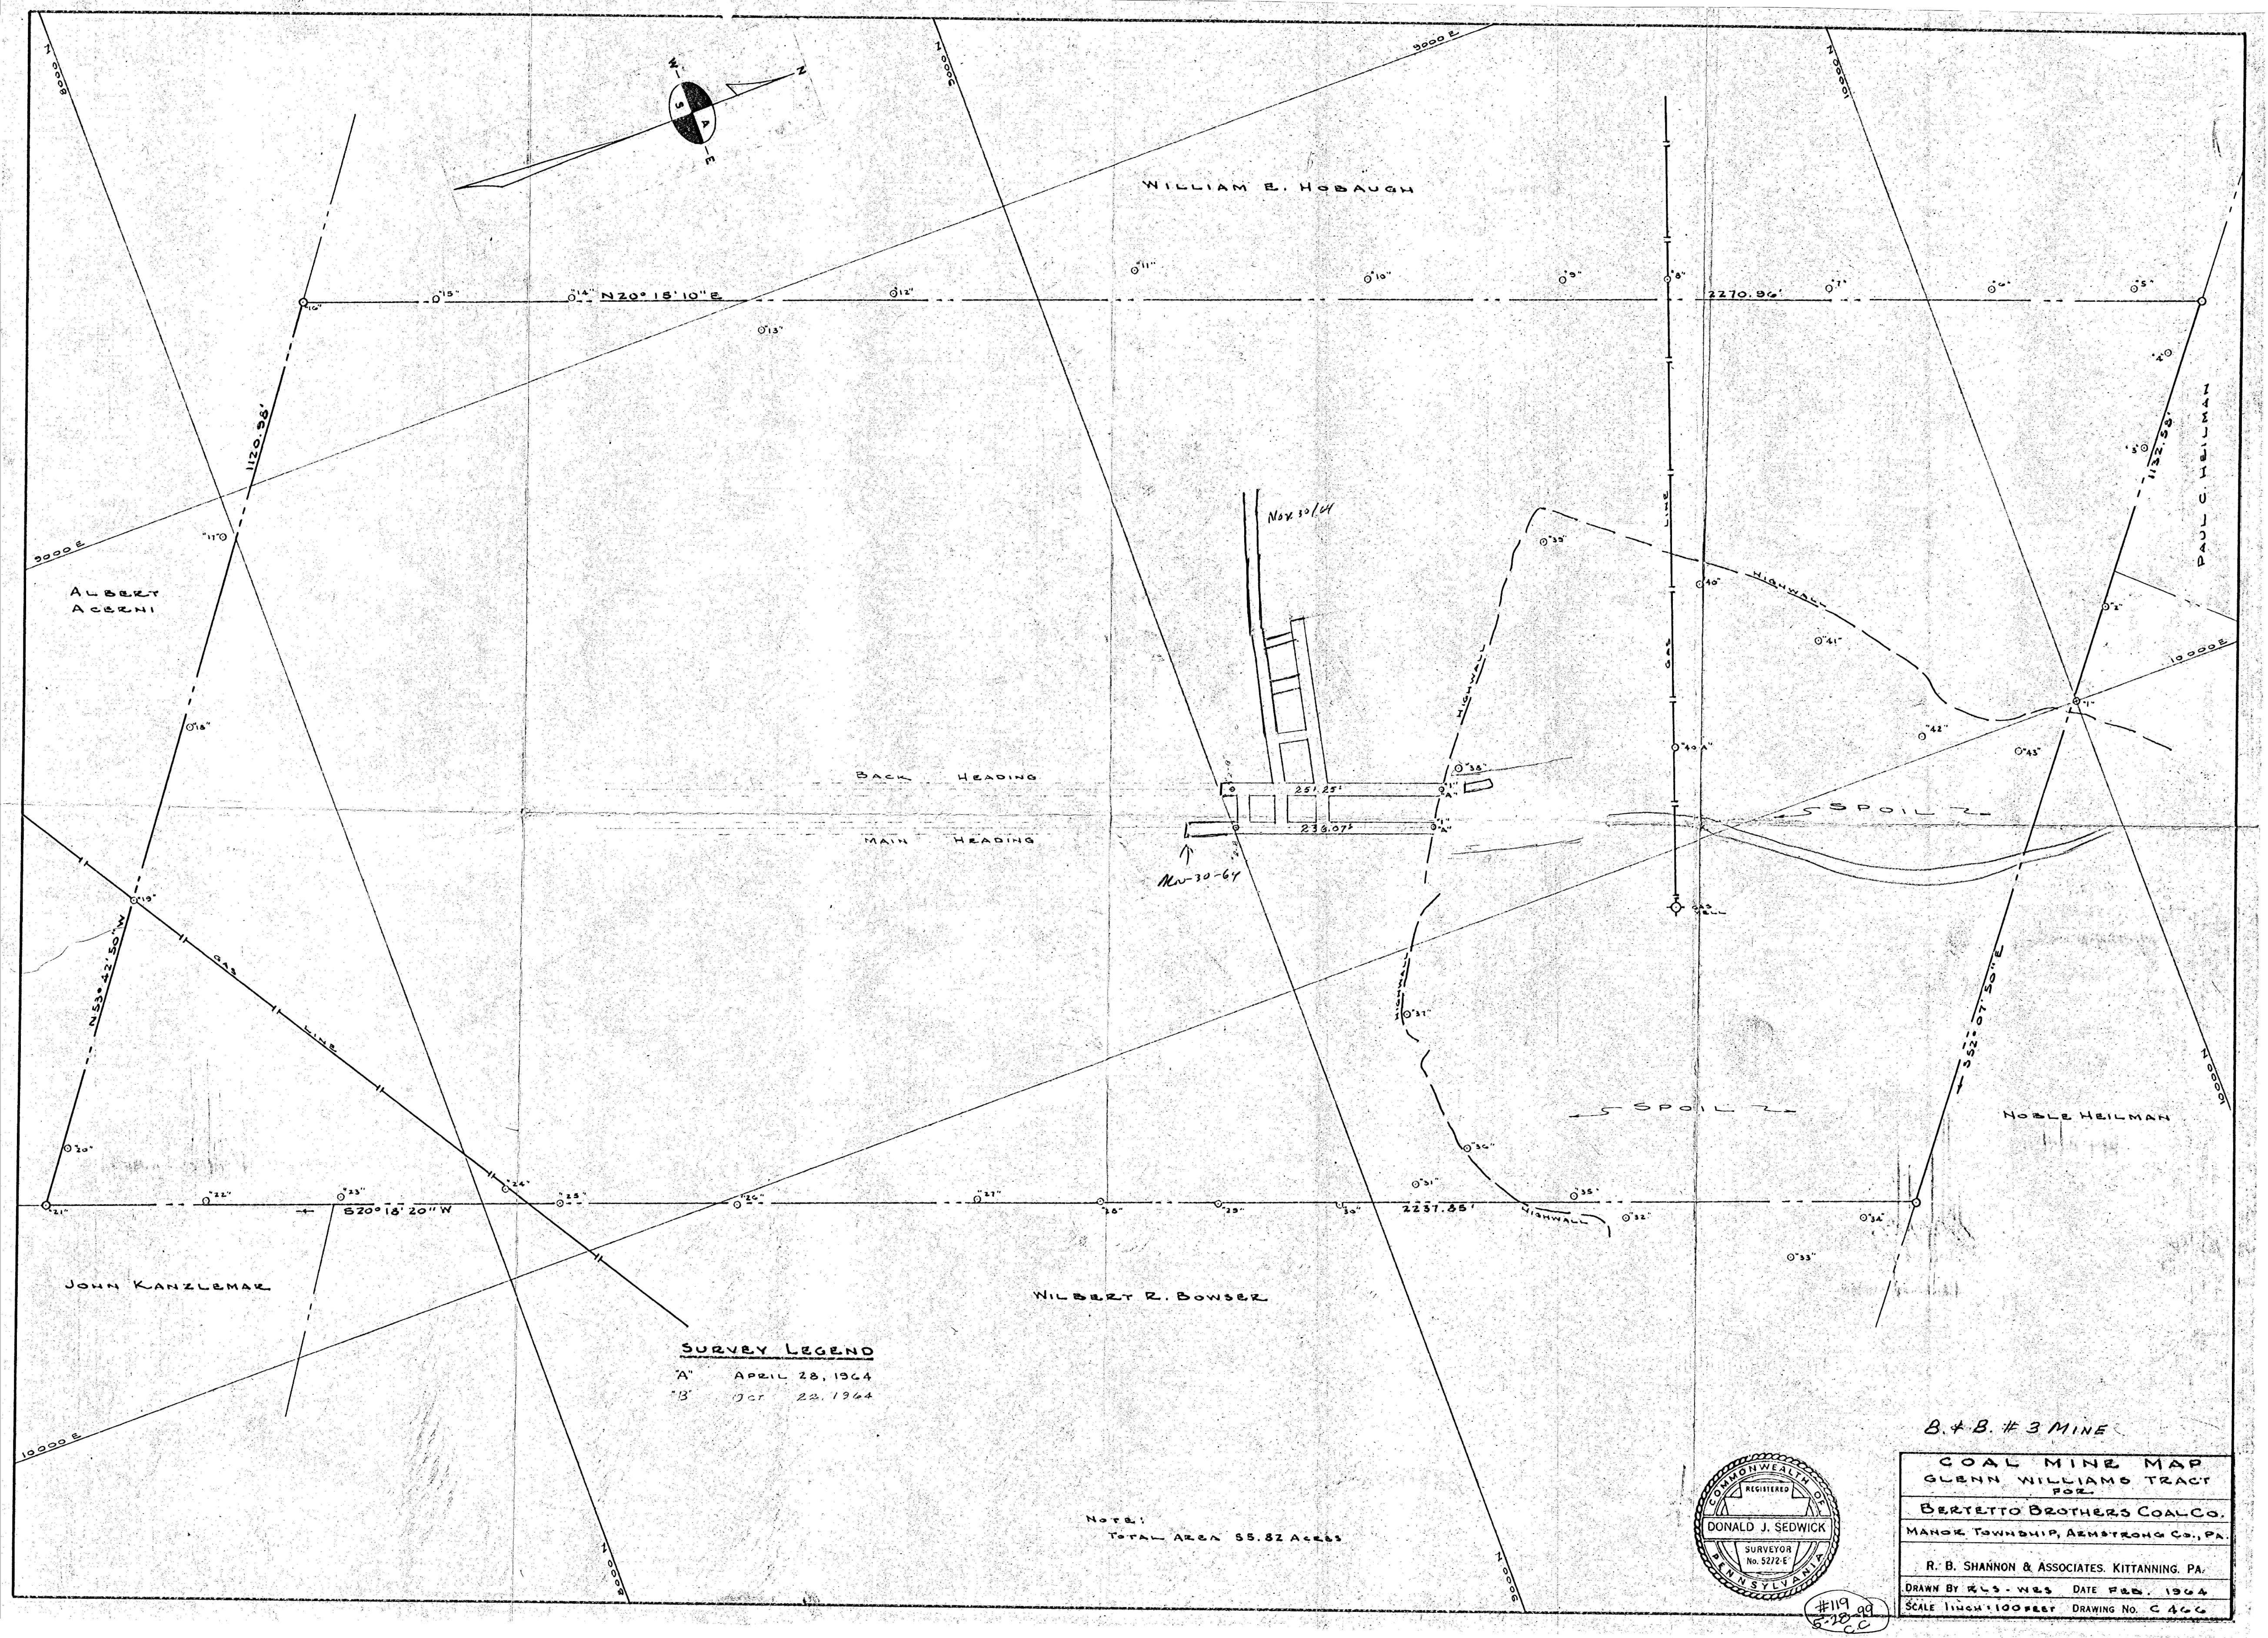

SURVEY LEGEND

A" APRIL 28, 1964
B" OCT 22, 1964

NOTE:
TOTAL AREA 55.82 ACRES

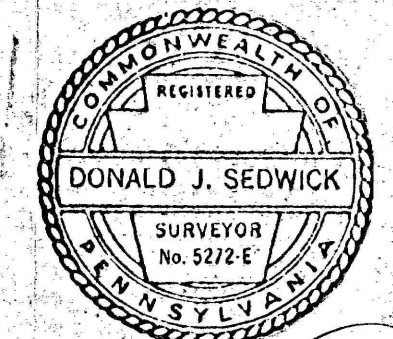

B. & B. #3 MINE

COAL MINE MAP
GLENN WILLIAMS TRACT
FOR
BERTETTO BROTHERS COAL CO.
MARBLE TOWNSHIP, ARMSTRONG CO., PA.
R. B. SHANNON & ASSOCIATES, KITTANNING, PA.
DRAWN BY RLS-WES DATE FEB. 1964
SCALE 1 inch = 100 FEET DRAWING NO. C 466