



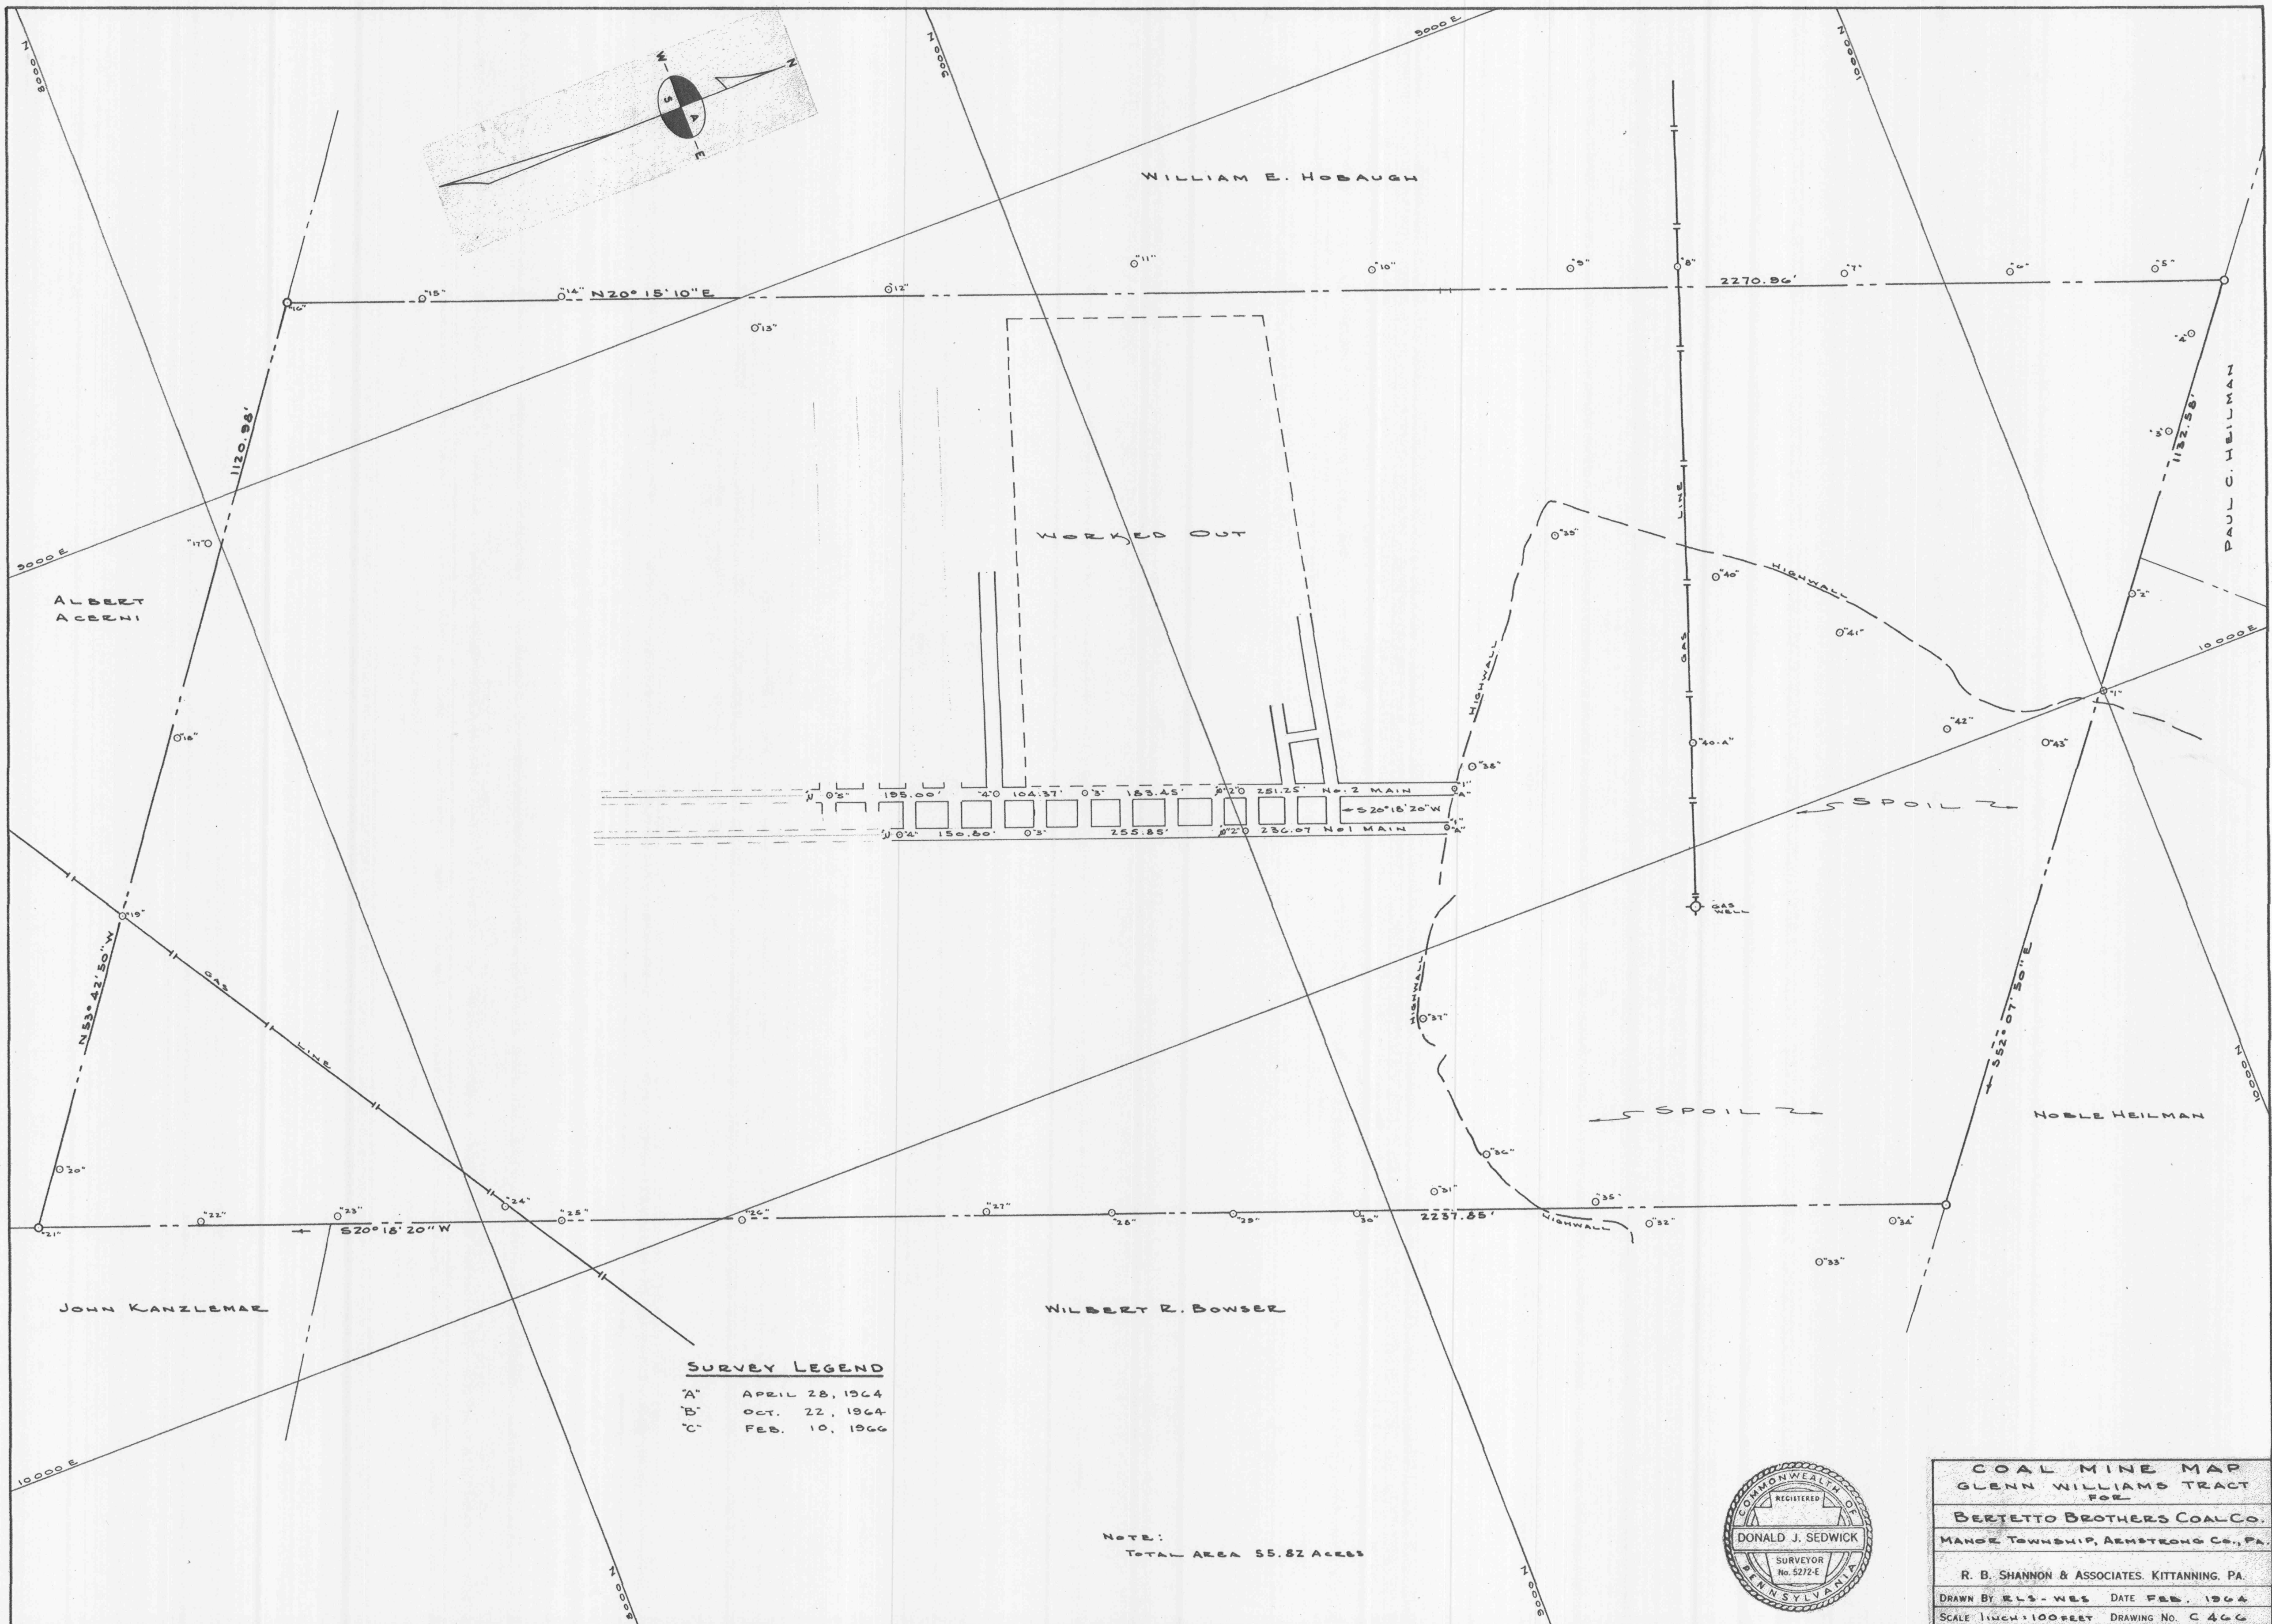

SURVEY LEGEND

"A" APRIL 28, 1964
 "B" OCT. 22, 1964
 "C" FEB. 10, 1966

NOTE:
 TOTAL AREA 55.82 ACRES

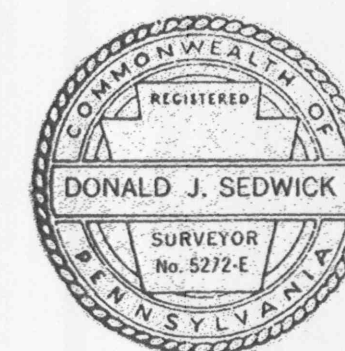

COAL MINE MAP	
GLENN WILLIAMS TRACT	
FOR	
BERTETTO BROTHERS COAL CO.	
MADON TOWNSHIP, ARMSTRONG CO., PA.	
R. B. SHANNON & ASSOCIATES, KITTANNING, PA.	
DRAWN BY RLS-WBS	DATE FEB. 1964
SCALE 1 INCH = 100 FEET DRAWING NO. C 466	