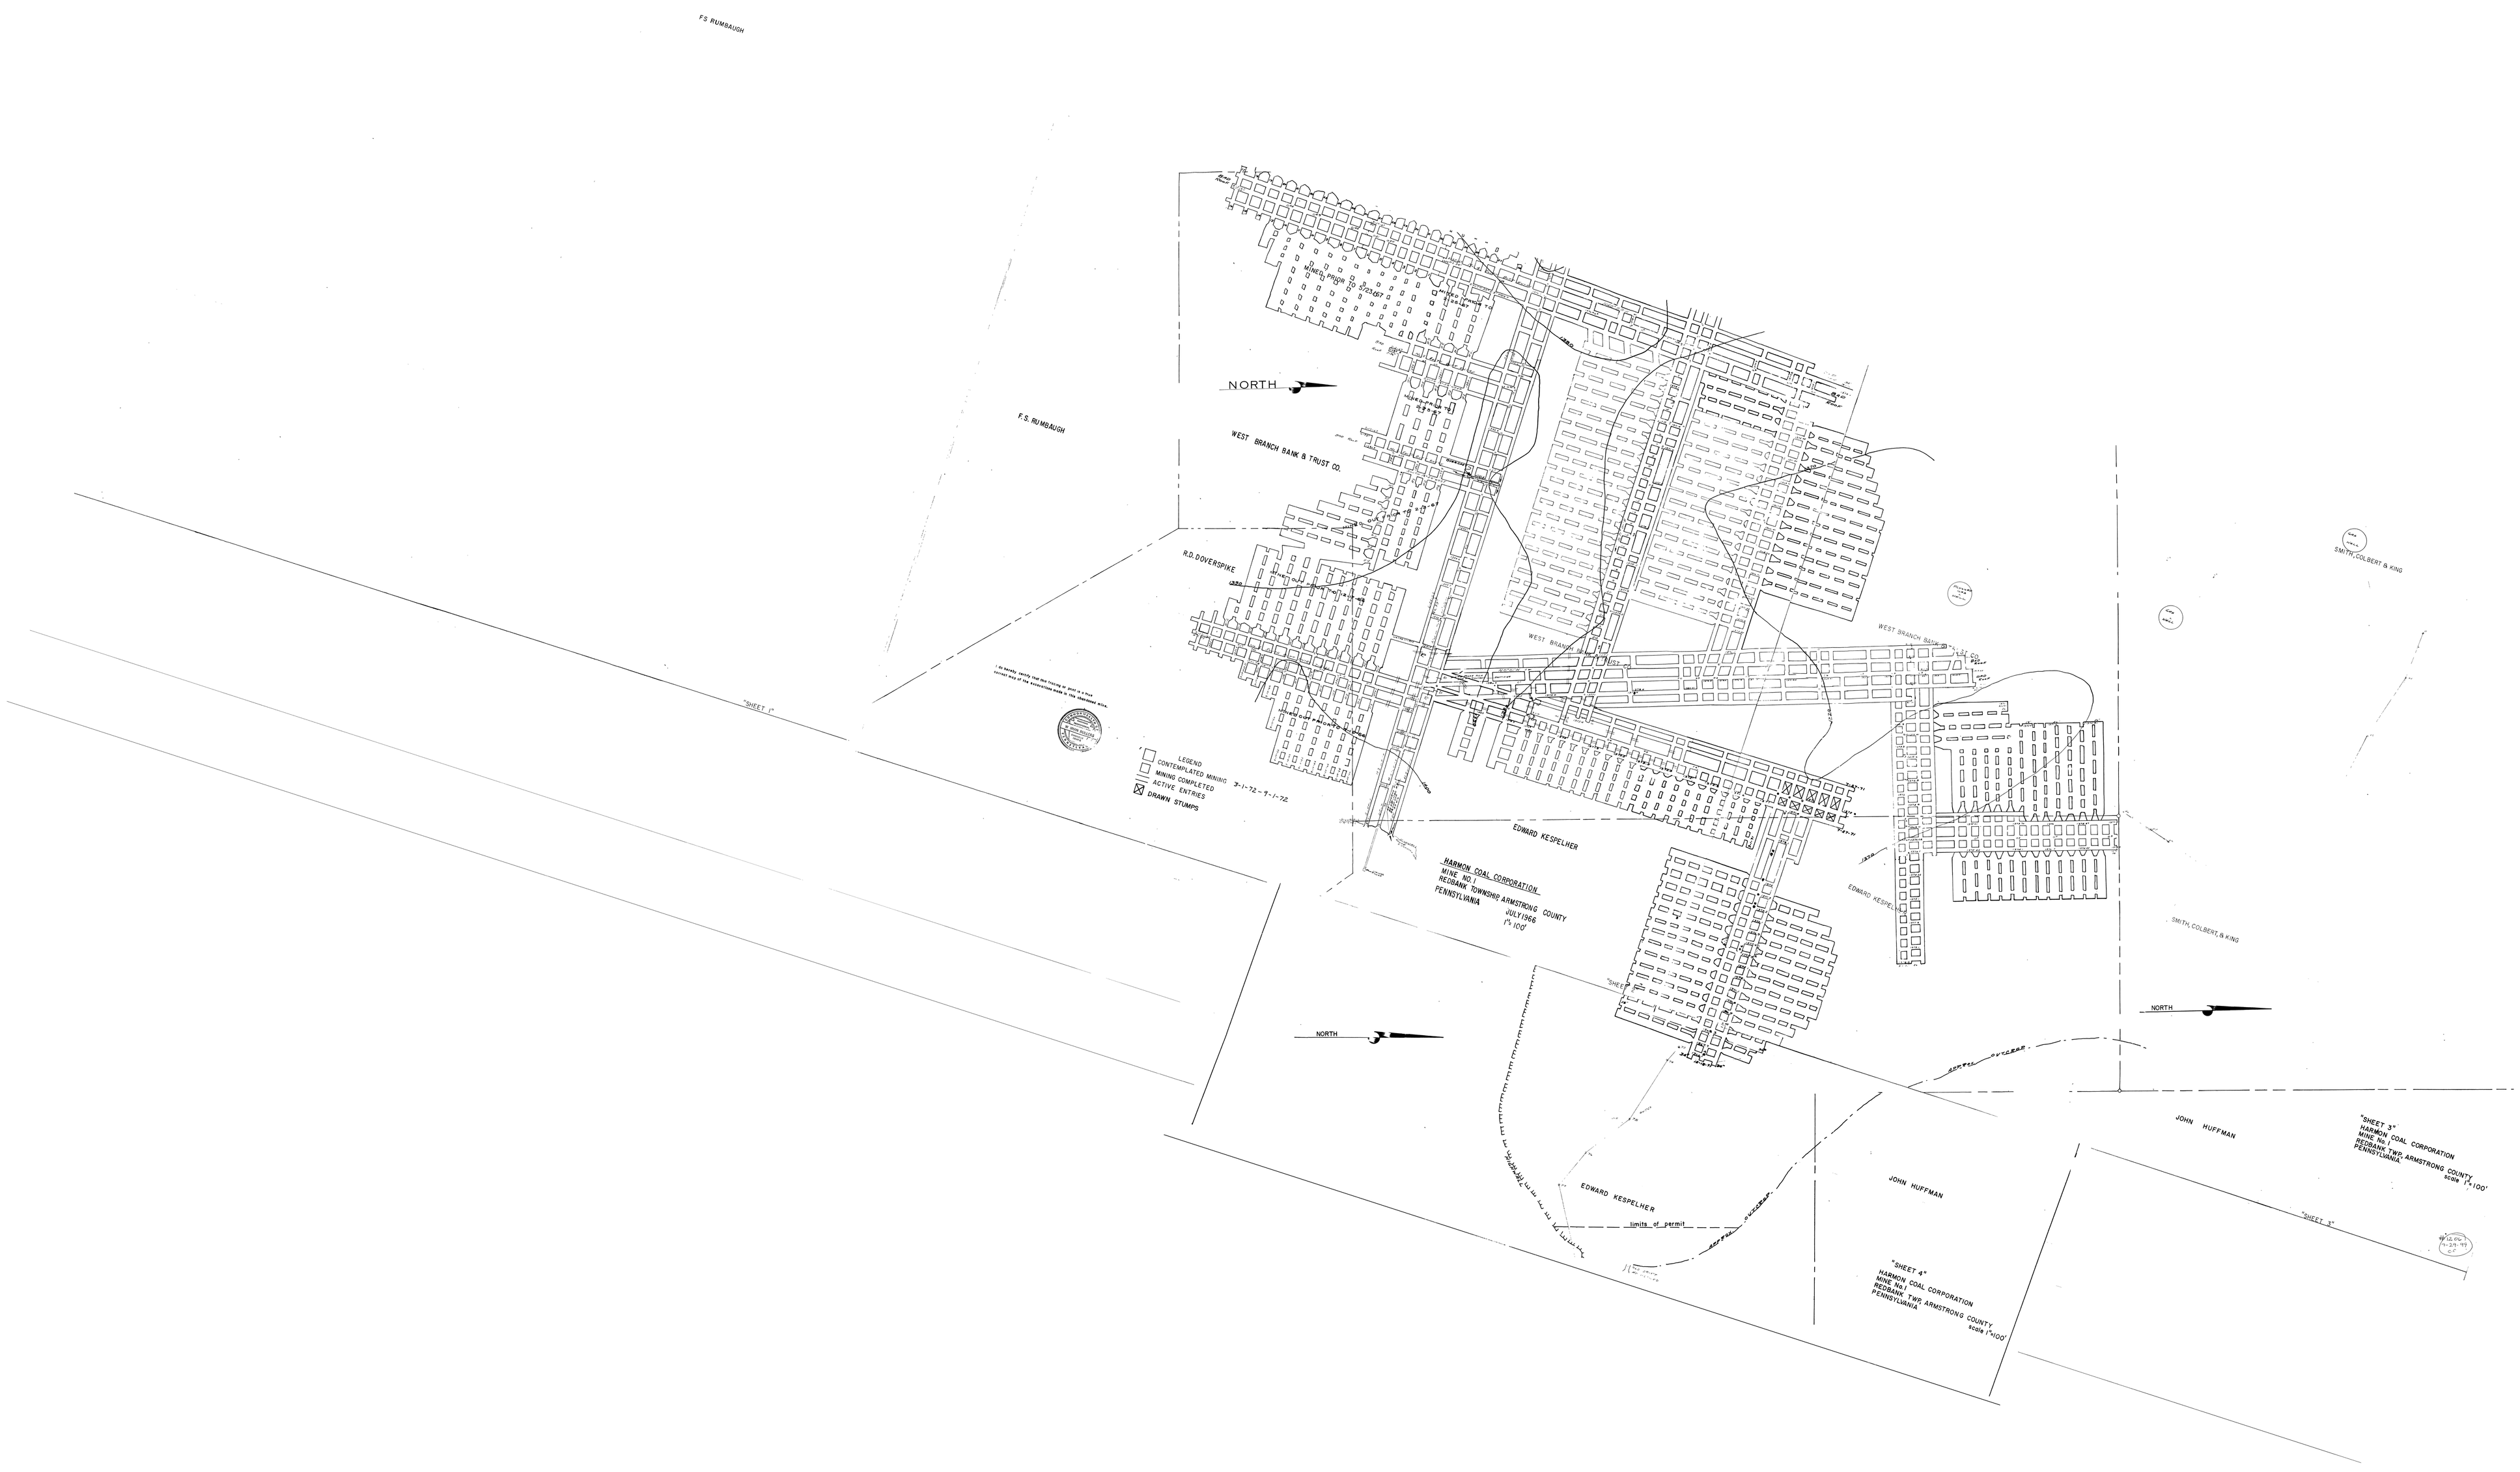
F.S. RUMBAUGH
F.S. RUMBAUGH
NORTH
WEST BRANCH BANK & TRUST CO.
R.D. DOVERSPIKE
WEST BRANCH BANK & TRUST CO.
WEST BRANCH BANK & TRUST CO.
SMITH, COLBERT & KING
SMITH, COLBERT & KING
LEGEND
CONTEMPLATED MINING 7-1-72 - 9-1-72
MINING COMPLETED
ACTIVE ENTRIES
DRAWN STUMPS
EDWARD KESPELHER
HARMON COAL CORPORATION
MINE NO. 1
PENNSYLVANIA
1" = 100'
EDWARD KESPELHER
NORTH
NORTH
"SHEET 1"
"SHEET 2"
"SHEET 3"
EDWARD KESPELHER
limits of permit
JOHN HUFFMAN
JOHN HUFFMAN
"SHEET 4"
HARMON COAL CORPORATION
MINE NO. 1
PENNSYLVANIA
scale 1"=100'
HARMON COAL CORPORATION
MINE NO. 1
PENNSYLVANIA
scale 1"=100'