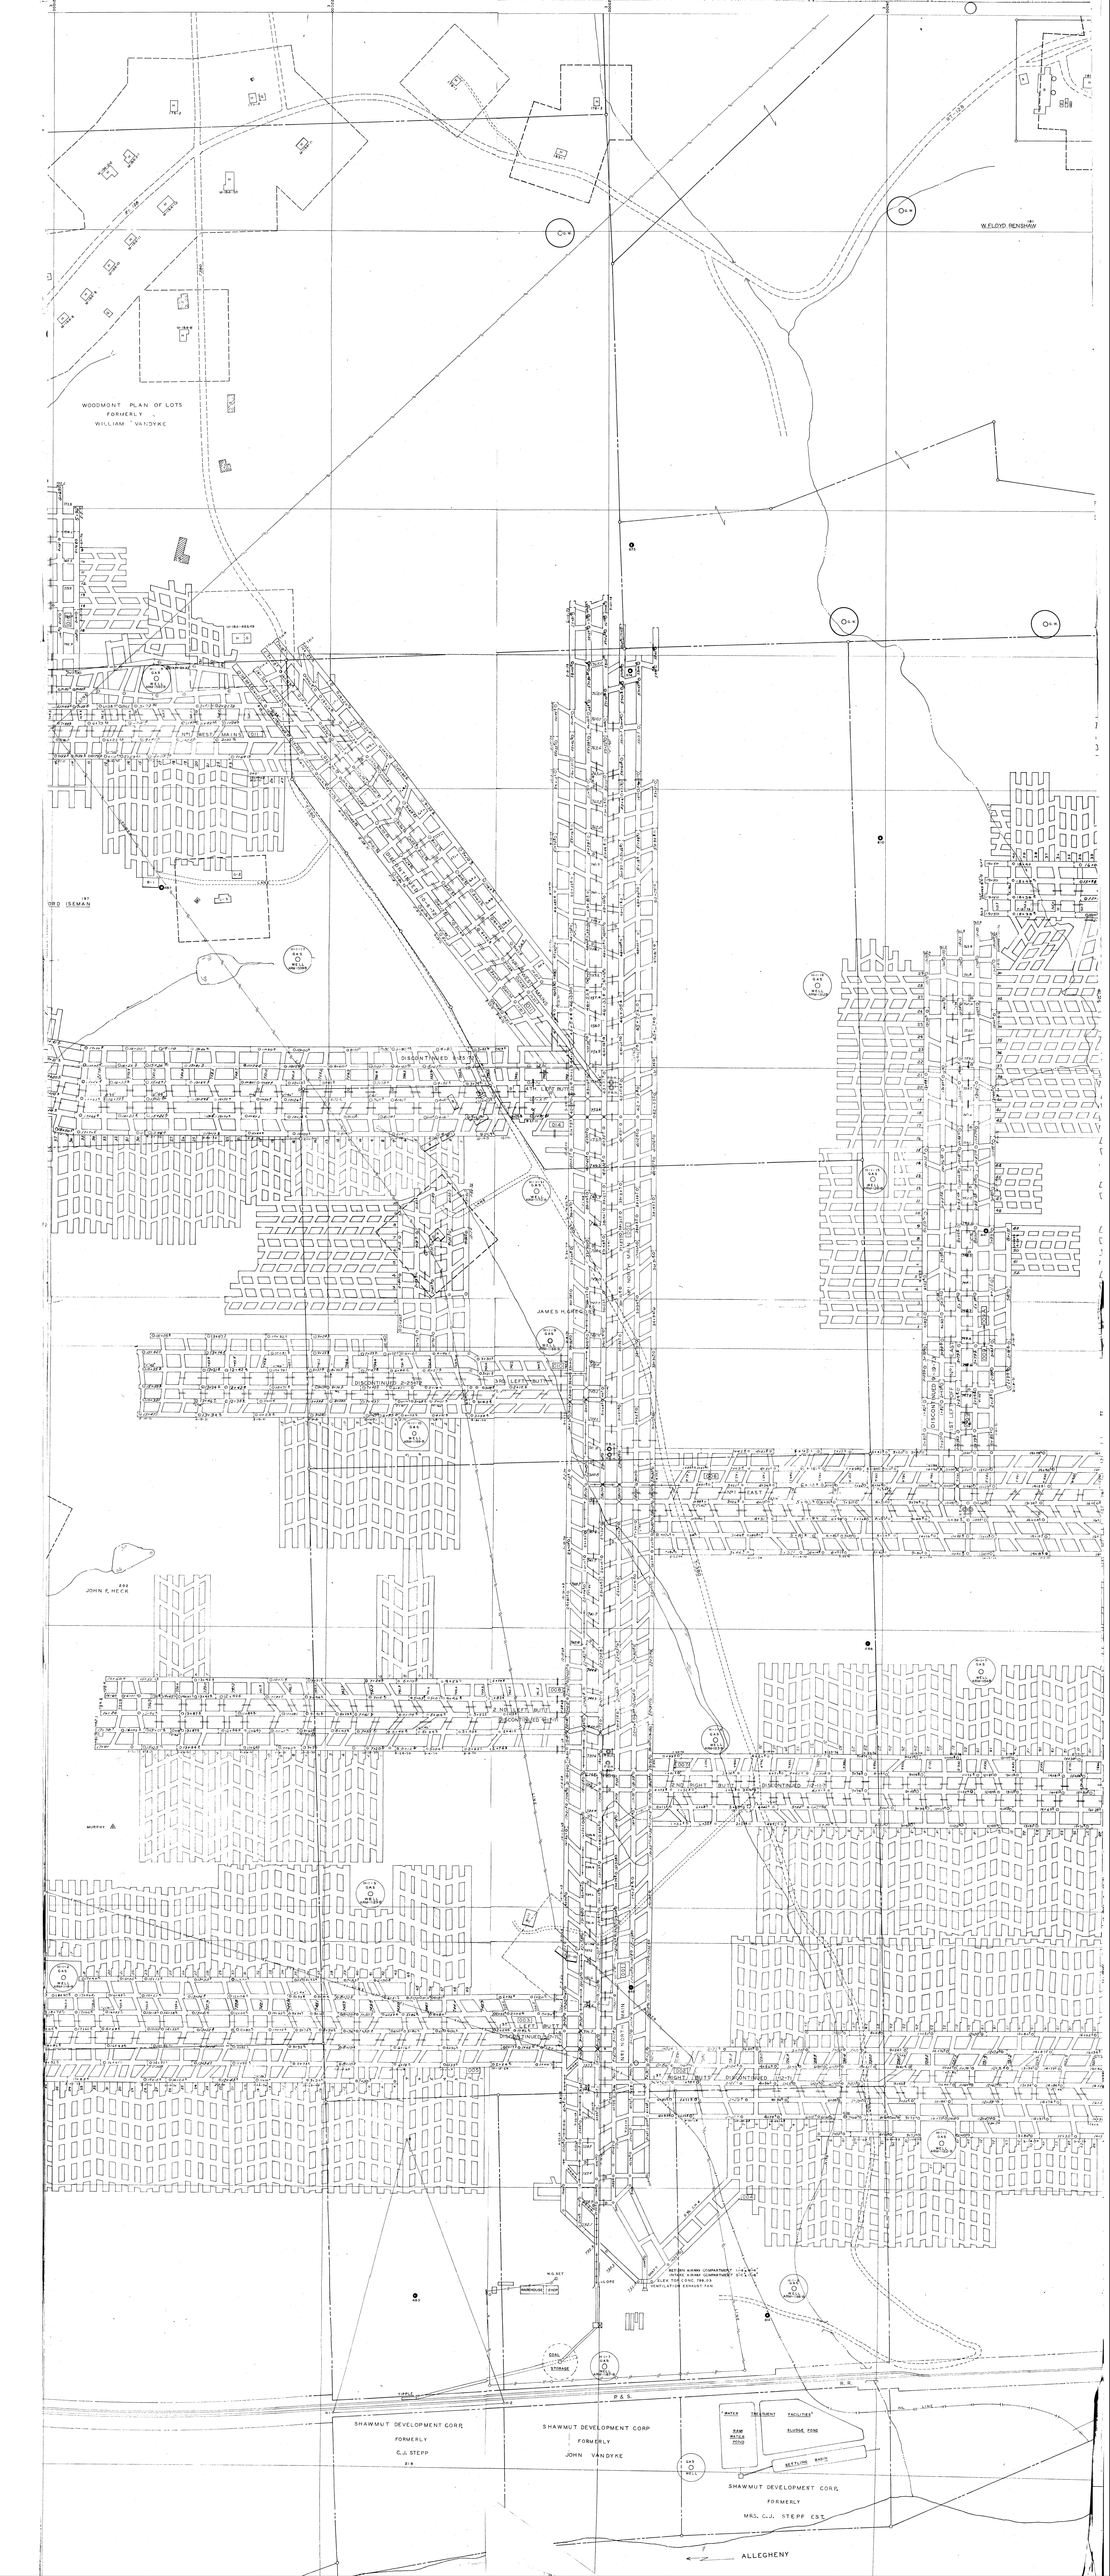

2100 E
2200 E
2300 E
2400 E
179-2
179-4
H-179-1
183-1
M-184-2-2
M-184-2-1
M-184-71
M-184-50
M-184-12
M-184-11
M-184-10
M-184-9
M-184-8
RT. 128
T-380
M-184-18
WOODMONT PLAN OF LOTS
FORMERLY
WILLIAM VANDYKE
G.W.
181
W. FLOYD RENSHAW
RT-128
675
M-184-48&49
H-1-18
GAS
WELL
ARM 1360 B
VAN DYKE
011
Nº1 WEST MAINS
LINE
POWER
249'
STOPPED 8-31-71
LANE
B-1
487
G-2
G-3
197
ORD ISEMAN
H-1-17
GAS
WELL
ARM 1359B
DISCONTINUED 10-6-72
674
610
H-1-14
GAS
WELL
ARM-1312B
DISCONTINUED 9-25-72
4TH. LEFT BUTT
014
H-1-51
GAS
WELL
ARM-1170-B
Nº1 NORTH MAIN
001
P.B.H.
H-1-13
GAS
WELL
ARM-1281-B
441
009A
009
Nº1 EAST
DISCONTINUED 9-19-73
1ST LEFT OFF Nº1 EAST
JAMES H. GREGORY
H-1-9
GAS
WELL
ARM-1168-B
010
3RD. LEFT BUTT
DISCONTINUED 2-25-72
H-1-10
GAS
WELL
ARM-1169-B
006
Nº1 EAST
T-380
202
JOHN F. HECK
486
H-1-5
GAS
WELL
ARM-1154B
008
2 ND LEFT BUTT
DISCONTINUED 9-17-71
H-1-4
GAS
WELL
ARM-1153-B
007
2ND RIGHT BUTT DISCONTINUED 12-11-71
MURPHY
H-1-3
GAS
WELL
ARM-1123-B
H-1-2
GAS
WELL
ARM-1118-B
003
1ST. LEFT BUTT
DISCONTINUED 5-7-71
005
B-11
D-10
649
Nº1 NORTH MAIN
002
1ST. RIGHT BUTT DISCONTINUED 11-12-71
G.W.
H-1-1
GAS
WELL
ARM-1122-B
004
0% CH4
RUN
RETURN AIRWAY COMPARTMENT 11'-6"x14'-4"
INTAKE AIRWAY COMPARTMENT 5'-0"x11'-6"
ELEV. TOP CONC. 799.03
VENTILATION EXHAUST FAN
SHAFT
SLOPE
M.G. SET
WAREHOUSE
SHOP
483
H-1-8
GAS
WELL
ARM-1166-B
614
LINE
COAL
STORAGE
H-1-7
GAS
WELL
ARM-1167-B
TIPPLE
H-1
H-2
R.R.
P. & S.
OIL LINE
SHAWMUT DEVELOPMENT CORP.
FORMERLY
C.J. STEPP
218
SHAWMUT DEVELOPMENT CORP
FORMERLY
JOHN VANDYKE
"WATER TREATMENT FACILITIES"
RAW WATER POND
SLUDGE POND
SETTLING BASIN
GAS
WELL
SHAWMUT DEVELOPMENT CORP.
FORMERLY
MRS. C.J. STEPP EST.
ALLEGHENY