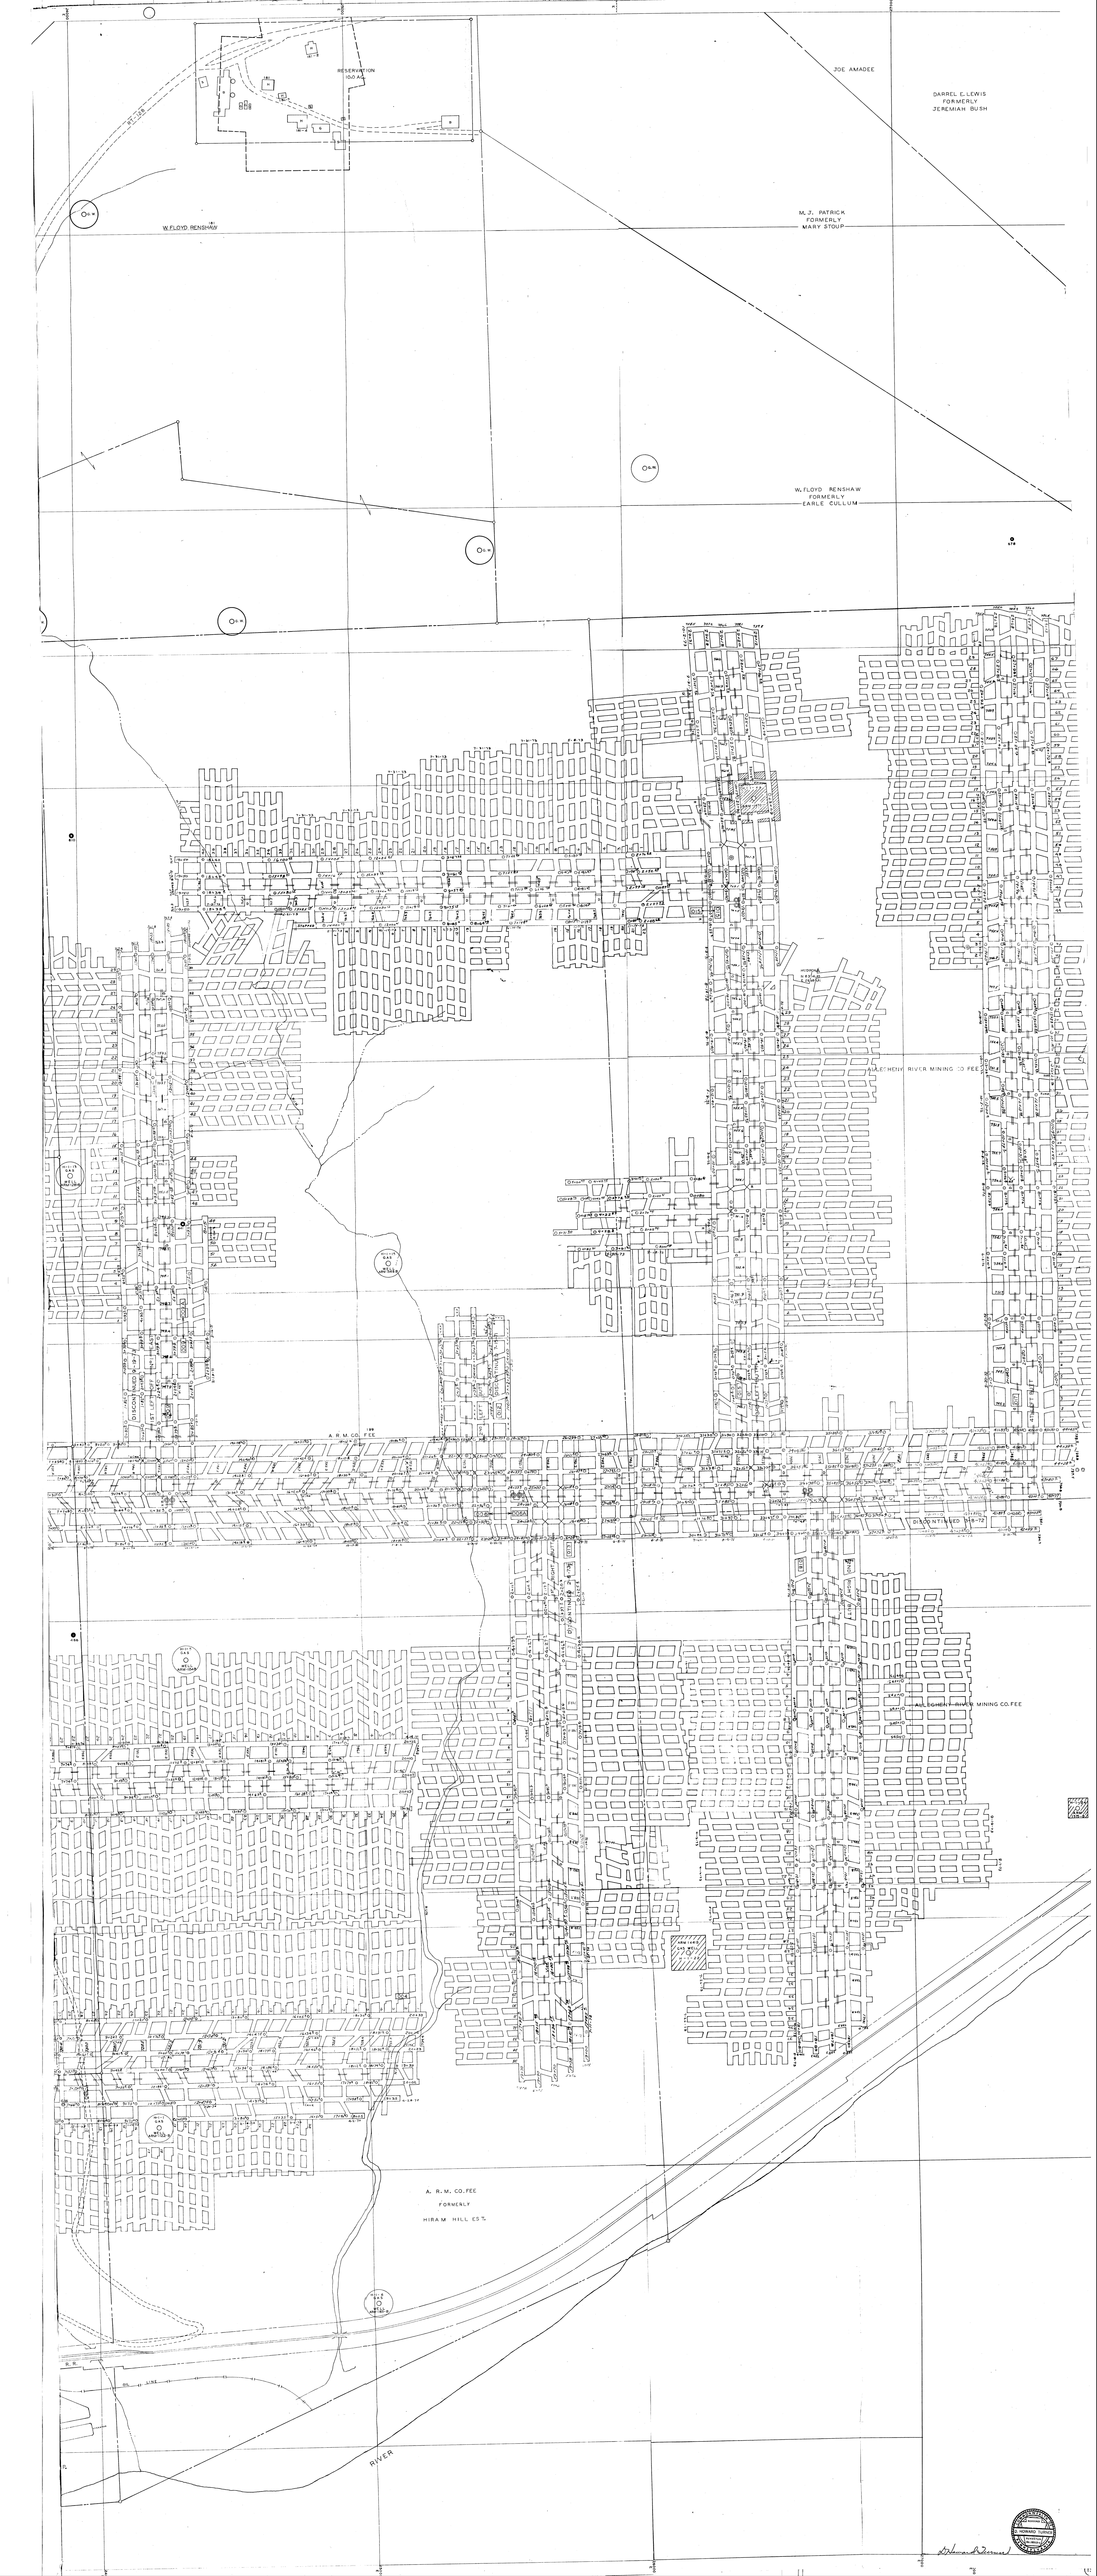

RESERVATION
160 AC.
JOE AMADEE
DARREL E. LEWIS
FORMERLY
JEREMIAH BUSH
W. FLOYD RENSHAW
M. J. PATRICK
FORMERLY
MARY STOUP
W. FLOYD RENSHAW
FORMERLY
EARLE CULLUM
A. R. M. CO. FEE
FORMERLY
HIRAM HILL ESTS.
RIVER