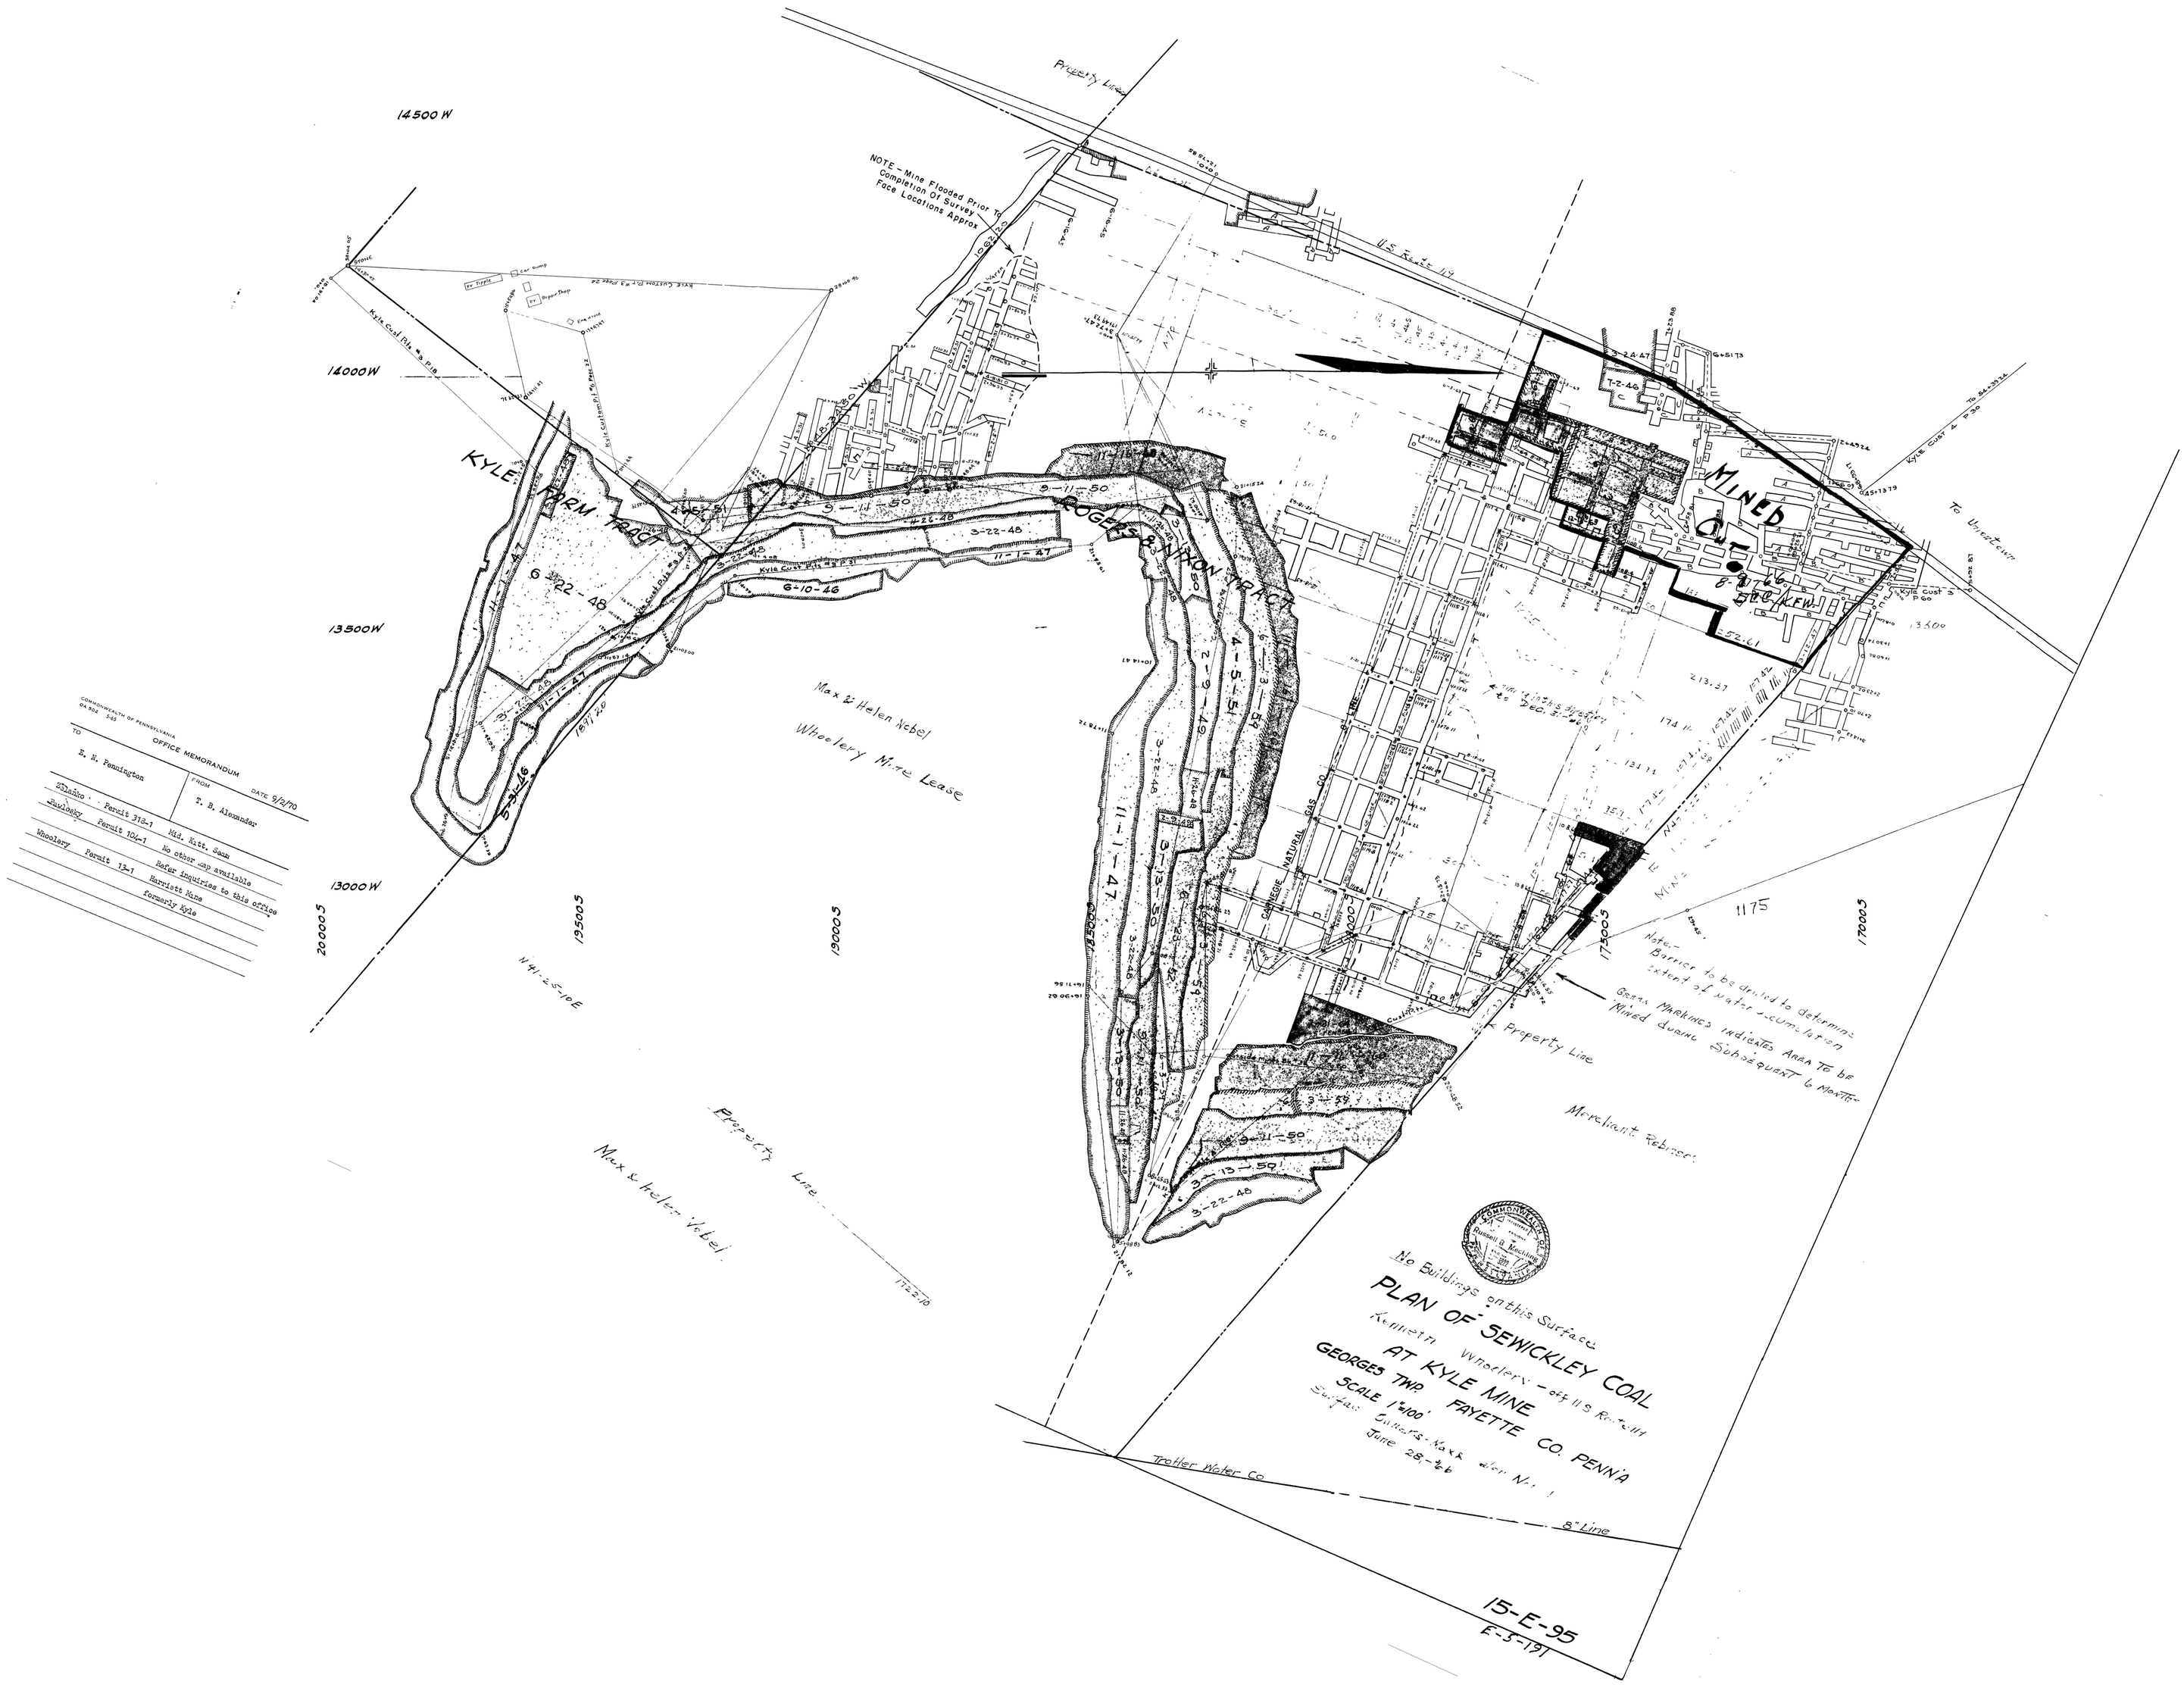
14500 W
14000W
13500W
13000W
200000S
195000S
190000S
185000S
180000S
175000S
170000S
Property Line
U.S. Route 119
NOTE – Mine Flooded Prior To Completion Of Survey Face Locations Approx
KYLE FARM TRACT
ROGERS & AYRON TRACT
Mined Out
Max & Helen Nebel
Wheelery Mine Lease
Max & helen Nebel
Merchant Refiner
Trotter Water Co
8" Line
Note – Barrier to be drilled to determine extent of water accumulation
Green Markings indicates Area To be Mined during Subsequent 6 Months
No Buildings on this Surface
PLAN OF SEWICKLEY COAL
AT KYLE MINE
GEORGES TWP. FAYETTE CO. PENN'A
SCALE 1"=100'
15-E-95
E-3-191
COMMONWEALTH OF PENNSYLVANIA
OFFICE MEMORANDUM
TO E. H. Pennington
FROM E. B. Alexander
DATE 9/2/70
Shaloo - Permit 312-1 Hld. Slit. Seam
Swinedy Permit 104-1 No other map available
Wheelery Permit 13-1 Refer inquiries to this office
Harriett Mine
Formerly Kyle