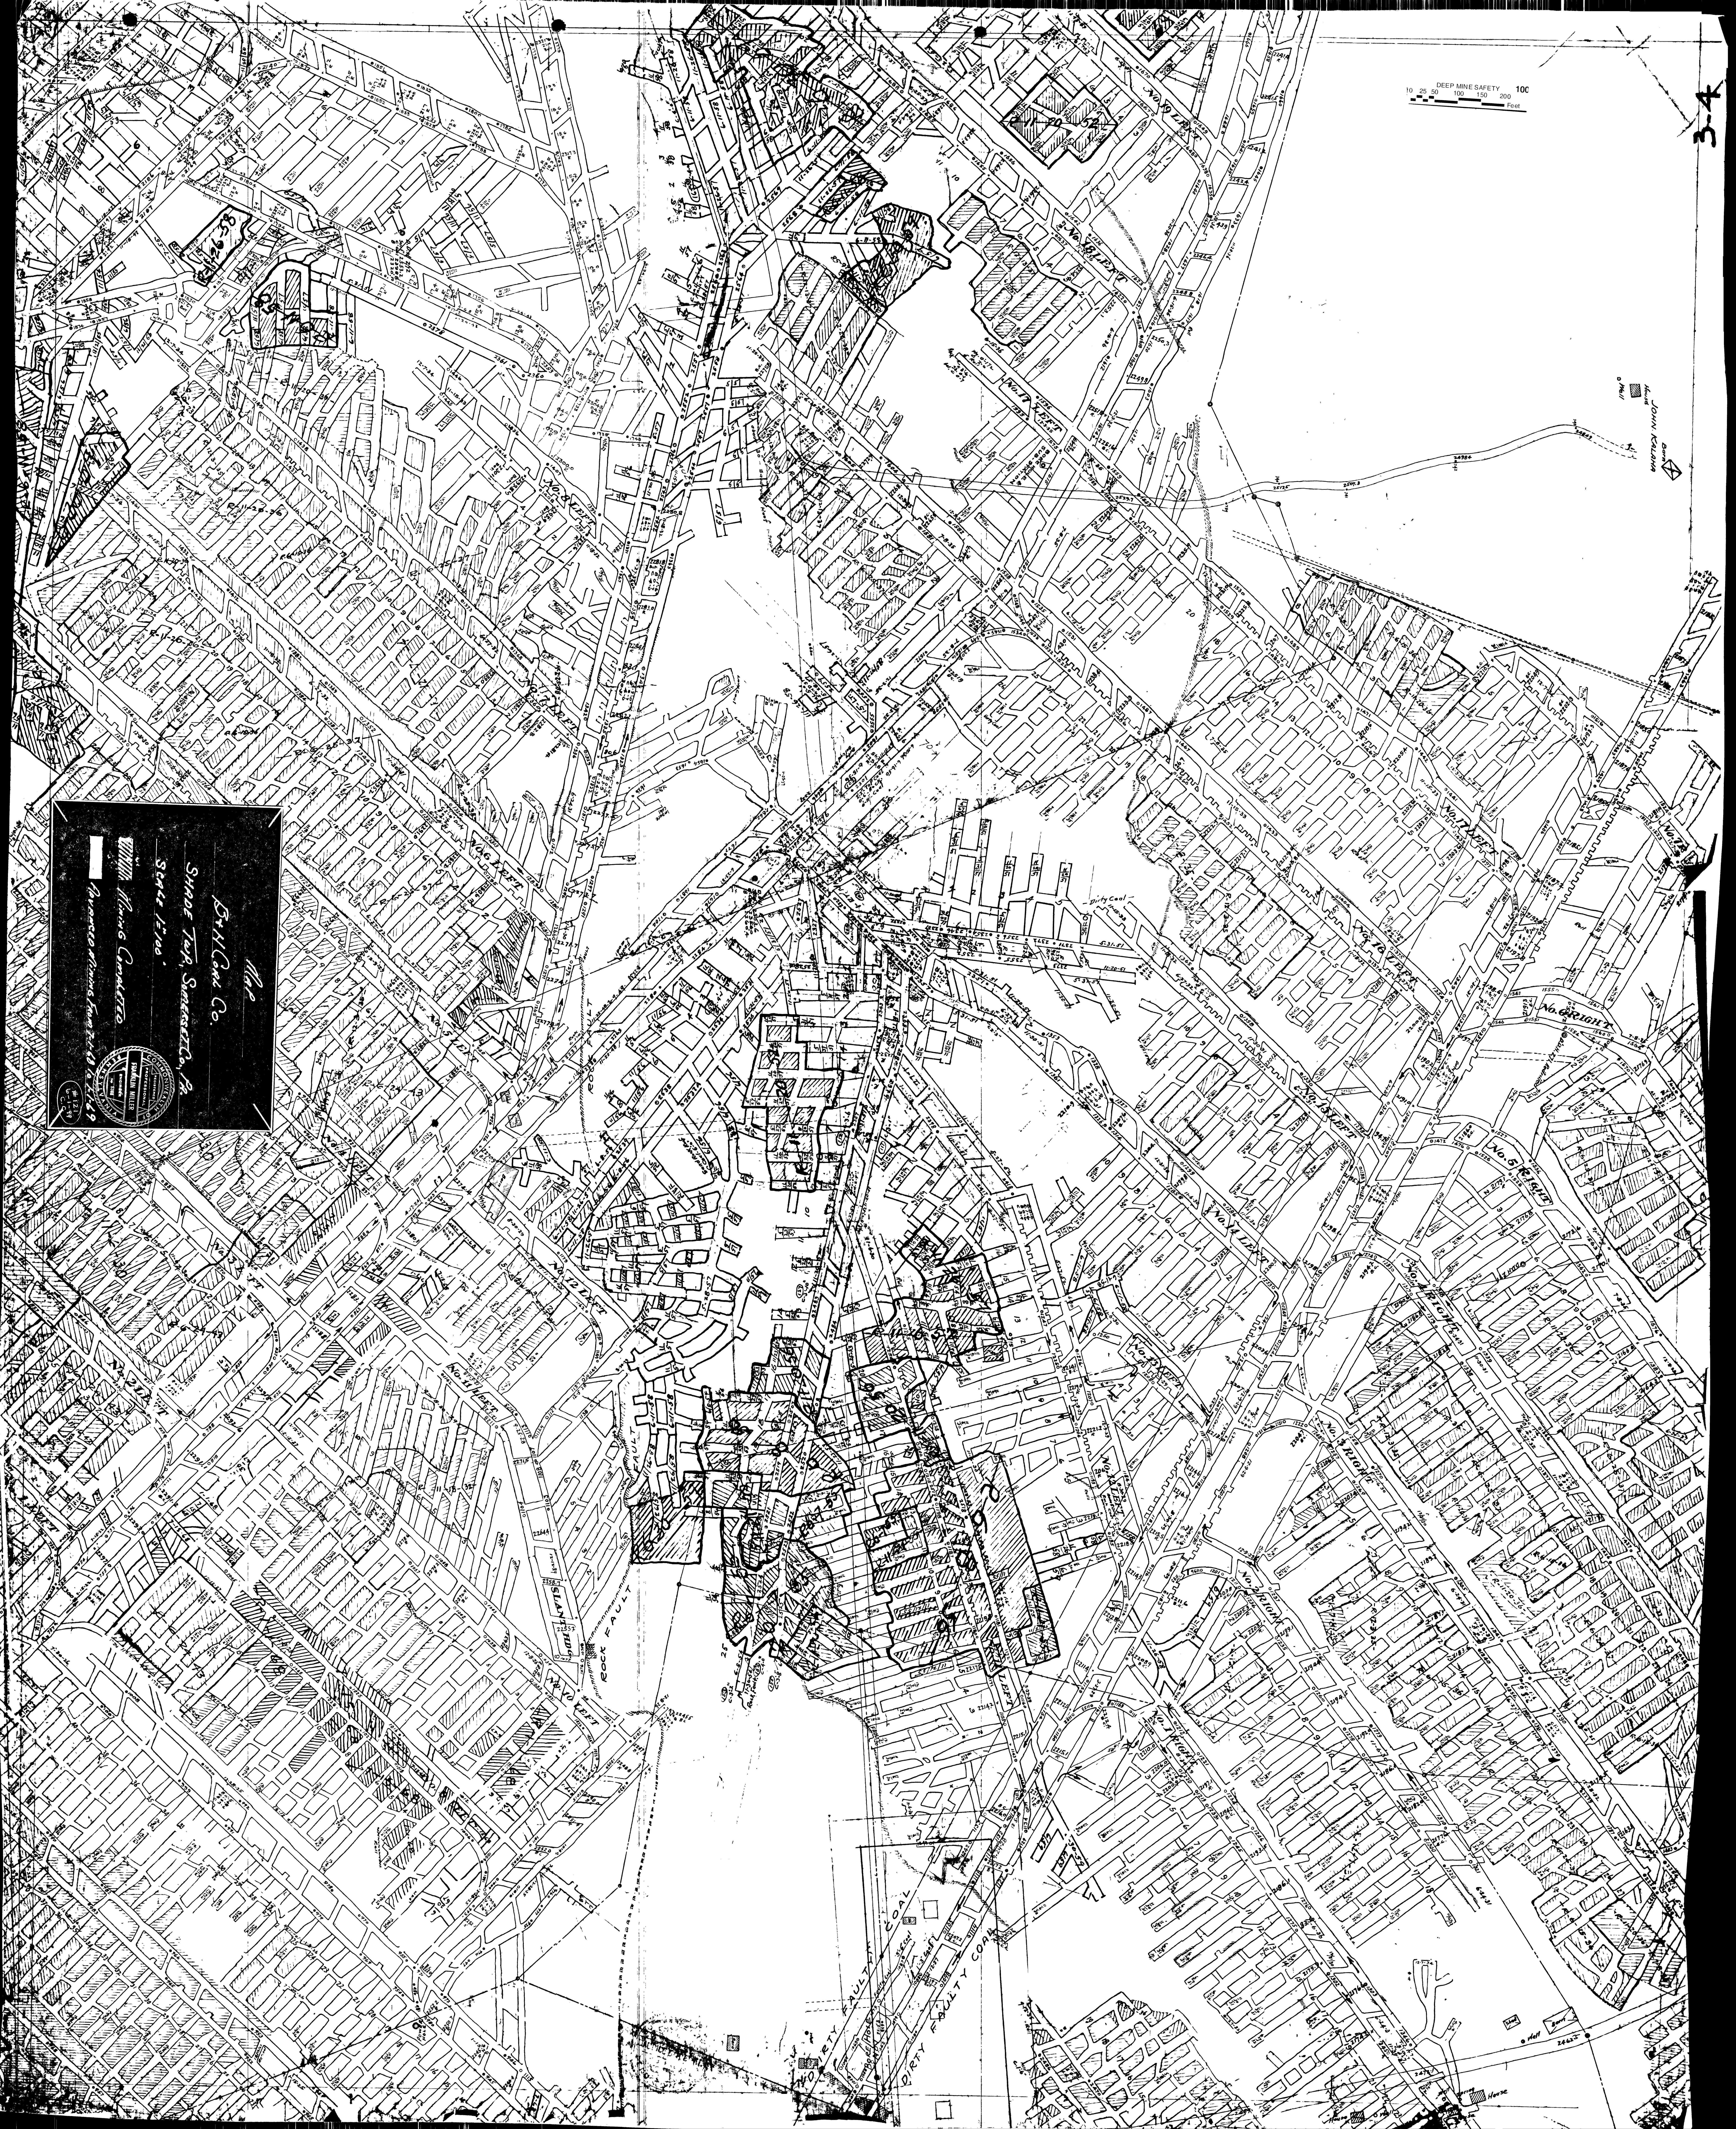
DEEP MINE SAFETY
10 25 50 100 150 200 Feet
3-4
No. 19 LEFT
No. 18 LEFT
No. 17 LEFT
No. 8 LEFT
No. 7 LEFT
No. 6 LEFT
No. 5 LEFT
No. 4 LEFT
No. 3 LEFT
No. 2 LEFT
No. 1 LEFT
No. 10 LEFT
No. 11 LEFT
No. 12 LEFT
No. 13 LEFT
No. 14 LEFT
No. 15 LEFT
No. 16 LEFT
No. 17 LEFT
No. 7 RIGHT
No. 6 RIGHT
No. 5 RIGHT
No. 4 RIGHT
No. 3 RIGHT
No. 2 RIGHT
No. 1 RIGHT
SLANT HDG
ROCK FAULT
FAULT
Dirty Coal
DIRTY FAULT COAL
DIRTY FAULTY COAL
BORE HOLE
SUB STATION
JOHN KALINA
Barn
House
Well
Shed
Spring

Map

B & H Coal Co.

Shade Twp, Somerset Co, Pa.

Scale 1" = 100'

▨ Mining Completed

☐ Proposed Mining from 7-1-68 to 7-1-69

FRANKLIN MILLER
ENGINEER
No. 5388

#121
6-1-99
C.C.