



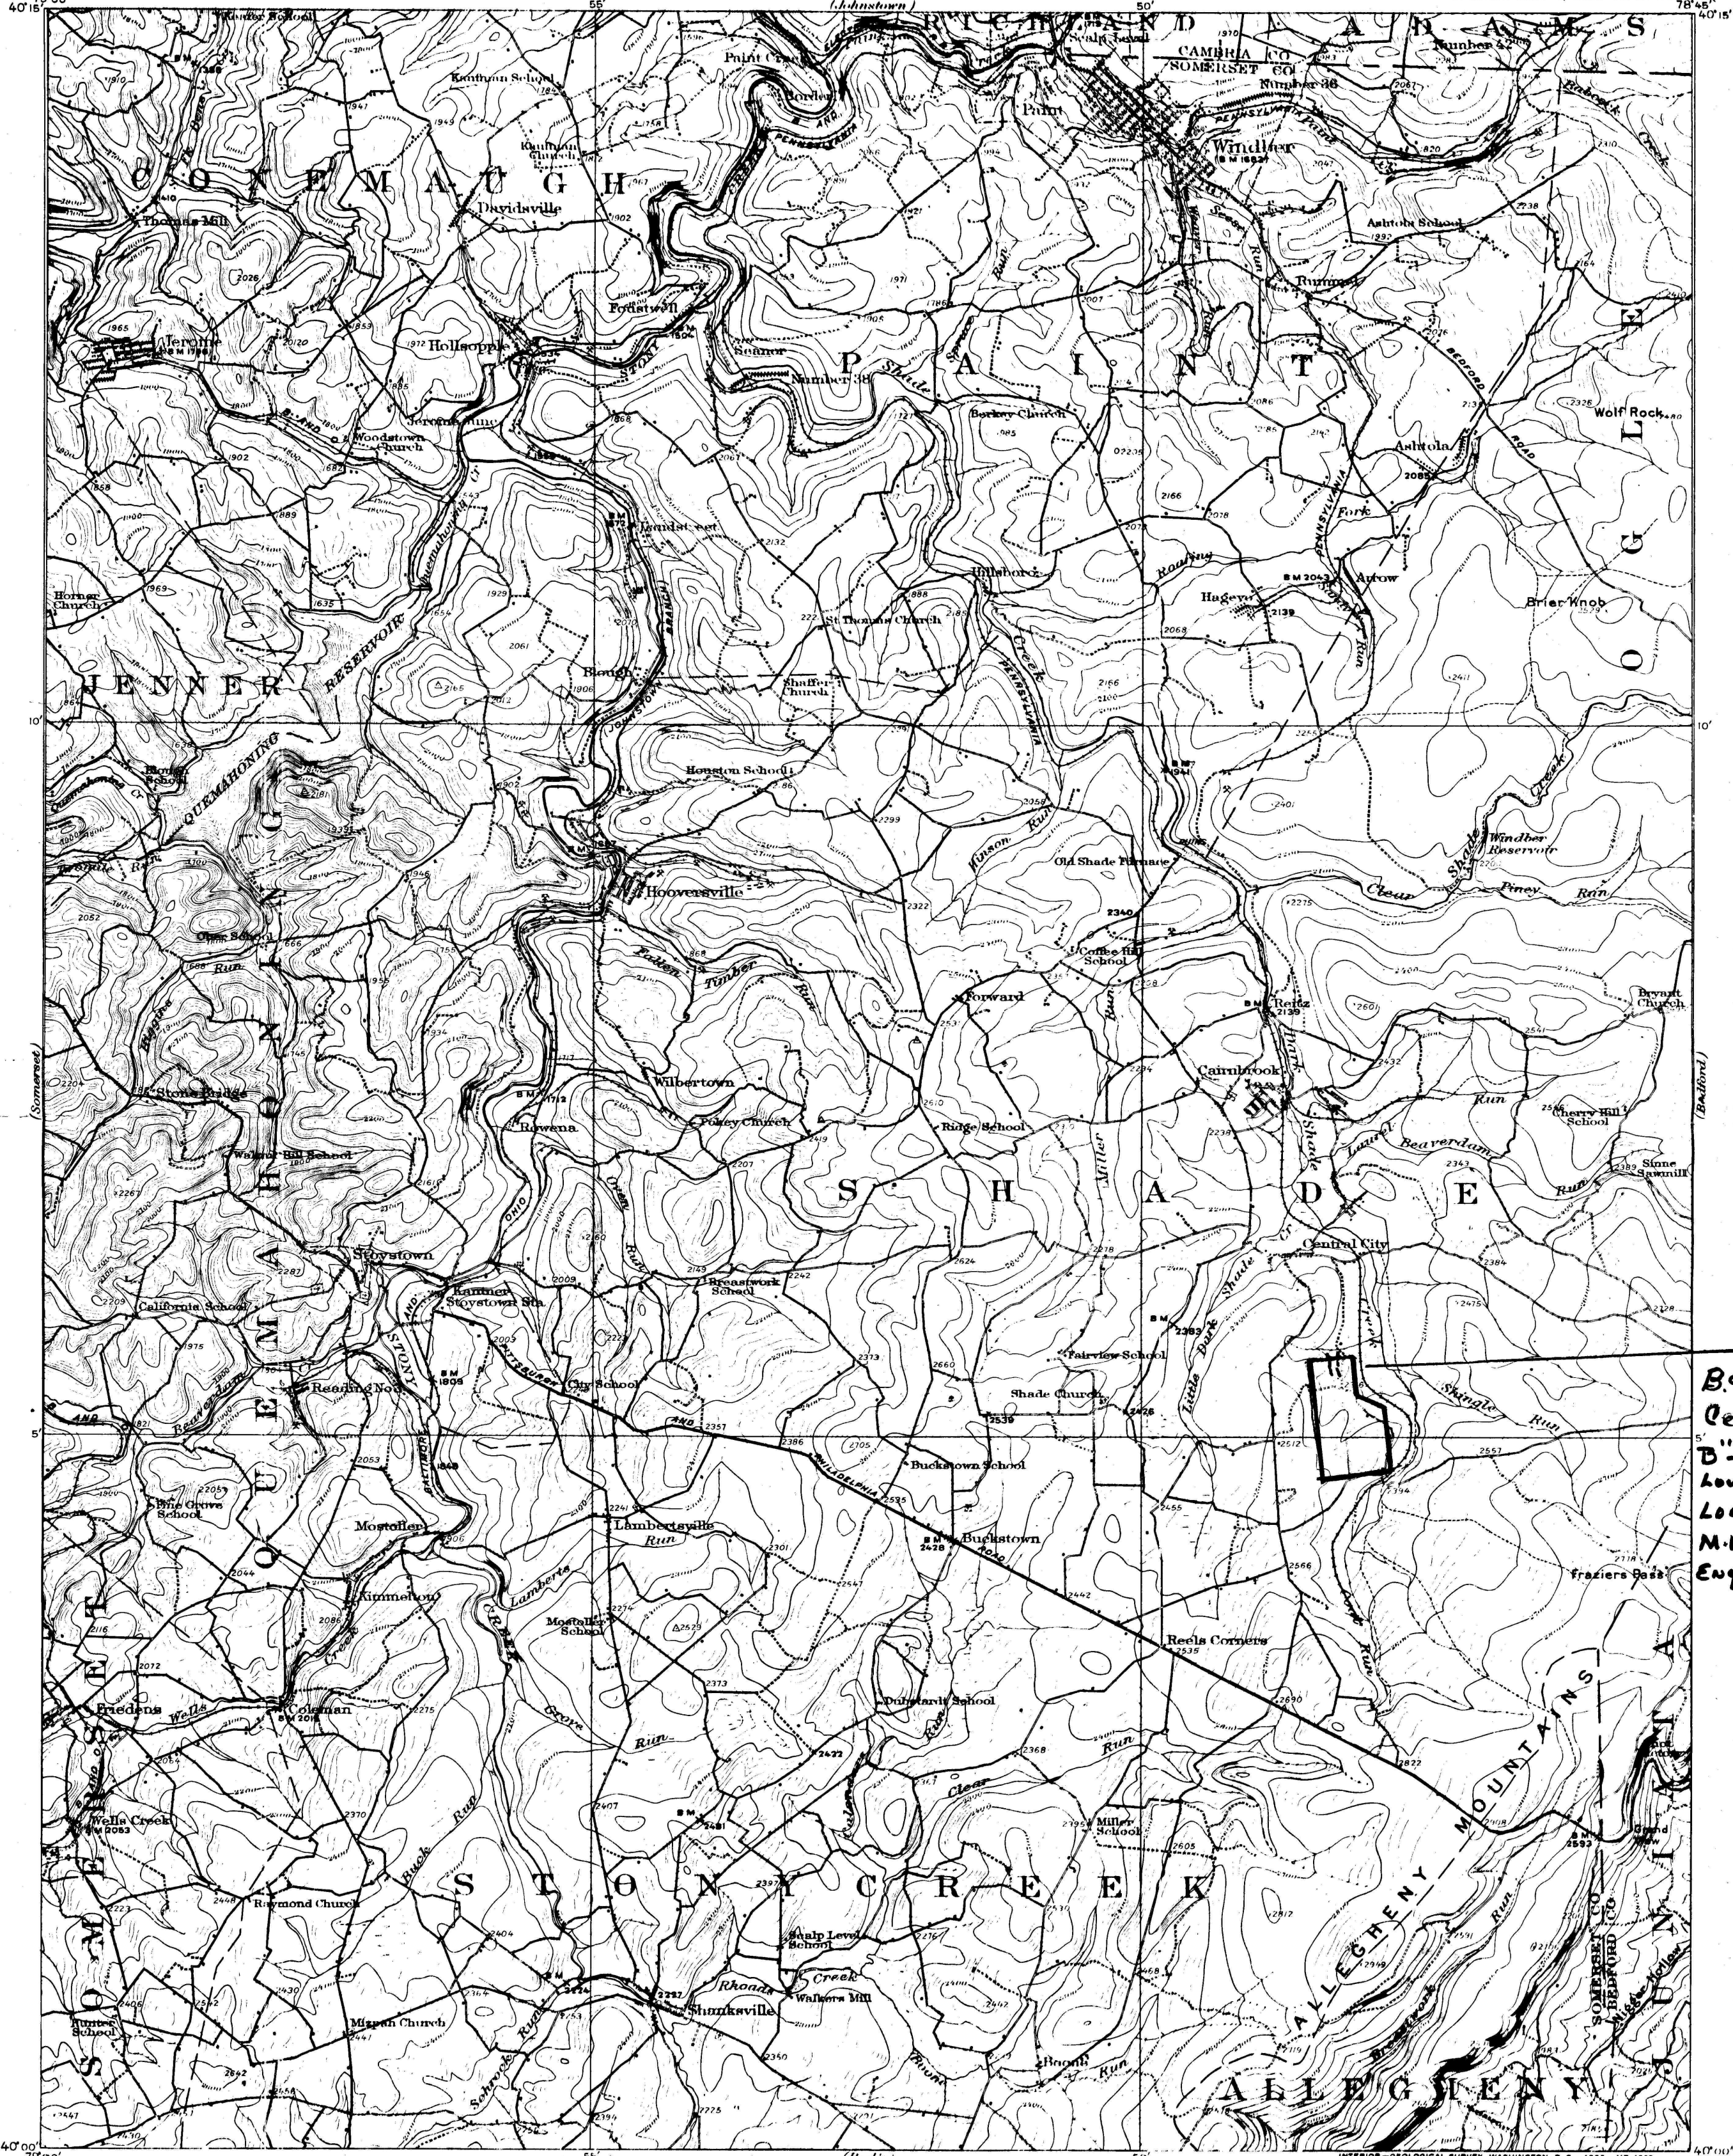

B & H. Coal Co.
Central City.
B's seam of Coal
Lower Kittanning
Located By
M.E. TREMEL
Eng. Reg. No.
13535

R.B. Marshall, Chief Geographer.
Frank Sutton, Geographer in charge.
Topography by Robert Muldrow, Oscar Jones,
E.E. Witherspoon, and E.D. Munroe.
Control by Geo.T. Hawkins and T.A. Green.
Surveyed in 1913-1914.

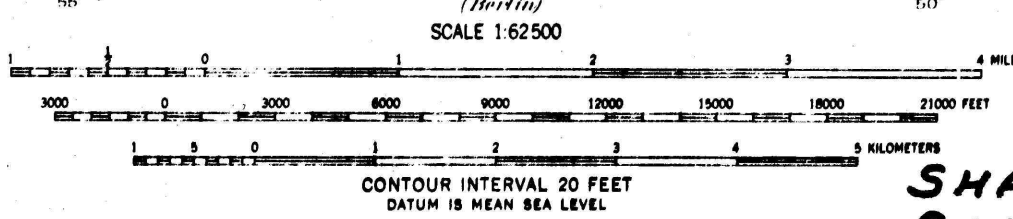

SHADE TOWNSHIP
SOMERSET COUNTY
PERMIT NUMBER - 246-1
"B"-OR LOWER KITTANNING SEAM

PA
WINDBER
N4000 W7445/15
1914