


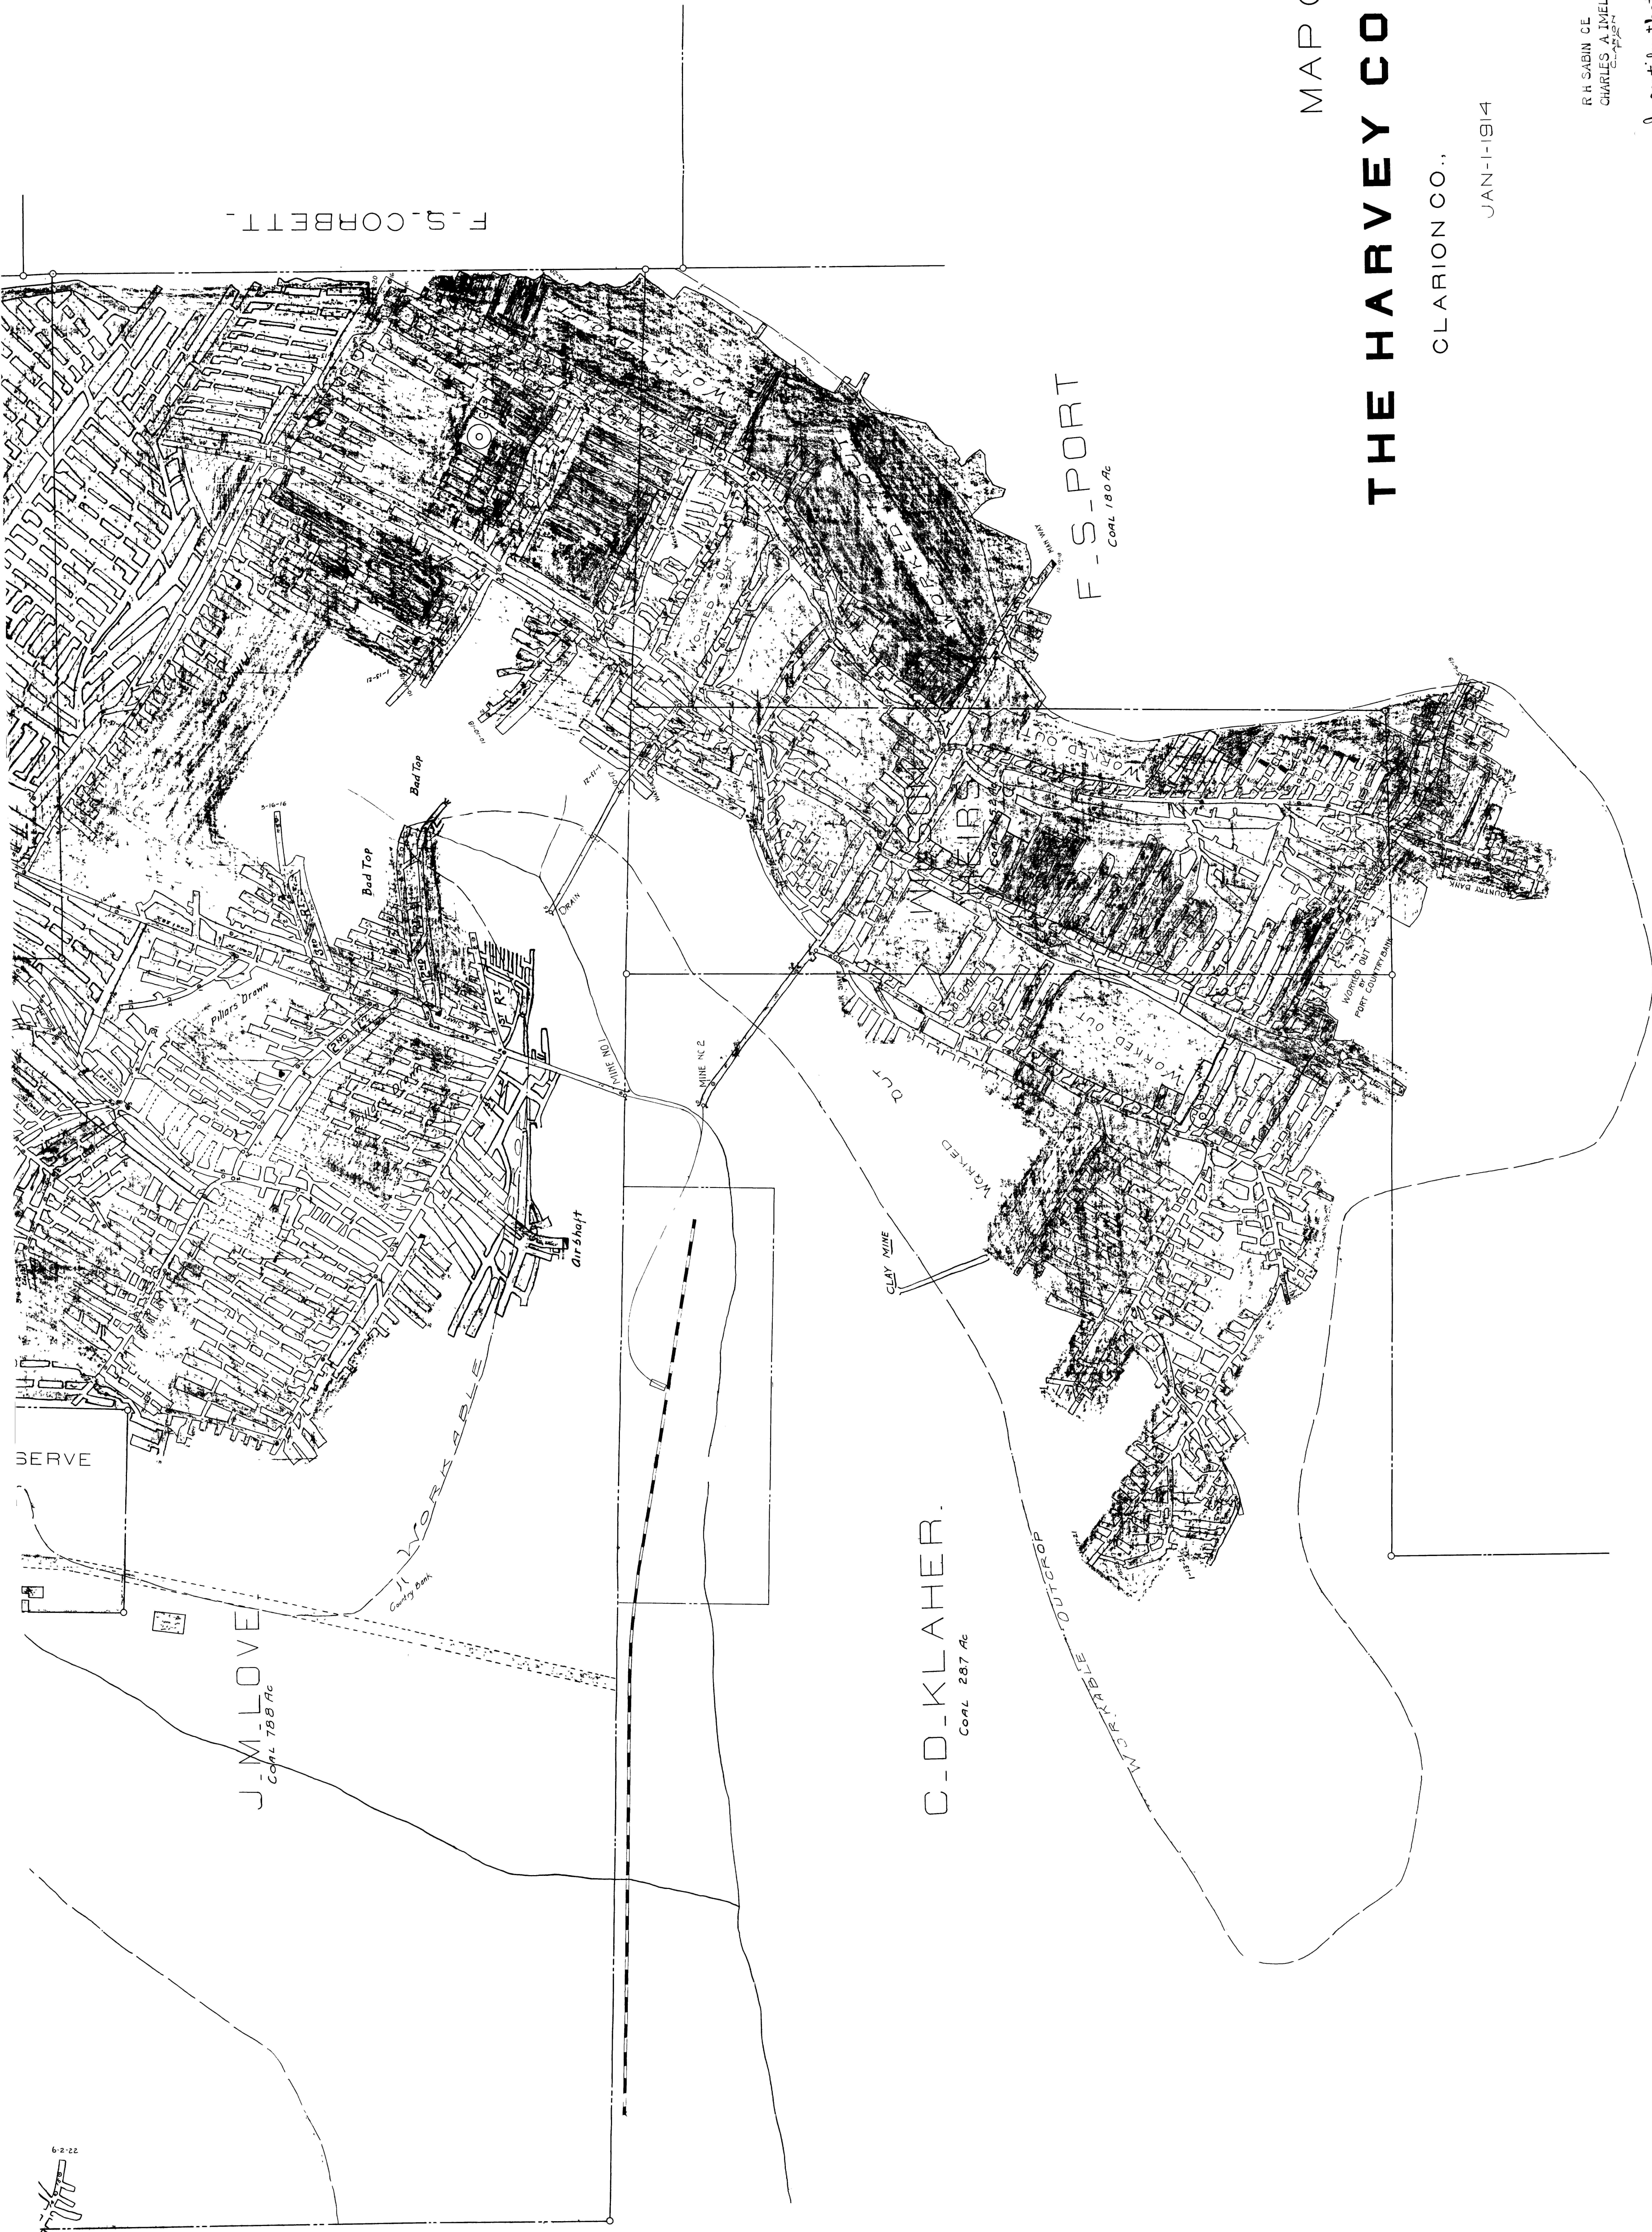

MAP OF

THE HARVEY COAL MINING CO.,

P E N N S Y L V A N I A

CLARION CO.,

JAN-1-1914

SCALE-1=100'

R H SABIN CE
CHARLES A IMEL CE
CLARION

I certify that this is a true and correct copy of the original mine map of this mine and is a complete and correct to the best of my knowledge and belief. This mine was abandoned October 25th 1935.

Harry J. Kinzel Reg. Engr. #147
Clarion Pa.