


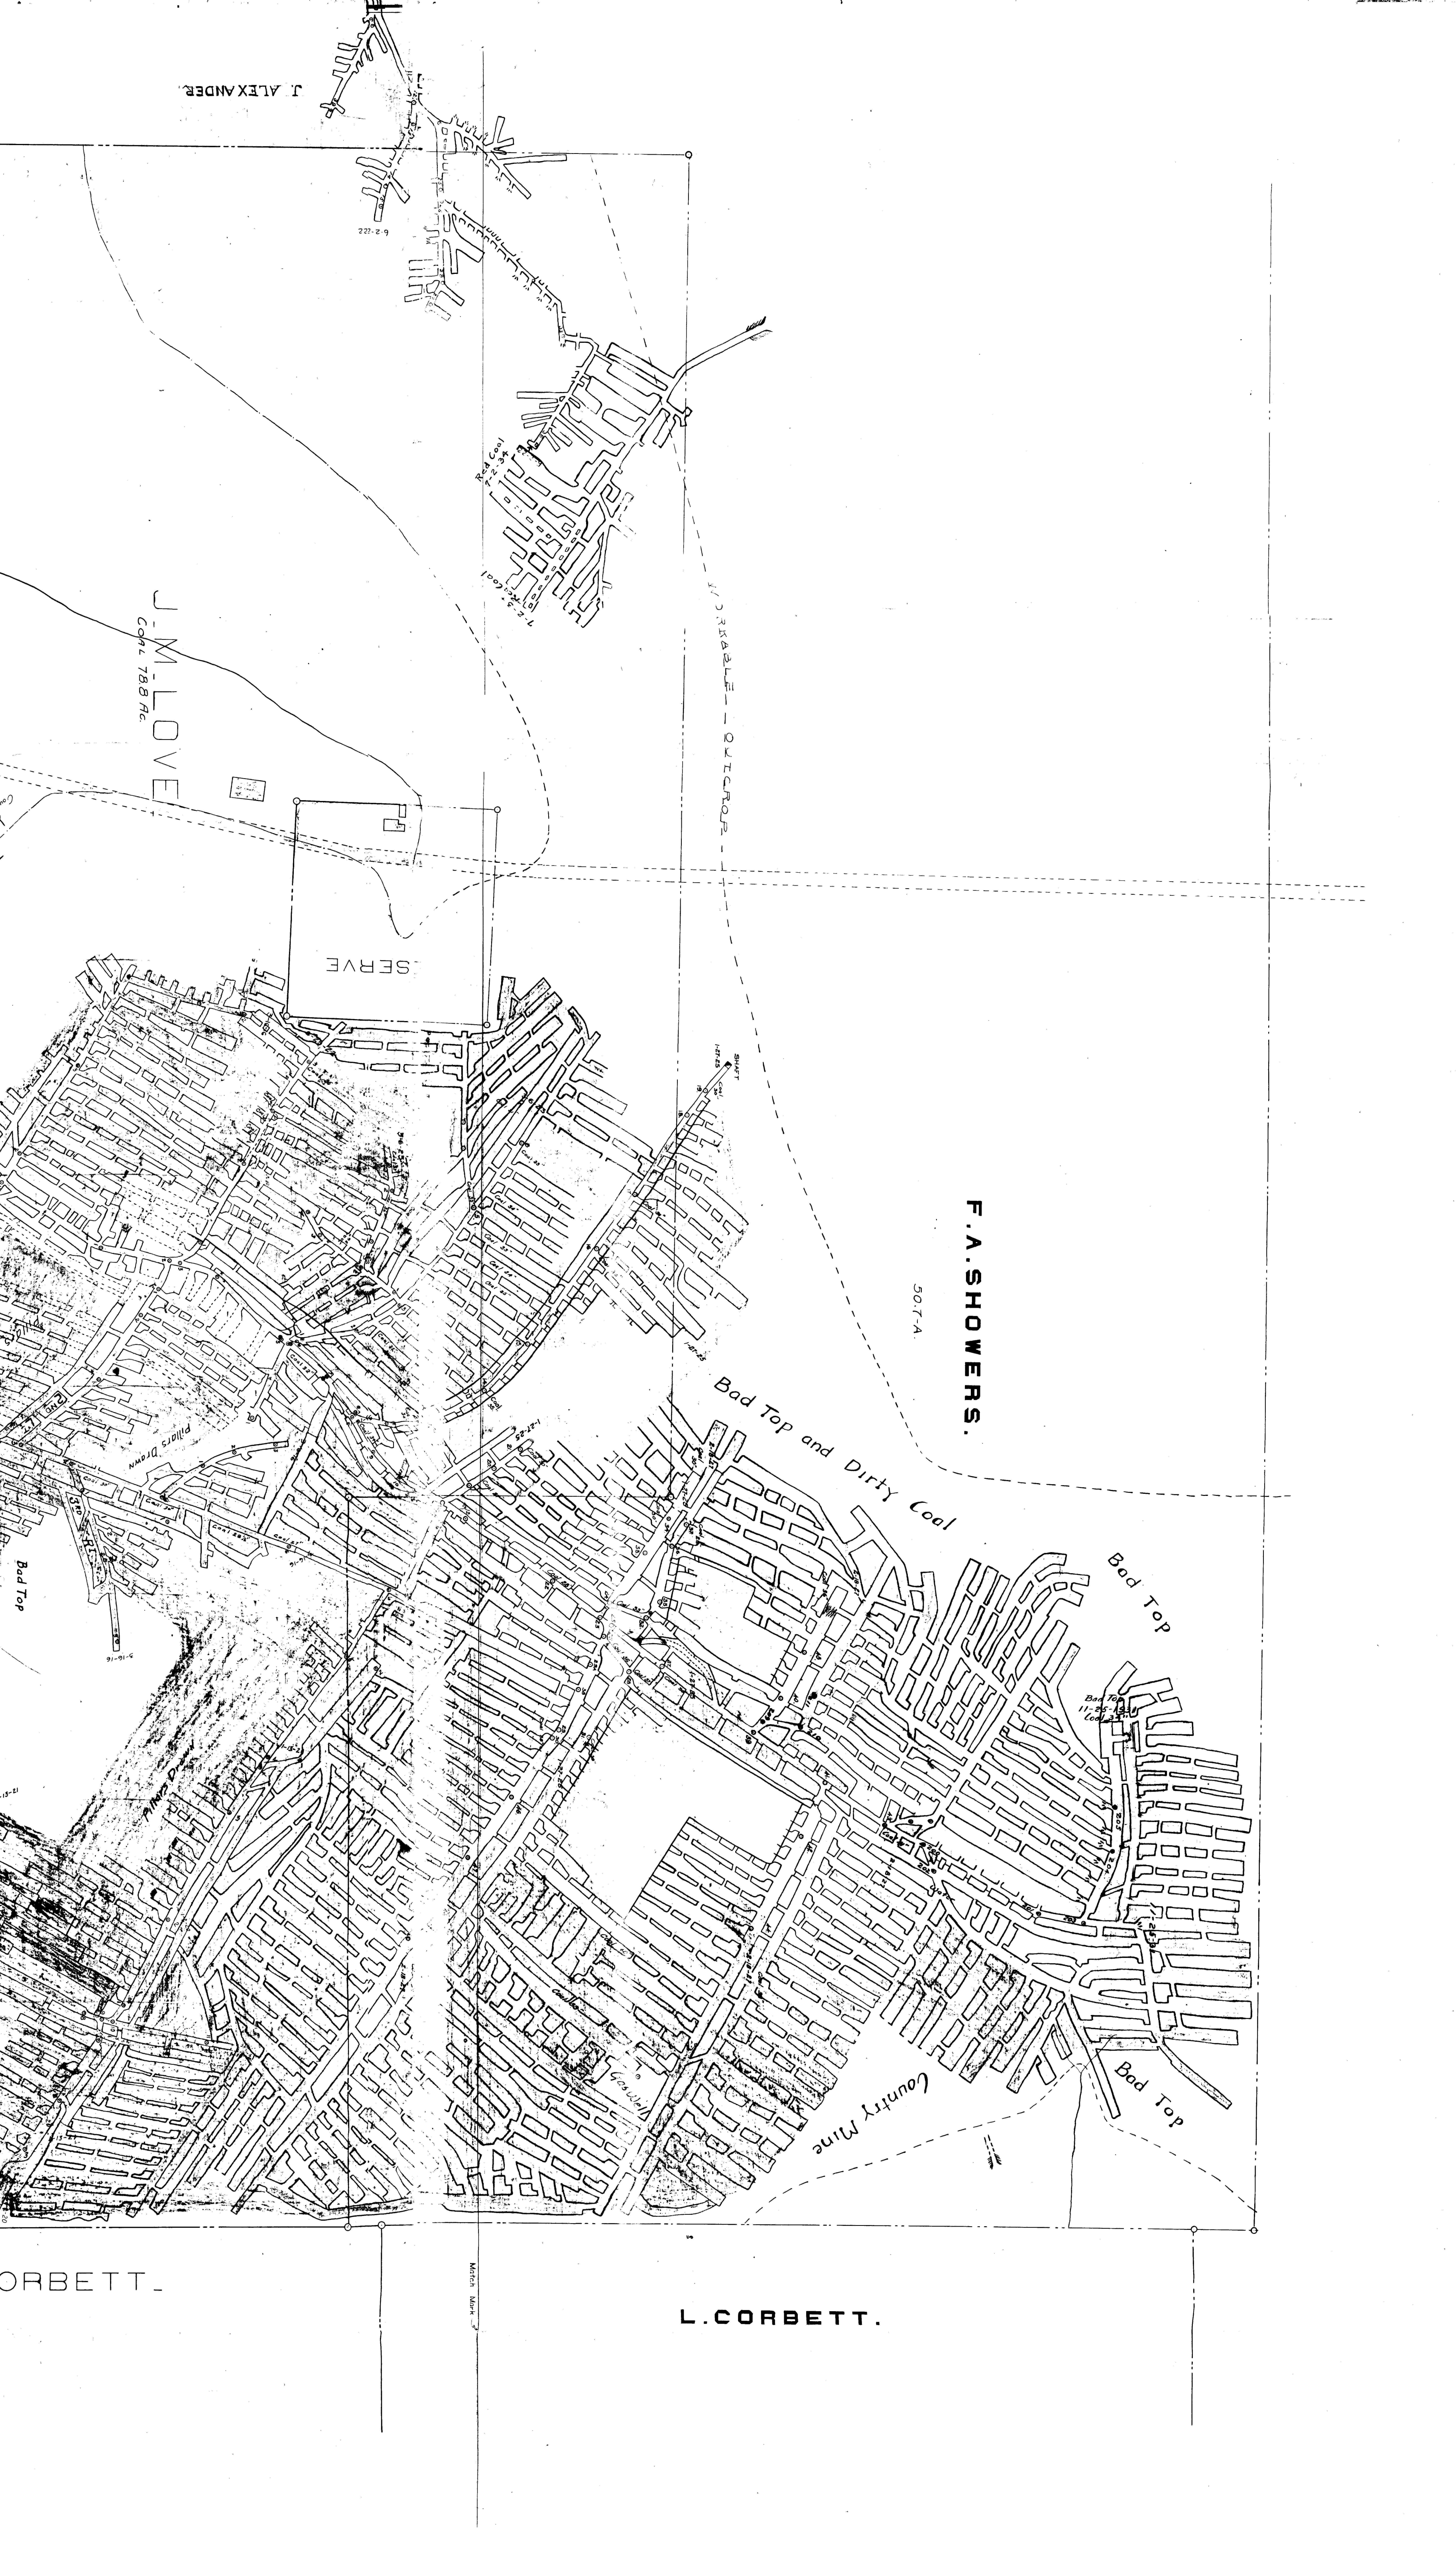

J. ALEXANDER

222-2-9

R. & C. Coal
7-2-3 Coal
7-2-4 Coal

SHUTT
1-12-25

J. M. LOVE
Coal 788 ft

SERVE

F. A. SHOWERS.
50-T-A

Bad Top and Dirty Coal

Bad Top

Bad Top
11-25-12
Coal 23 ft

Bad Top

Country Mine

Philips Drown

L. CORBETT.

MATCH MARK

ORBETT.