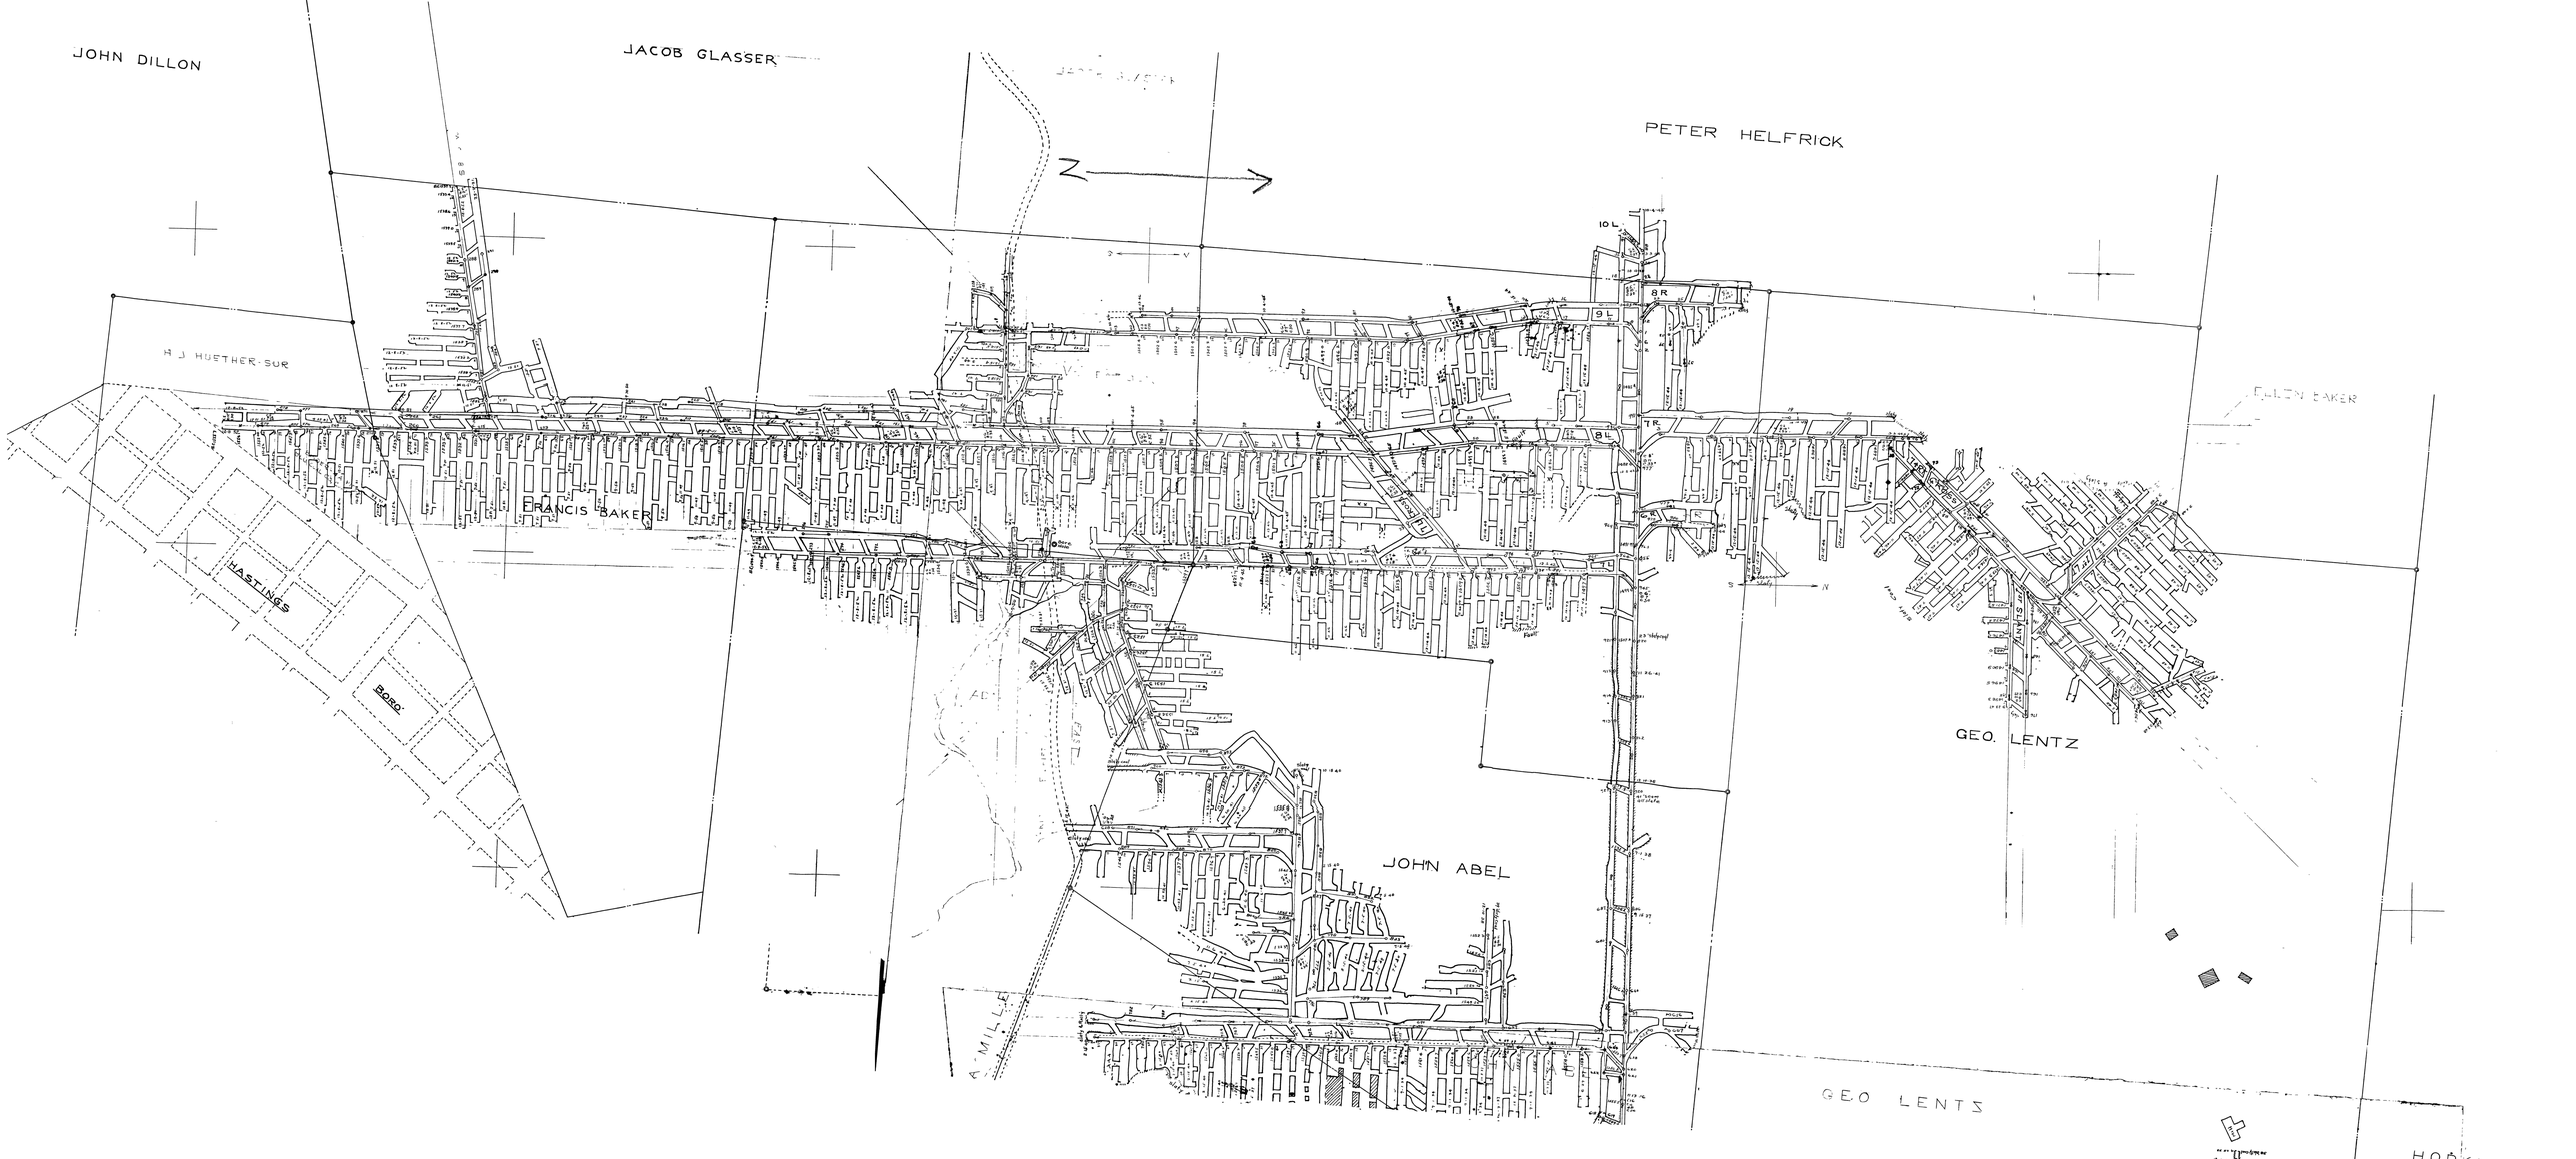
JOHN DILLON
JACOB GLASSER
PETER HELFRICK
H J HUETHER-SUR
FRANCIS BAKER
HASTINGS
BORO
JOHN ABEL
GEO. LENTZ
GEO LENTS
A. MILLER
10 L
8 R
9 L
8 L
7 R