
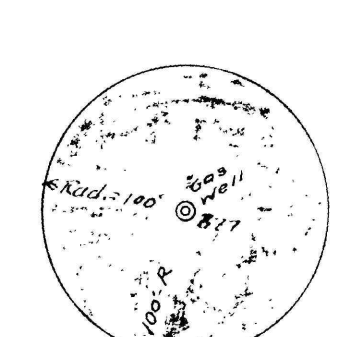


SURVEY  
NEW 1910 1912  
OLD 1910 1912  

WALLWORK CO.  
LANDS & MINES  
RED BANK TWP. CLARION CO. PA.  
SCALE 1"=100'  
FILE 1002-522

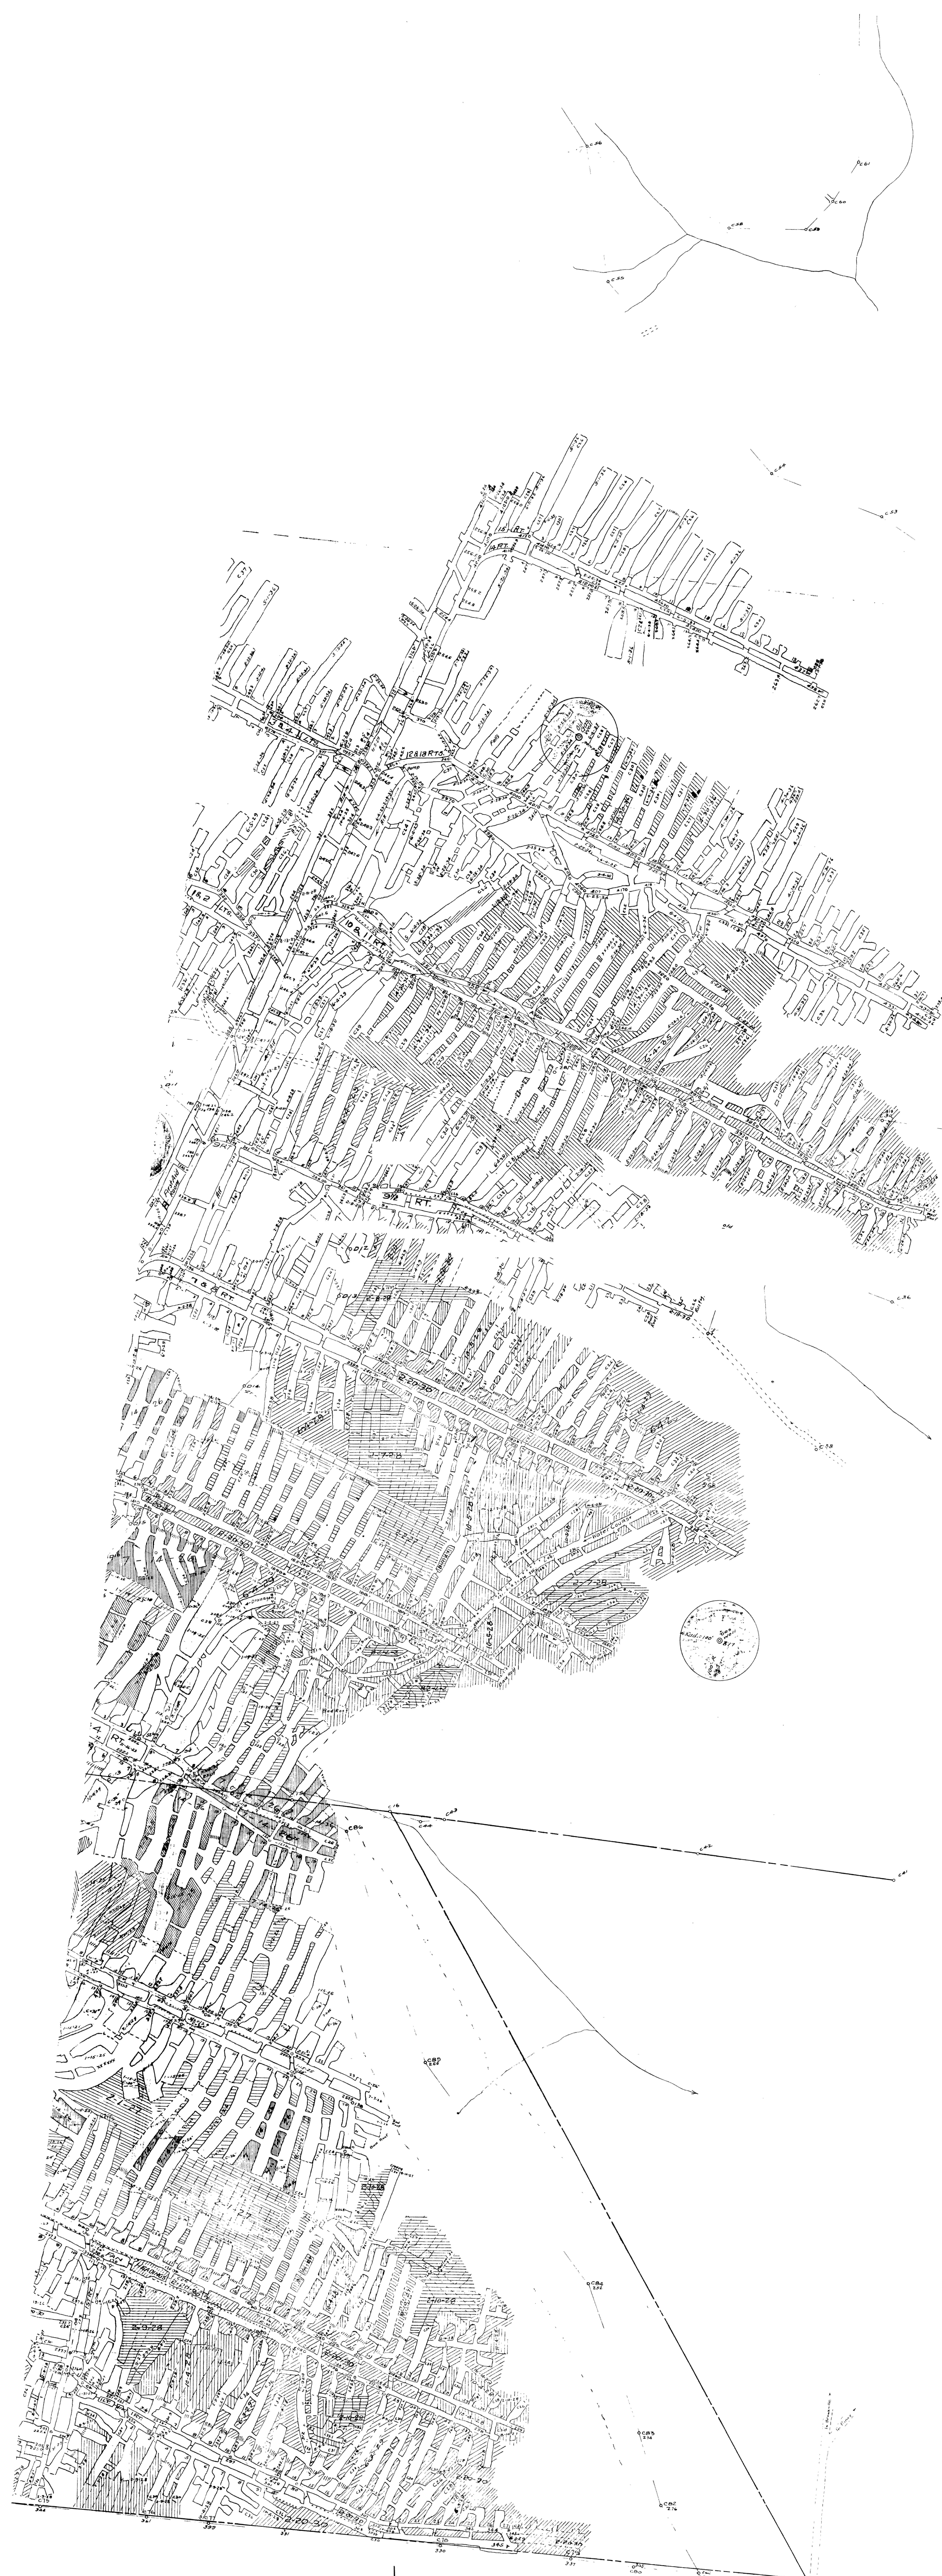

# WALLWORK COAL CO. LANDS & MINES IN RED BANK TWP., CLARION CO., PA.

OFFICE OF  
E. W. Hess, Reg. Engr. & Land Surveyor  
DuBois, Pa.

SURVEYED:  
APR 10-15 1923  
REVISED:  
APR 10-15 1924  

N.B.-116-106-124  
T.B. No 4-NF1  
FILE 1002-522  
SHEET 1