


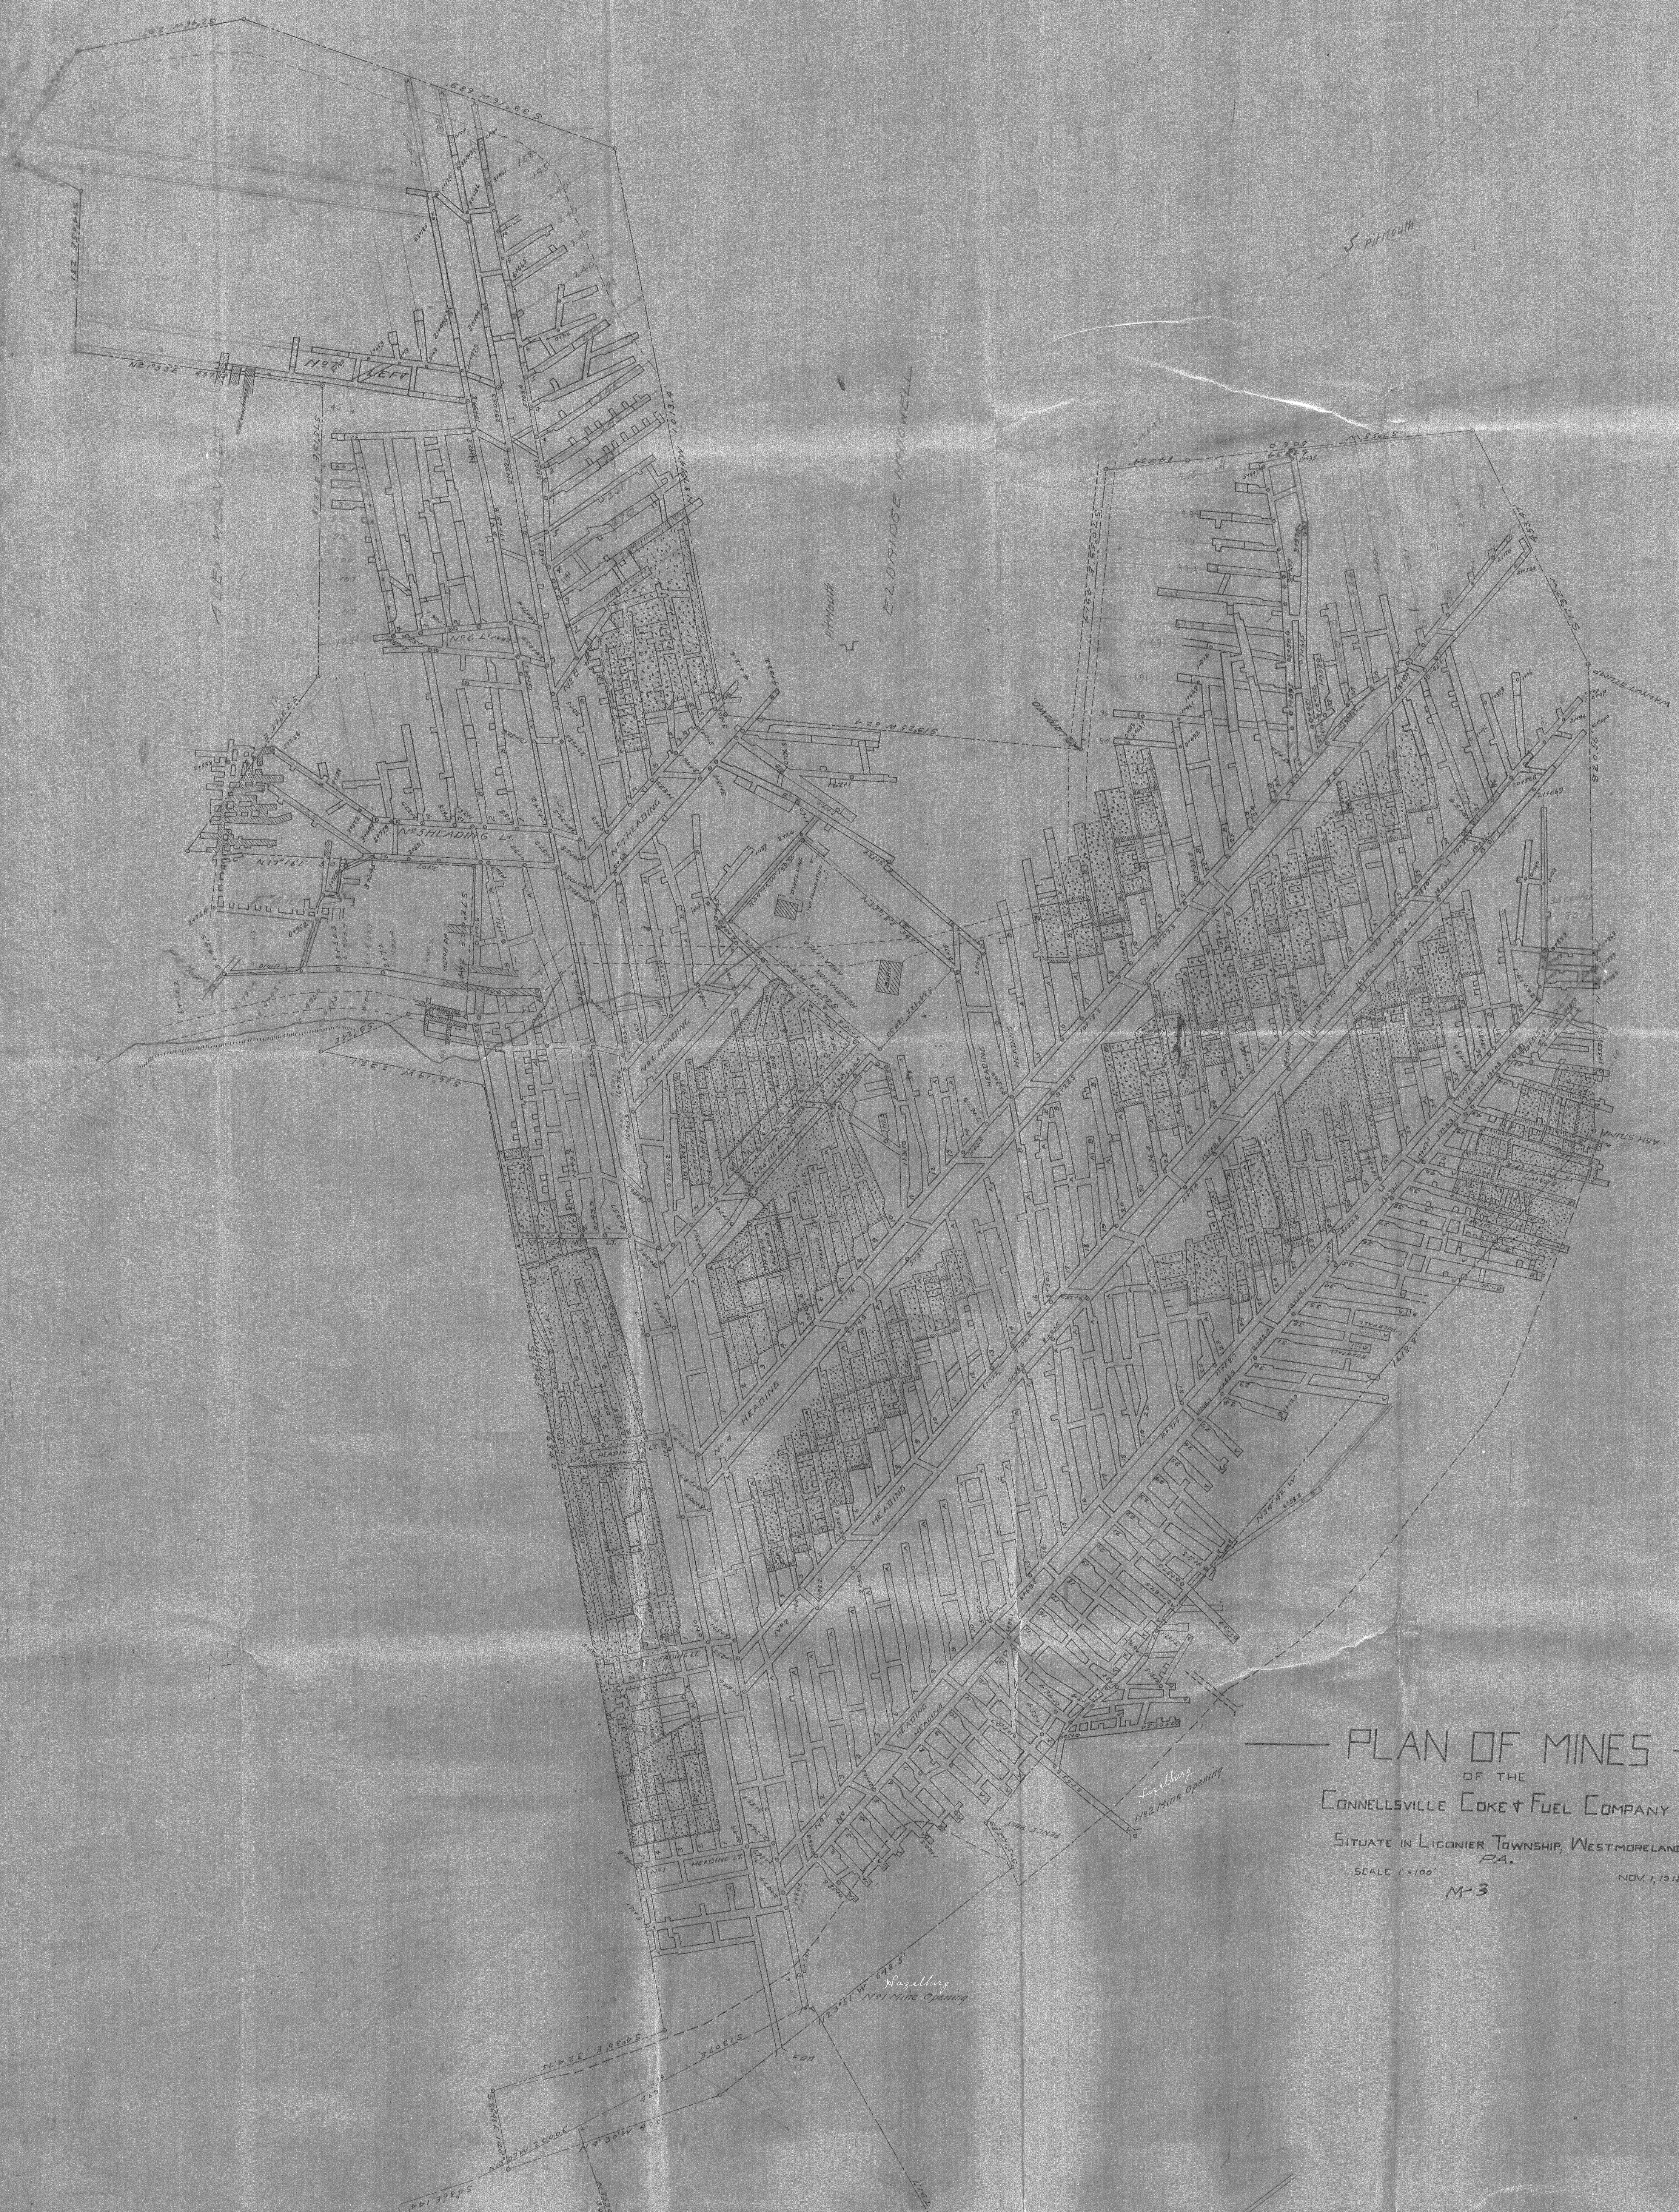

PLAN OF MINES
OF THE
CONNELLVILLE COKE & FUEL COMPANY
SITUATE IN LIGONIER TOWNSHIP, WESTMORELAND CO.
PA.
SCALE 1"=100'
NOV. 1, 1918
M-3