


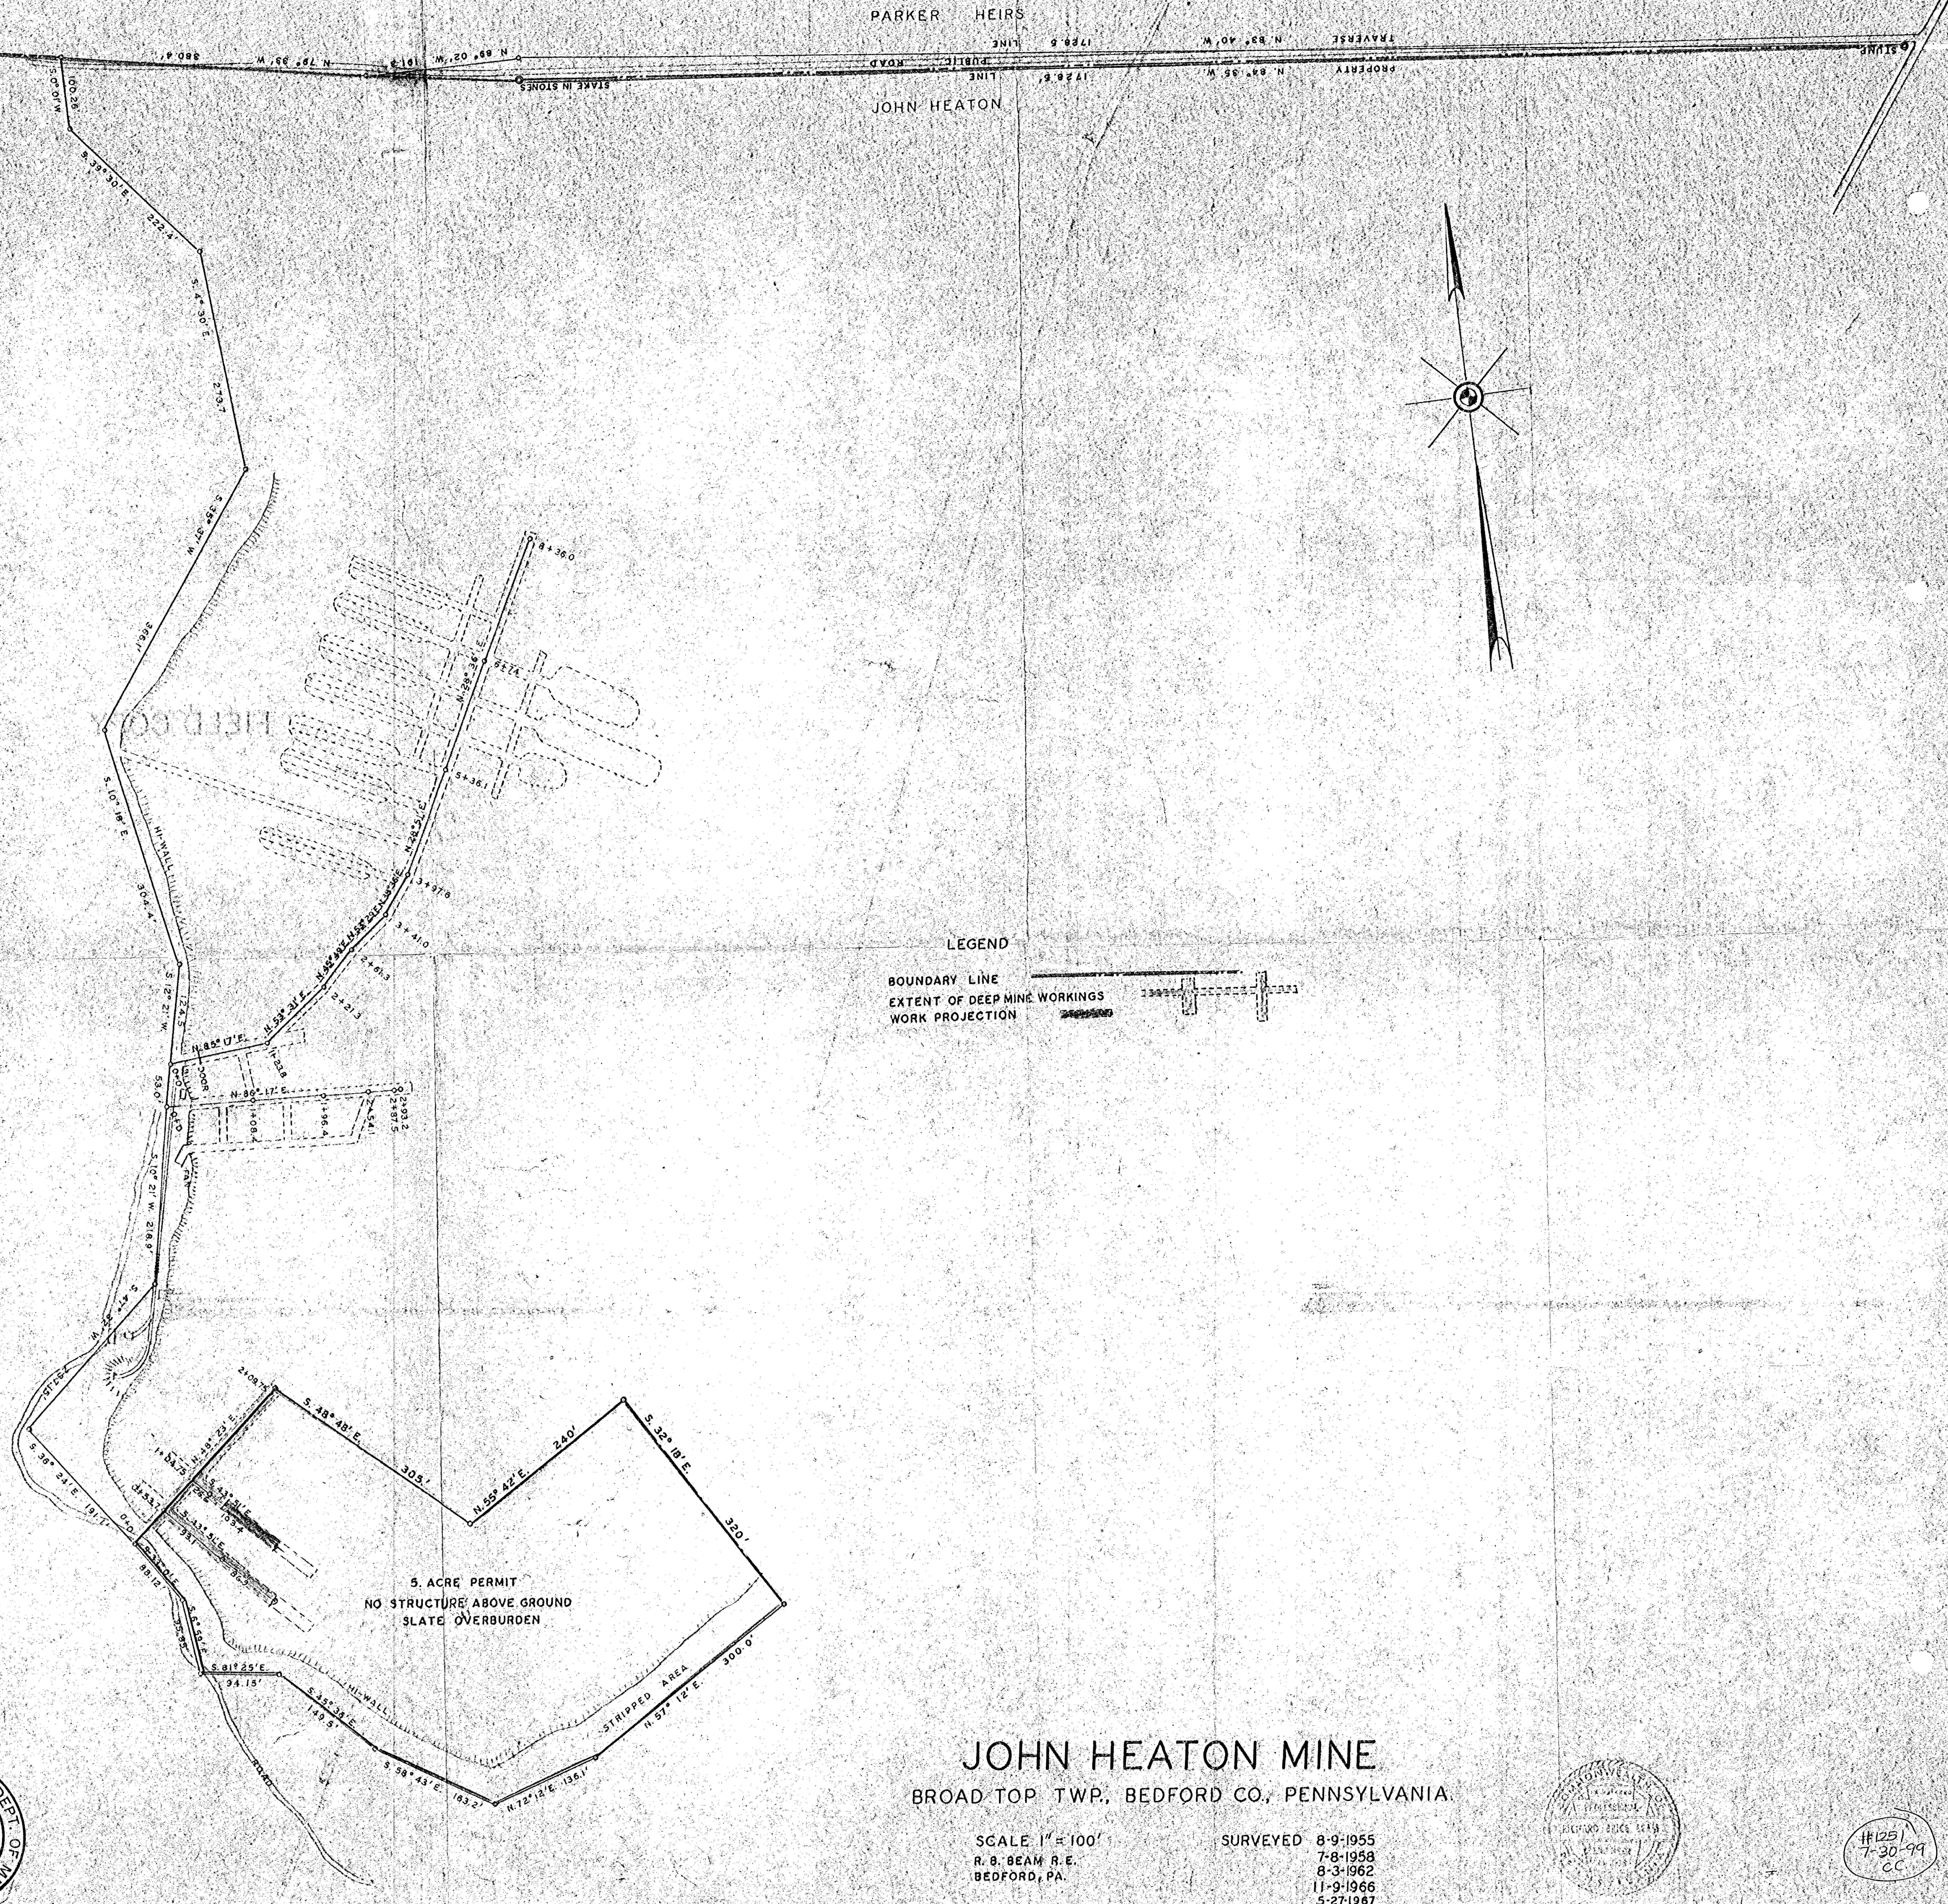


PARKER HEIRS
JOHN HEATON

LEGEND

BOUNDARY LINE
EXTENT OF DEEP MINE WORKINGS
WORK PROJECTION

JOHN HEATON MINE
BROAD TOP TWP., BEDFORD CO., PENNSYLVANIA.

SCALE 1" = 100'
R. B. BEAM R. E.
BEDFORD, PA.
SURVEYED 8-9-1955
7-8-1958
8-3-1962
11-9-1966
5-27-1967
12-15-1967 NO ADVANCE 12-31-1968

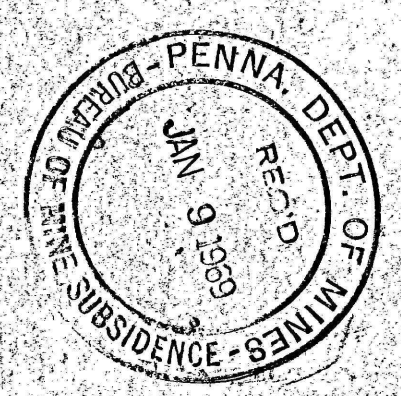

#125
7-30-99
CC