


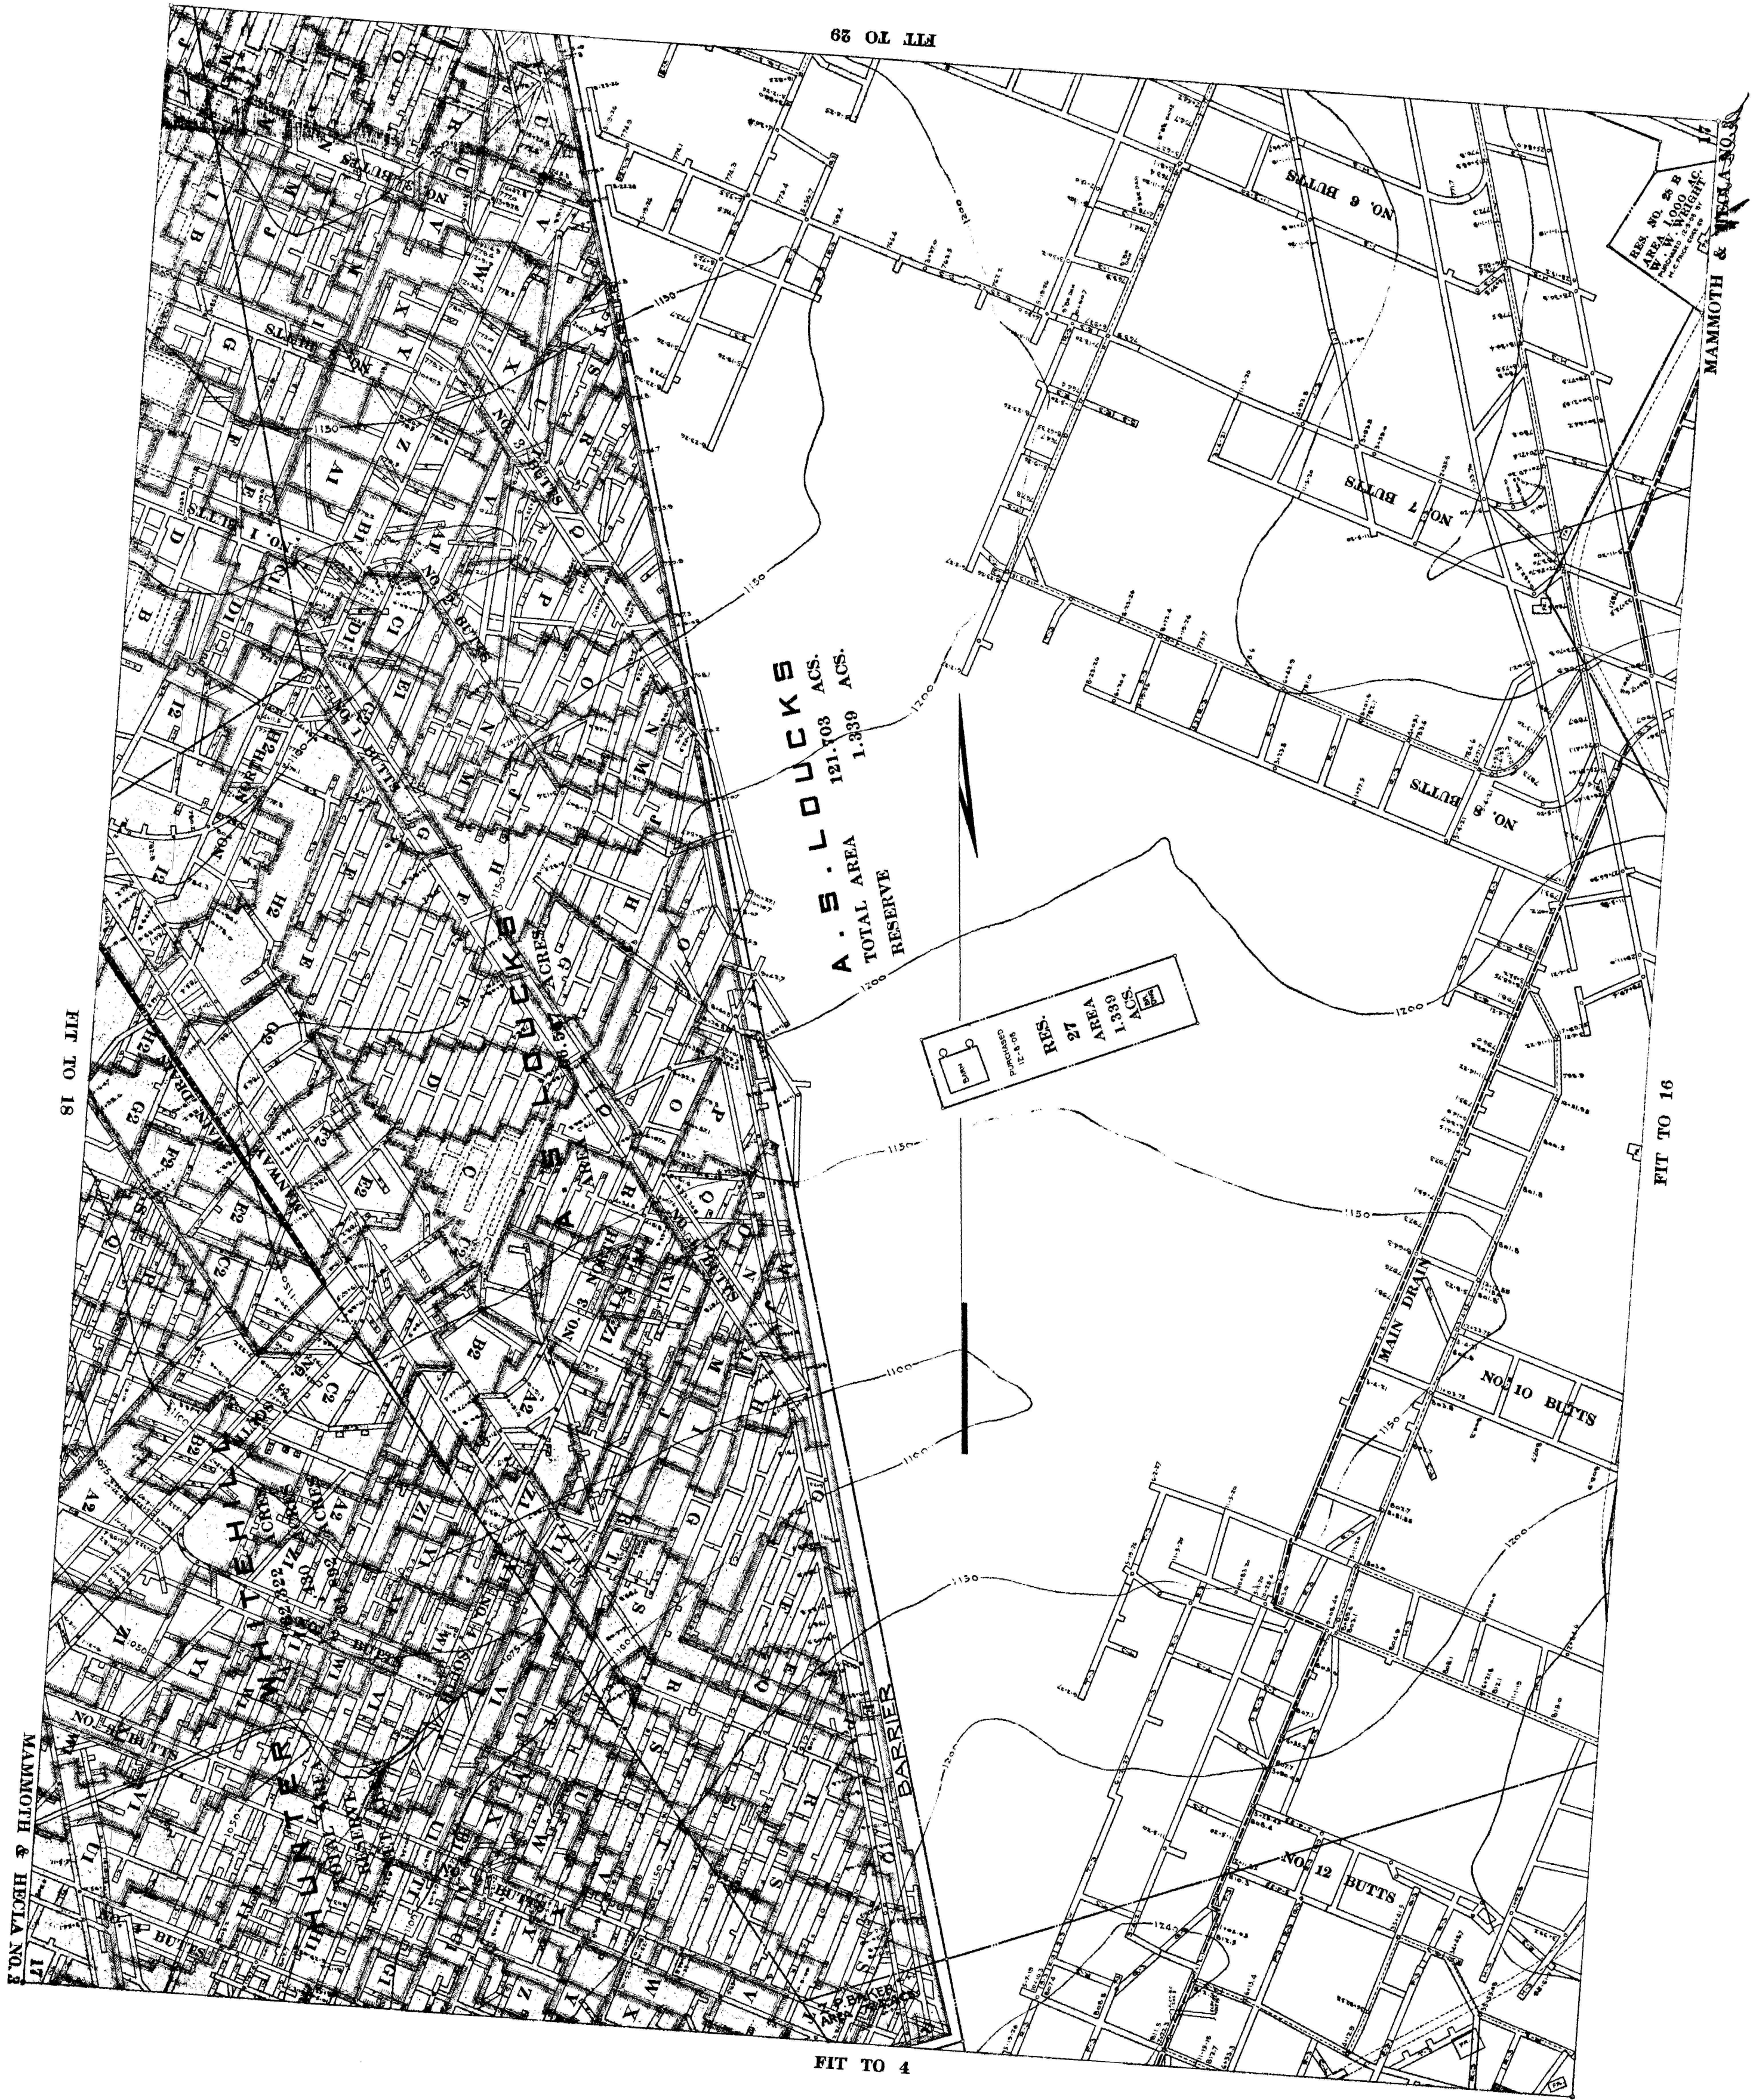

A. S. LOUCKS
TOTAL AREA 121.703 ACS.
RESERVE 1.339 ACS.

RES. 27
AREA 1.339 ACS.

FIT TO 18

FIT TO 16

FIT TO 4

MAMMOTH & HECLA NO. 3

MAMMOTH & HECLA NO. 17