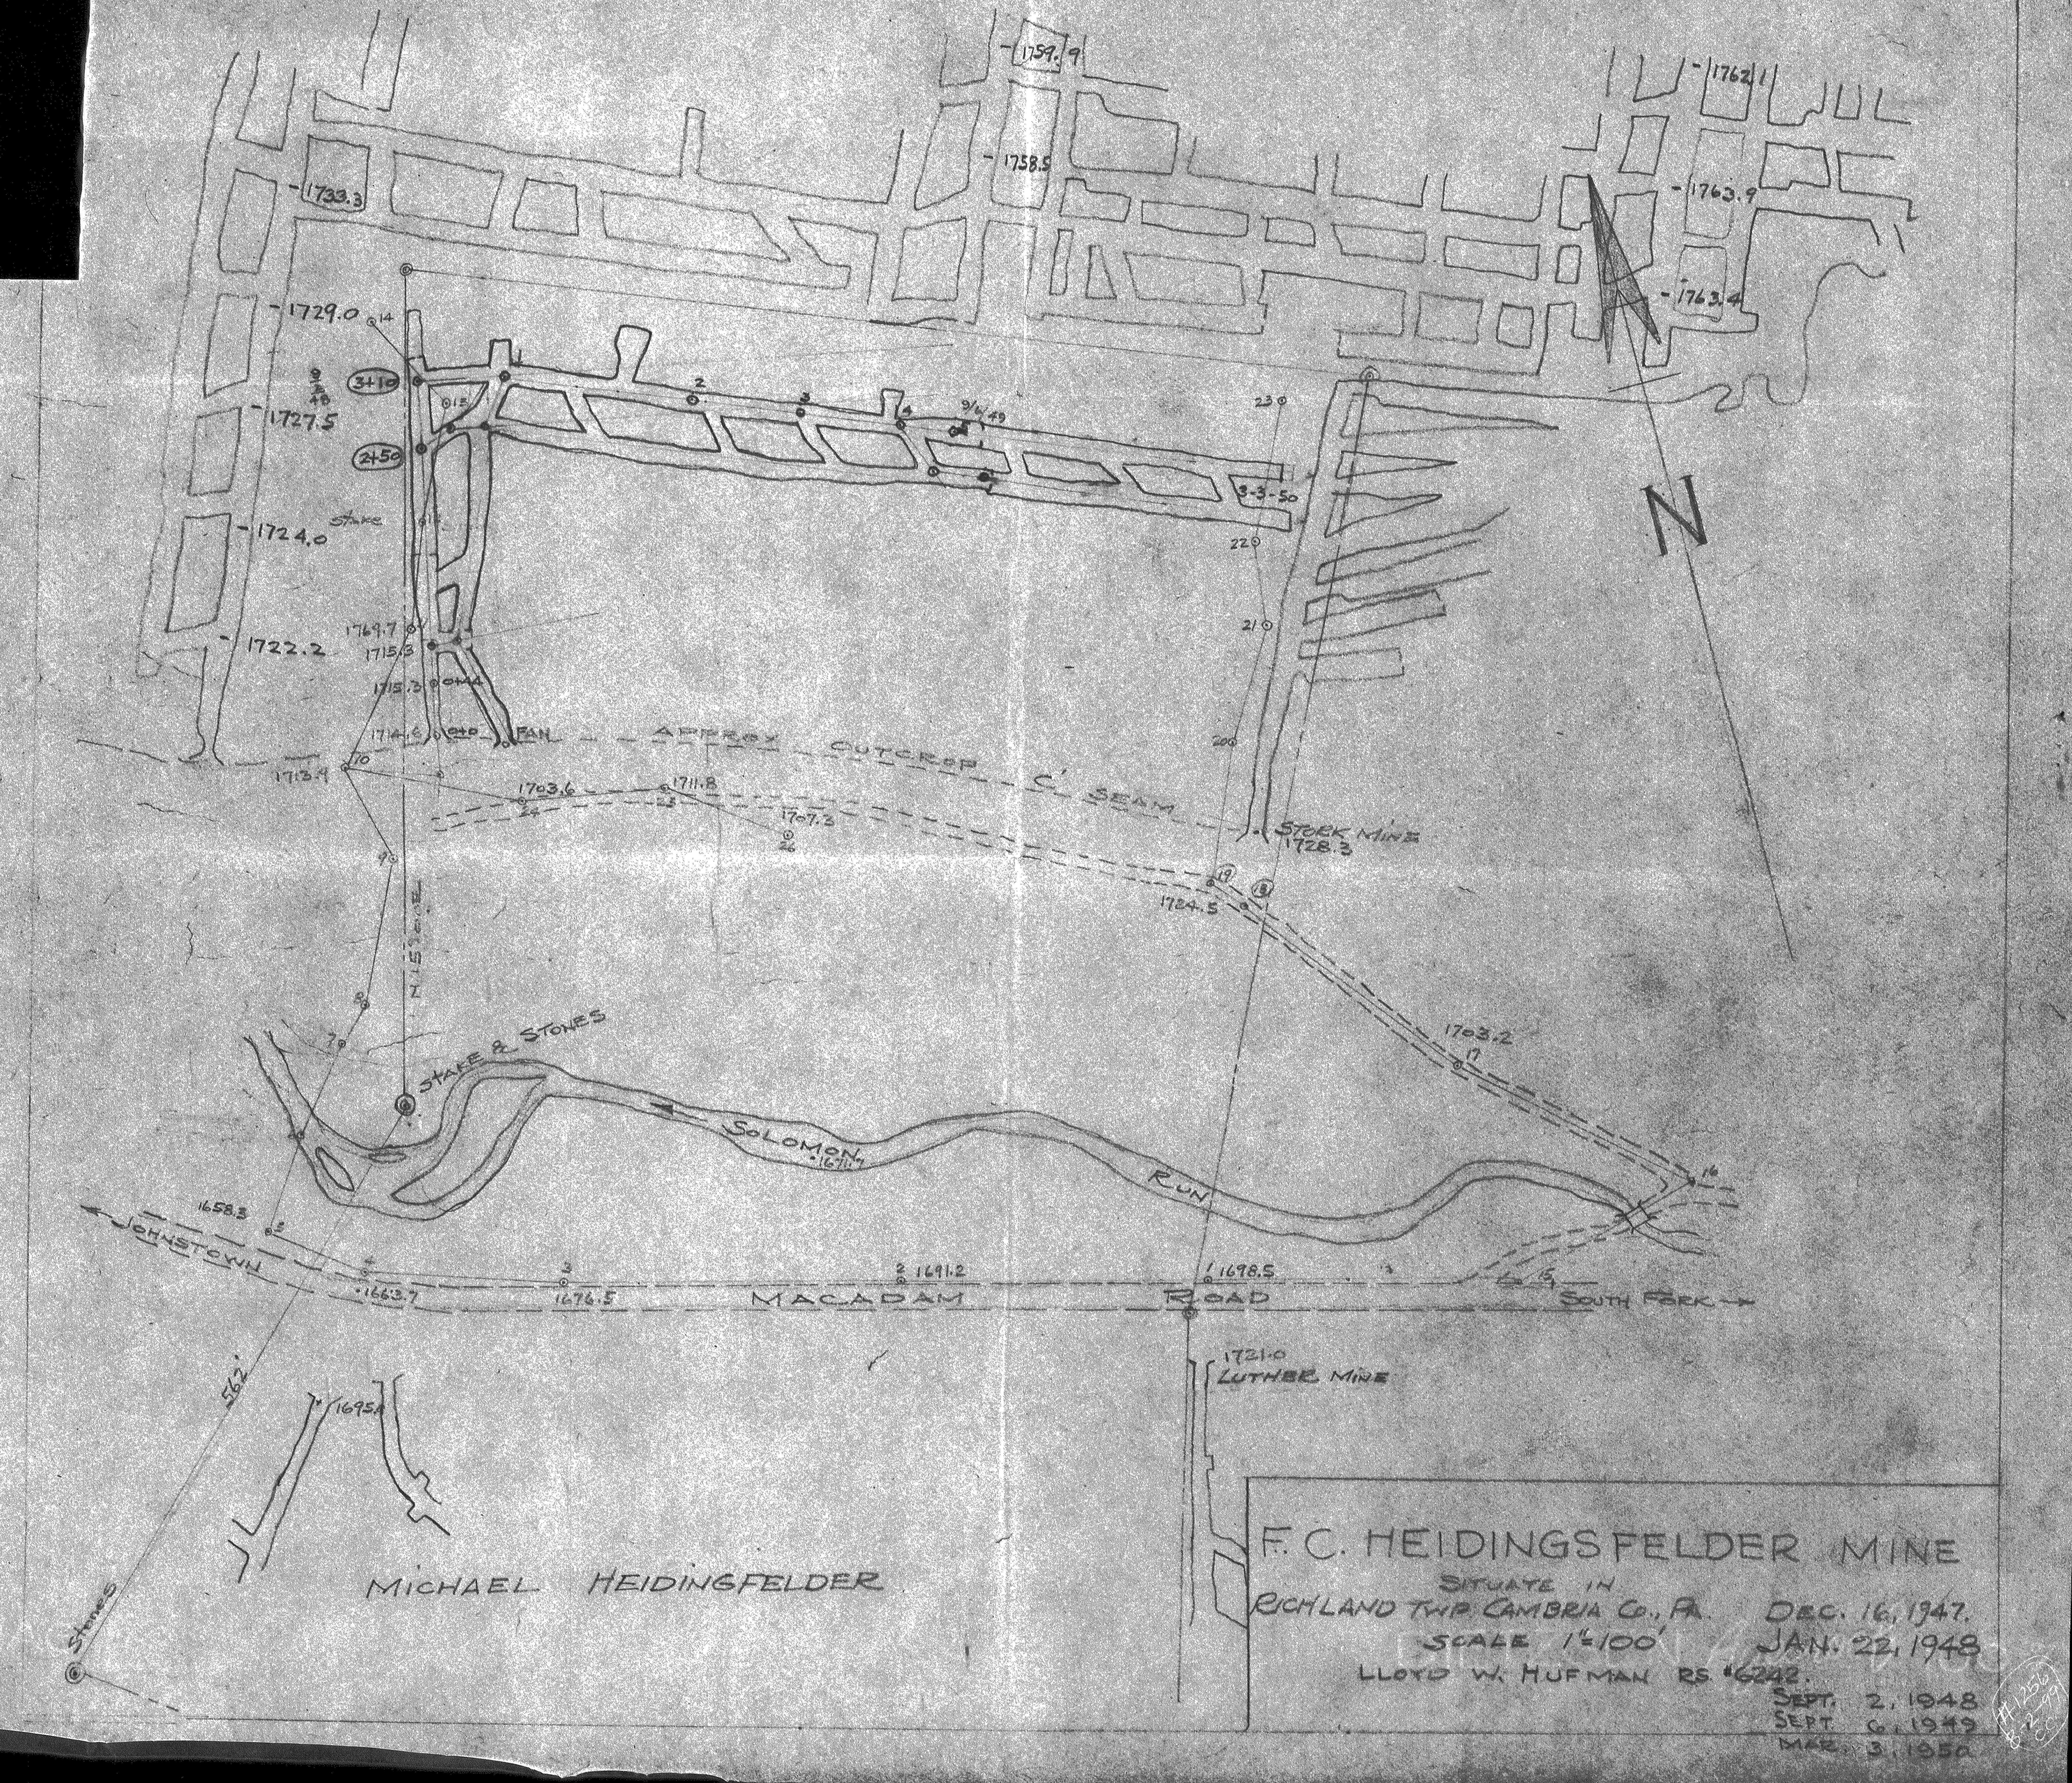

# F.C. HEIDINGSFELDER MINE

SITUATE IN
RICHLAND TWP. CAMBRIA CO., PA.
SCALE 1"=100'
LLOYD W. HUFMAN R.S. #6242.

DEC. 16, 1947.
JAN. 22, 1948
SEPT. 2, 1948
SEPT. 6, 1949
MAR. 3, 1950

#1256
8-2-99
CC