



#125
6-1-99
C.C.

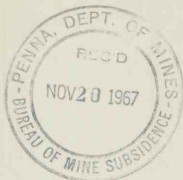



FIELD COPY

RAYMOND BACHELIER
GRAMPAN, PA. R.D.
MAP OF MINE
FERGUSON TWP., CLFD. CO., PA.
SCALE 1"=100'
CLEARFIELD, PA. ROY C. KINDIG
OCT 7 1966 REG. ENGR.
Revised Lex W. Curry
Nov. 17, 1967 Reg. Surveyor

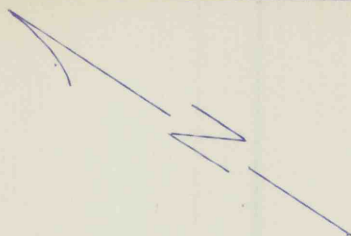

JOHN MCKEAG

OLD WORKINGS

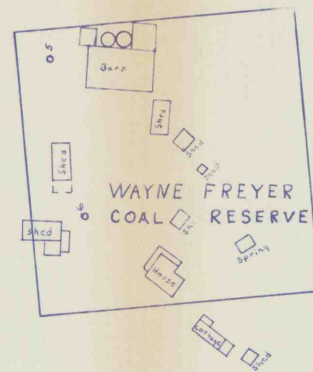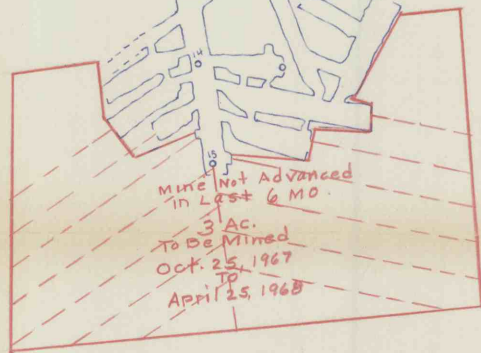

WAYNE FREYER

NOW OR FORMERLY
MAHAFFEY FERGUSON

WAYNE FREYER (SURF)
G. B. C. CORP. (COAL)