


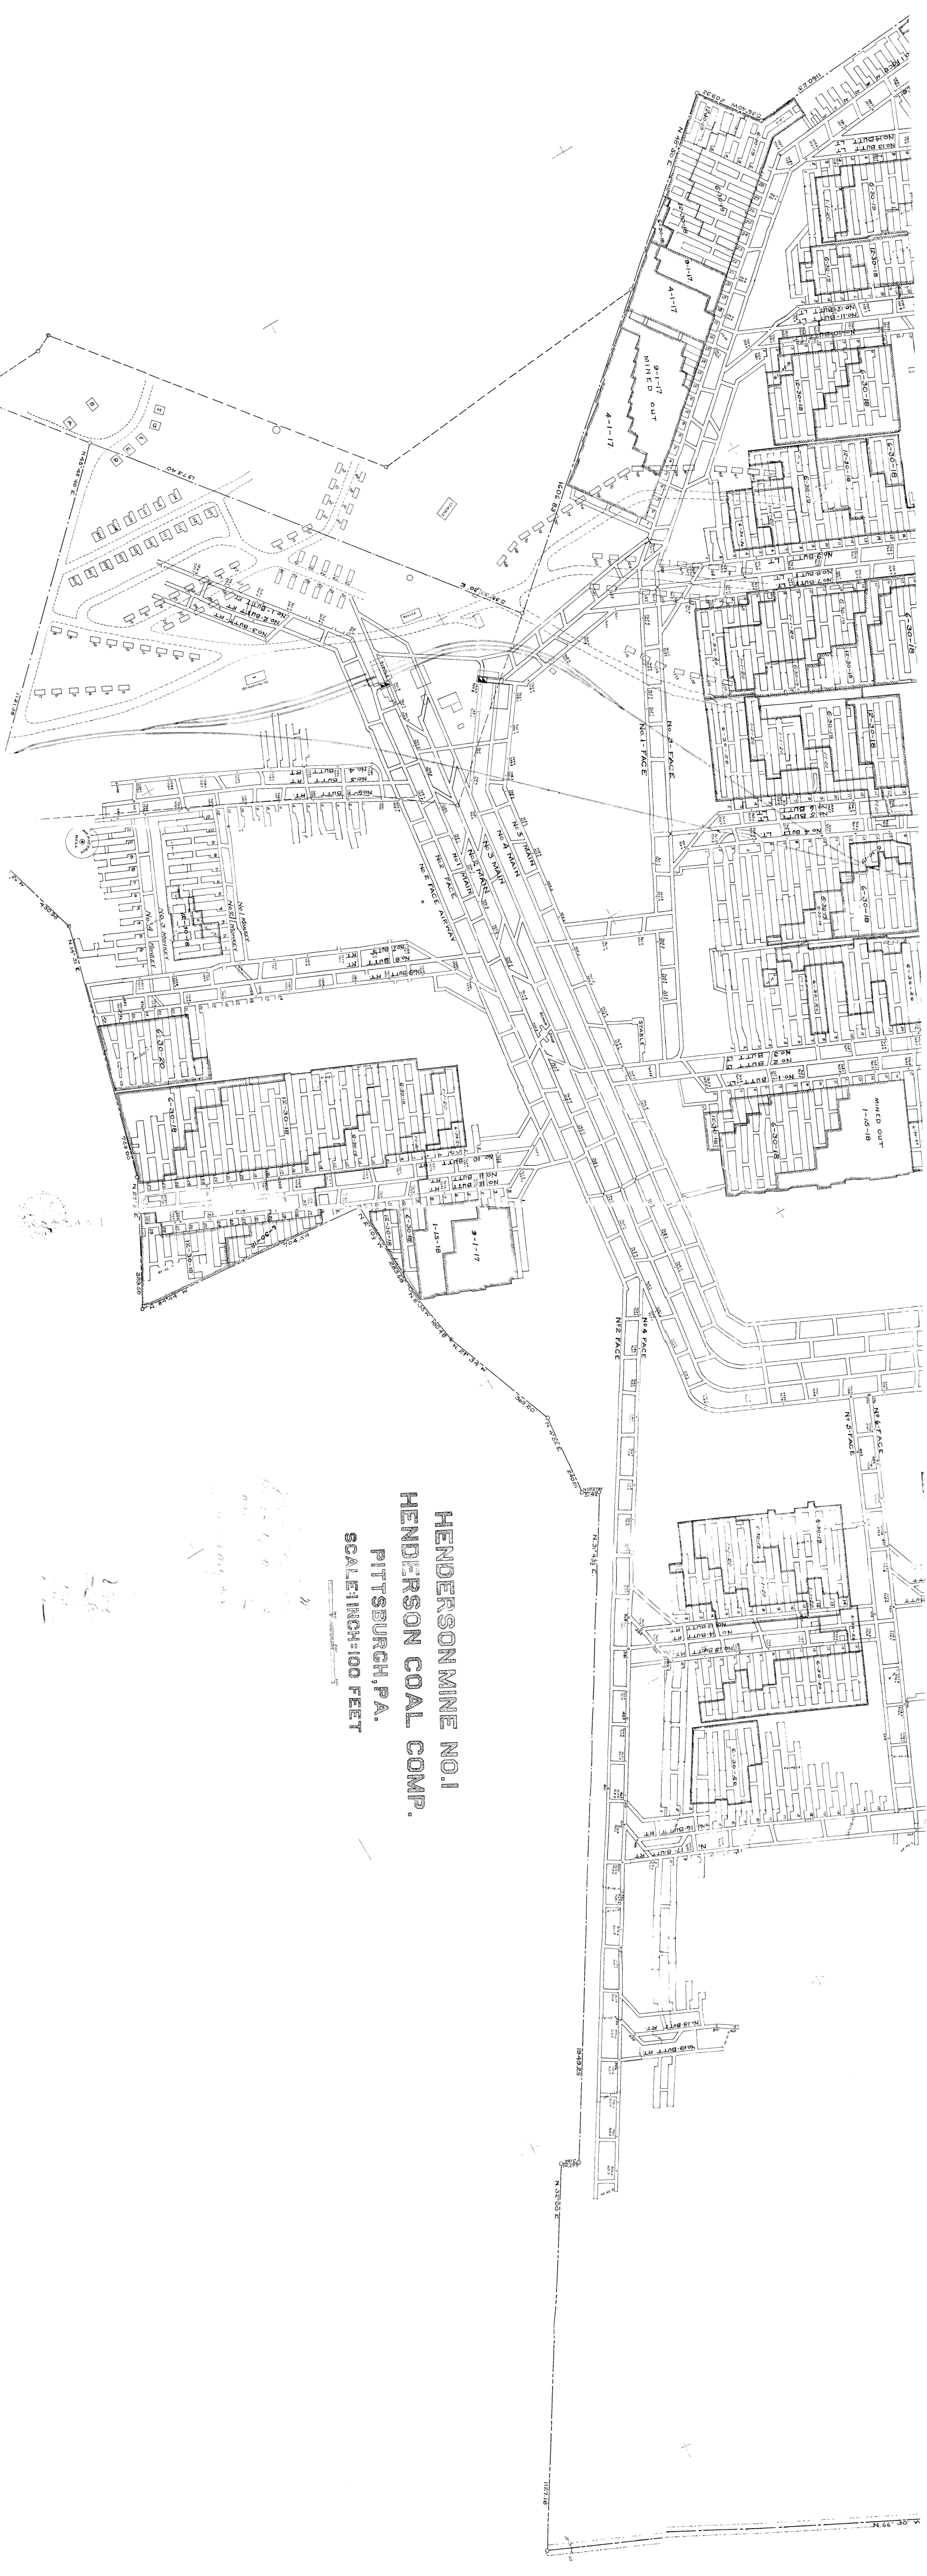

HENDERSON MINE NO. 1
HENDERSON COAL COMP.
PITTSBURGH, PA.

SCALE 1 INCH = 100 FEET