


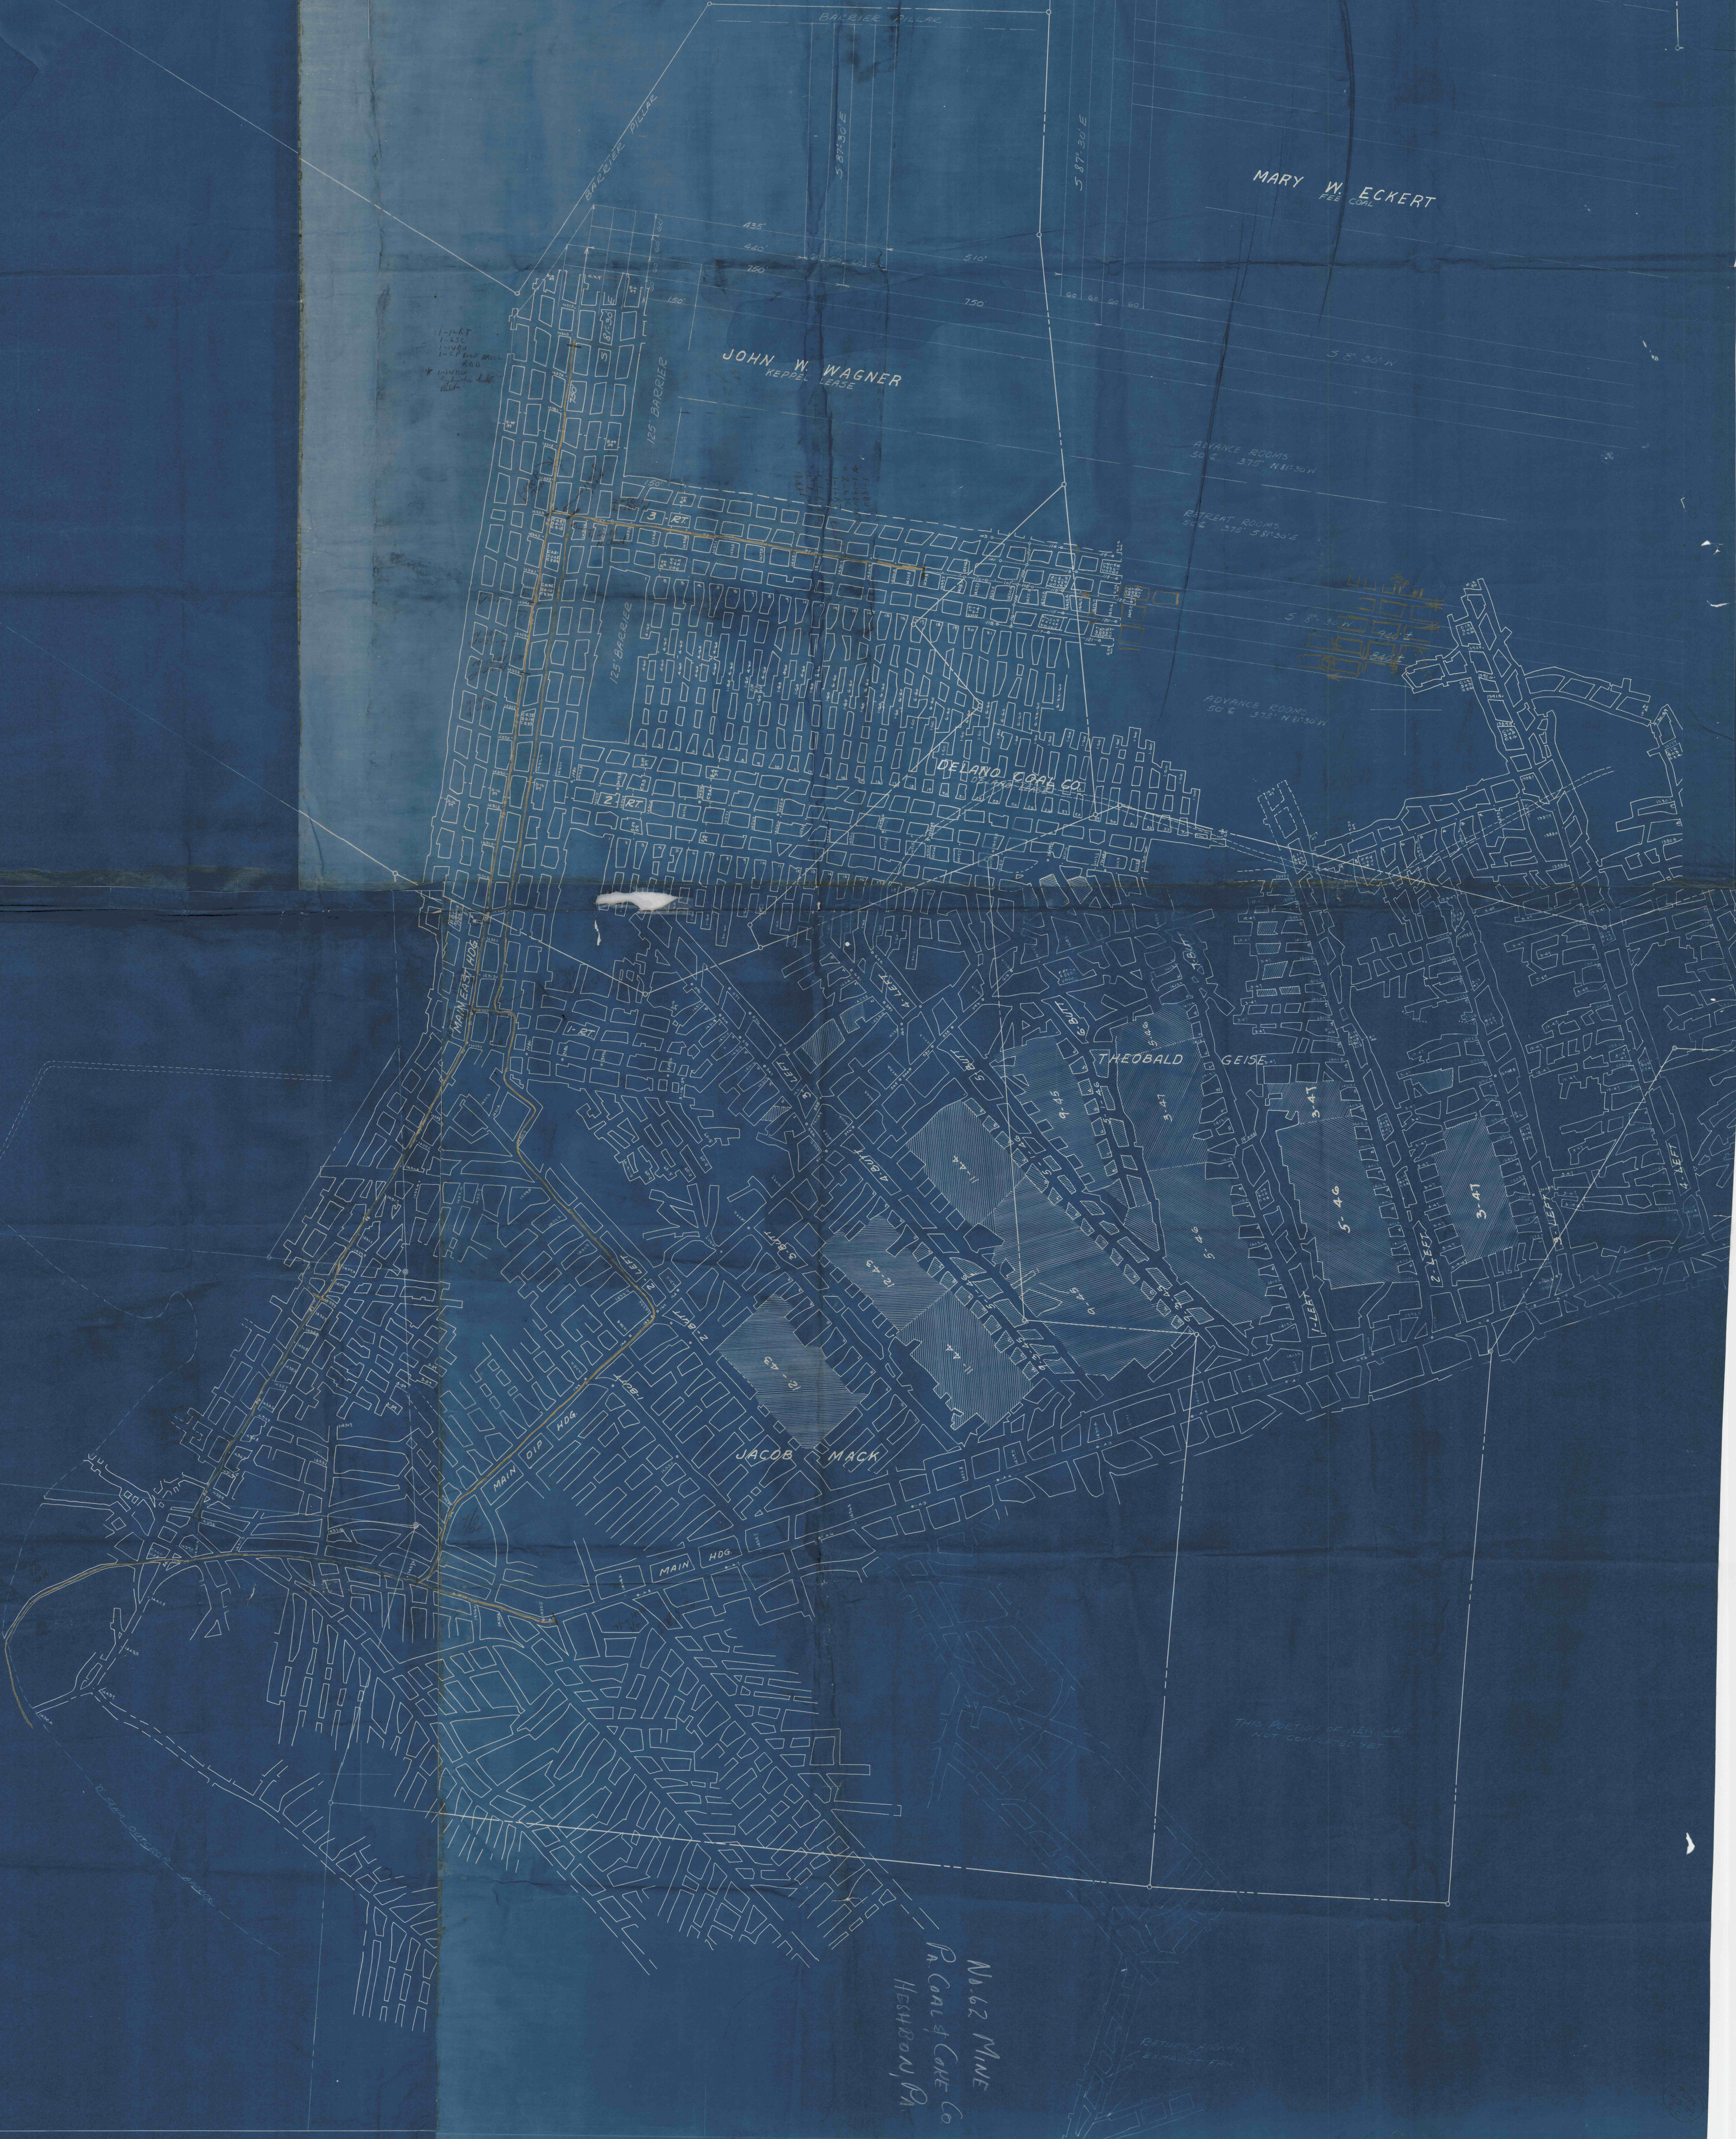

MARY W. ECKERT

JOHN W. WAGNER

DELANO CO. CO.

THEOBALD GEISE

JACOB MACK

NO. 62 MINE
PA. COAL & COKE CO.

THIS PORTION OF 1862 MAP
NOT CORRECTED YET