

PARK
ARMSTRONG
MAHER

KELLY STATION FEE


Worked out Area

Crop

Don't Own

L. W. Hicks Coal Company
Kelly Station
Bethel Twp. Armstrong County
Scale 1" = 2000'

#1281
8-3-99
CC

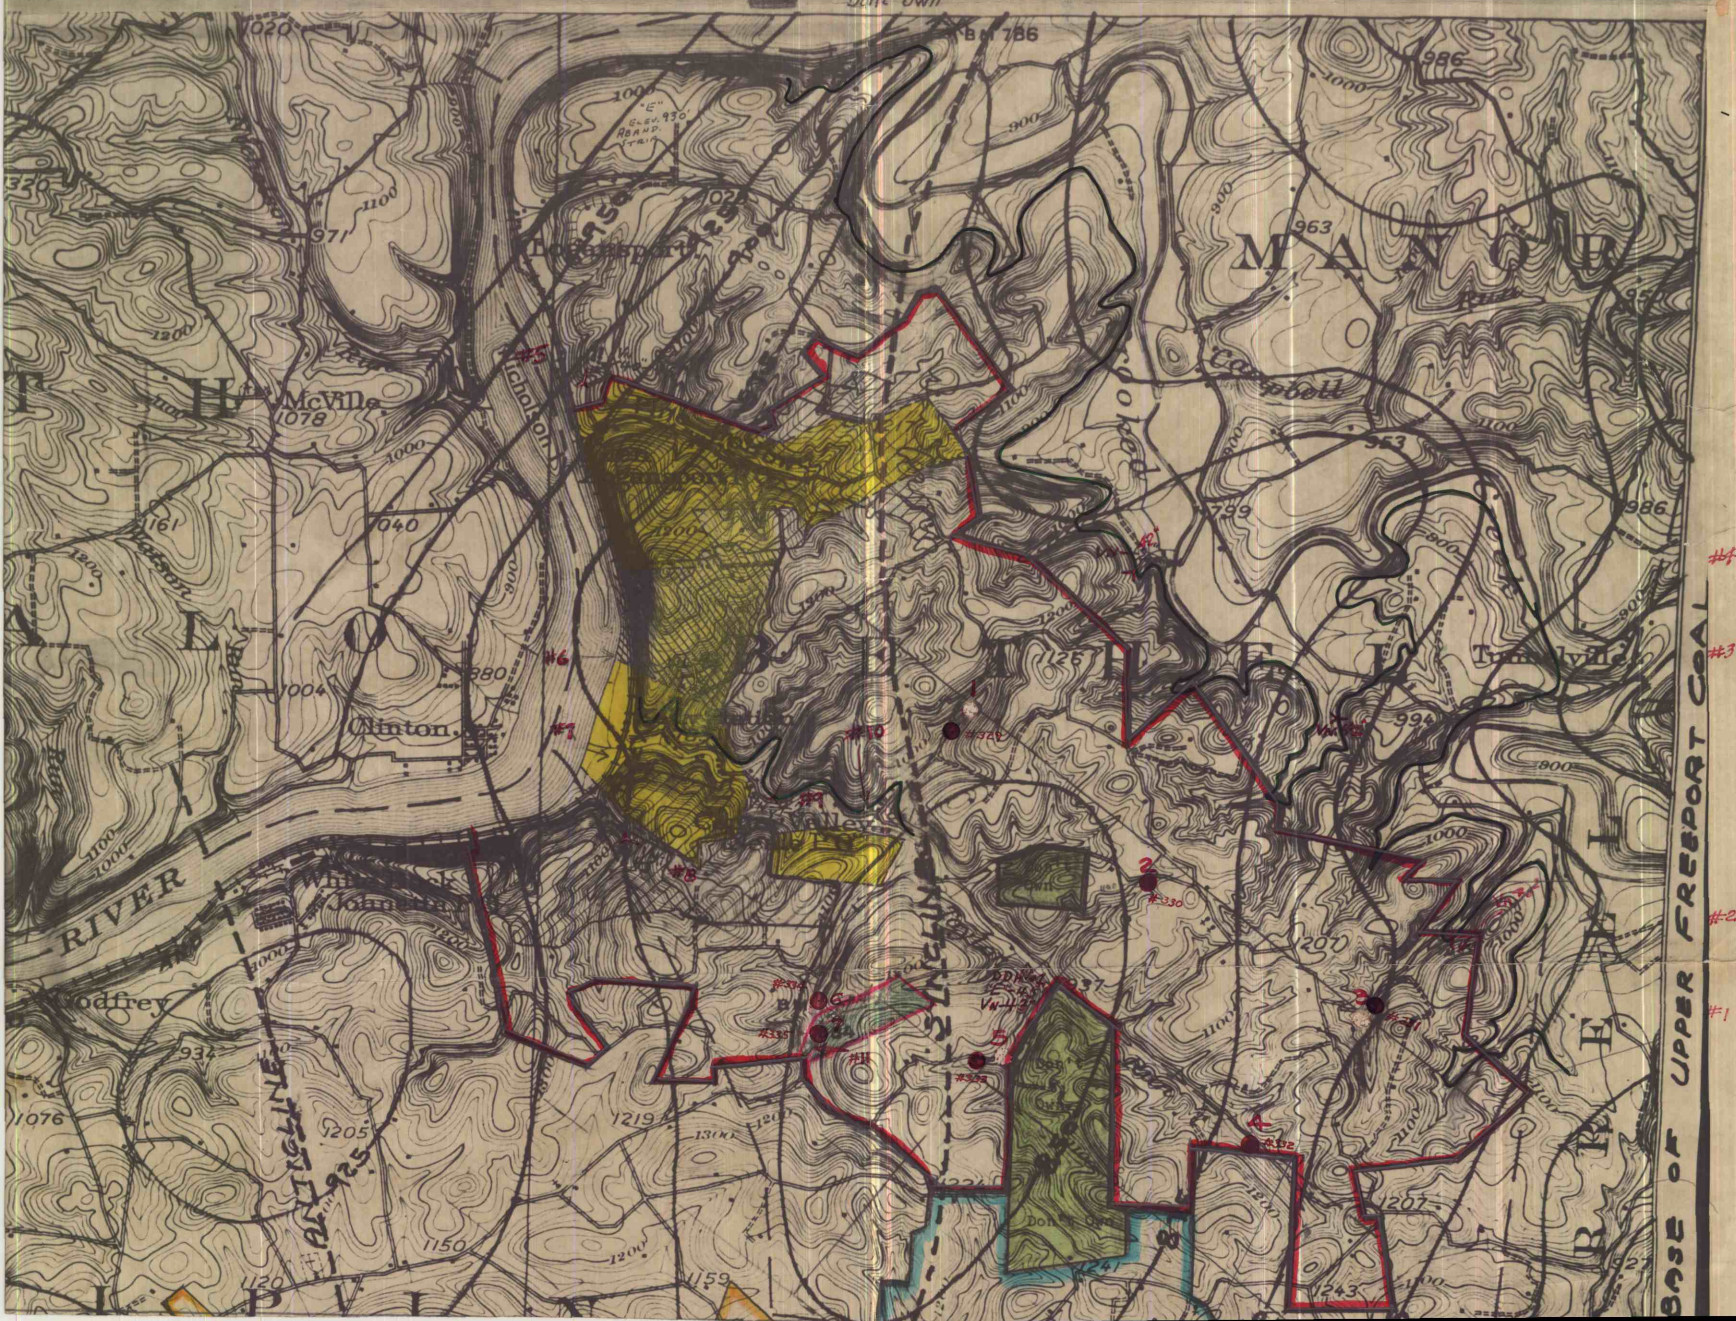

#1
#2
