


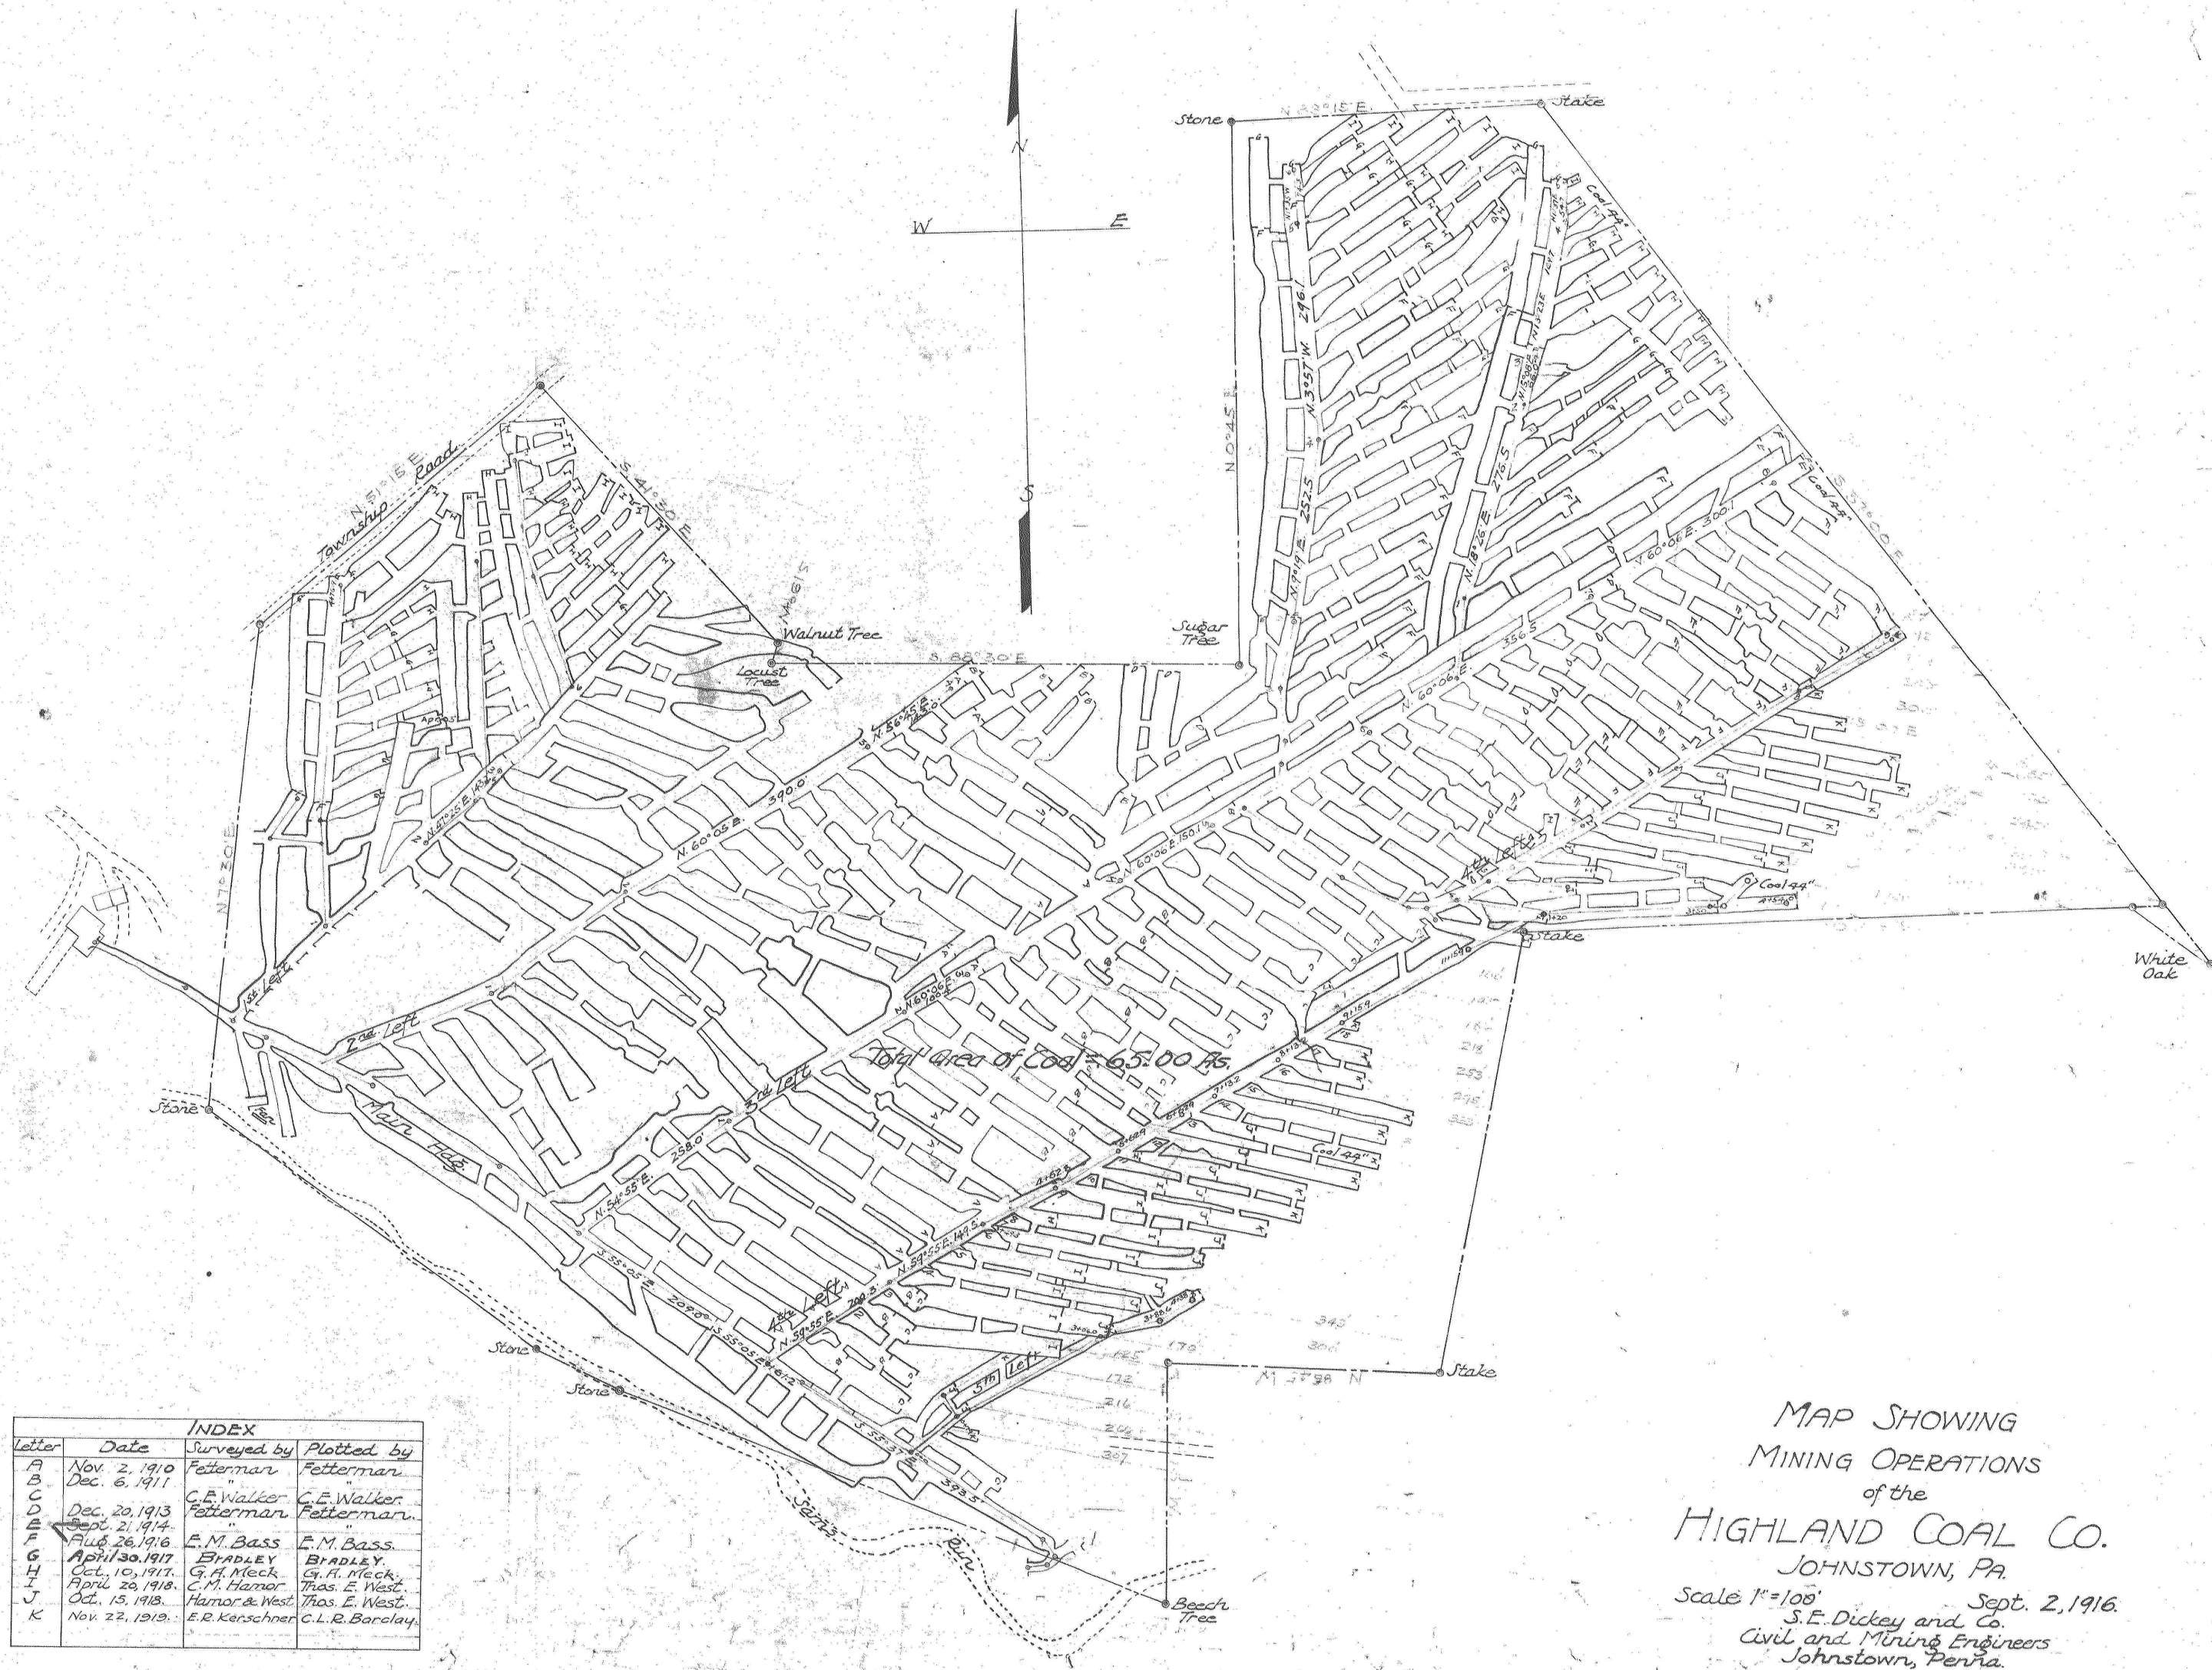

INDEX			
Letter	Date	Surveyed by	Plotted by

MAP SHOWING
MINING OPERATIONS
of the
HIGHLAND COAL CO.
JOHNSTOWN, PA.

Scale 1"=100' Sept. 2, 1916.
S. E. Dickey and Co.
Civil and Mining Engineers
Johnstown, Penna.

Property is Situate Lorain Boro & Stonycreek Twp. Cambria Co. Pa.