


E. VEIN LINES
UPPER FREEPORT
WESTMORELAND CO
FAIRFIELD TWP
SCALE - 1 IN = 200 FT

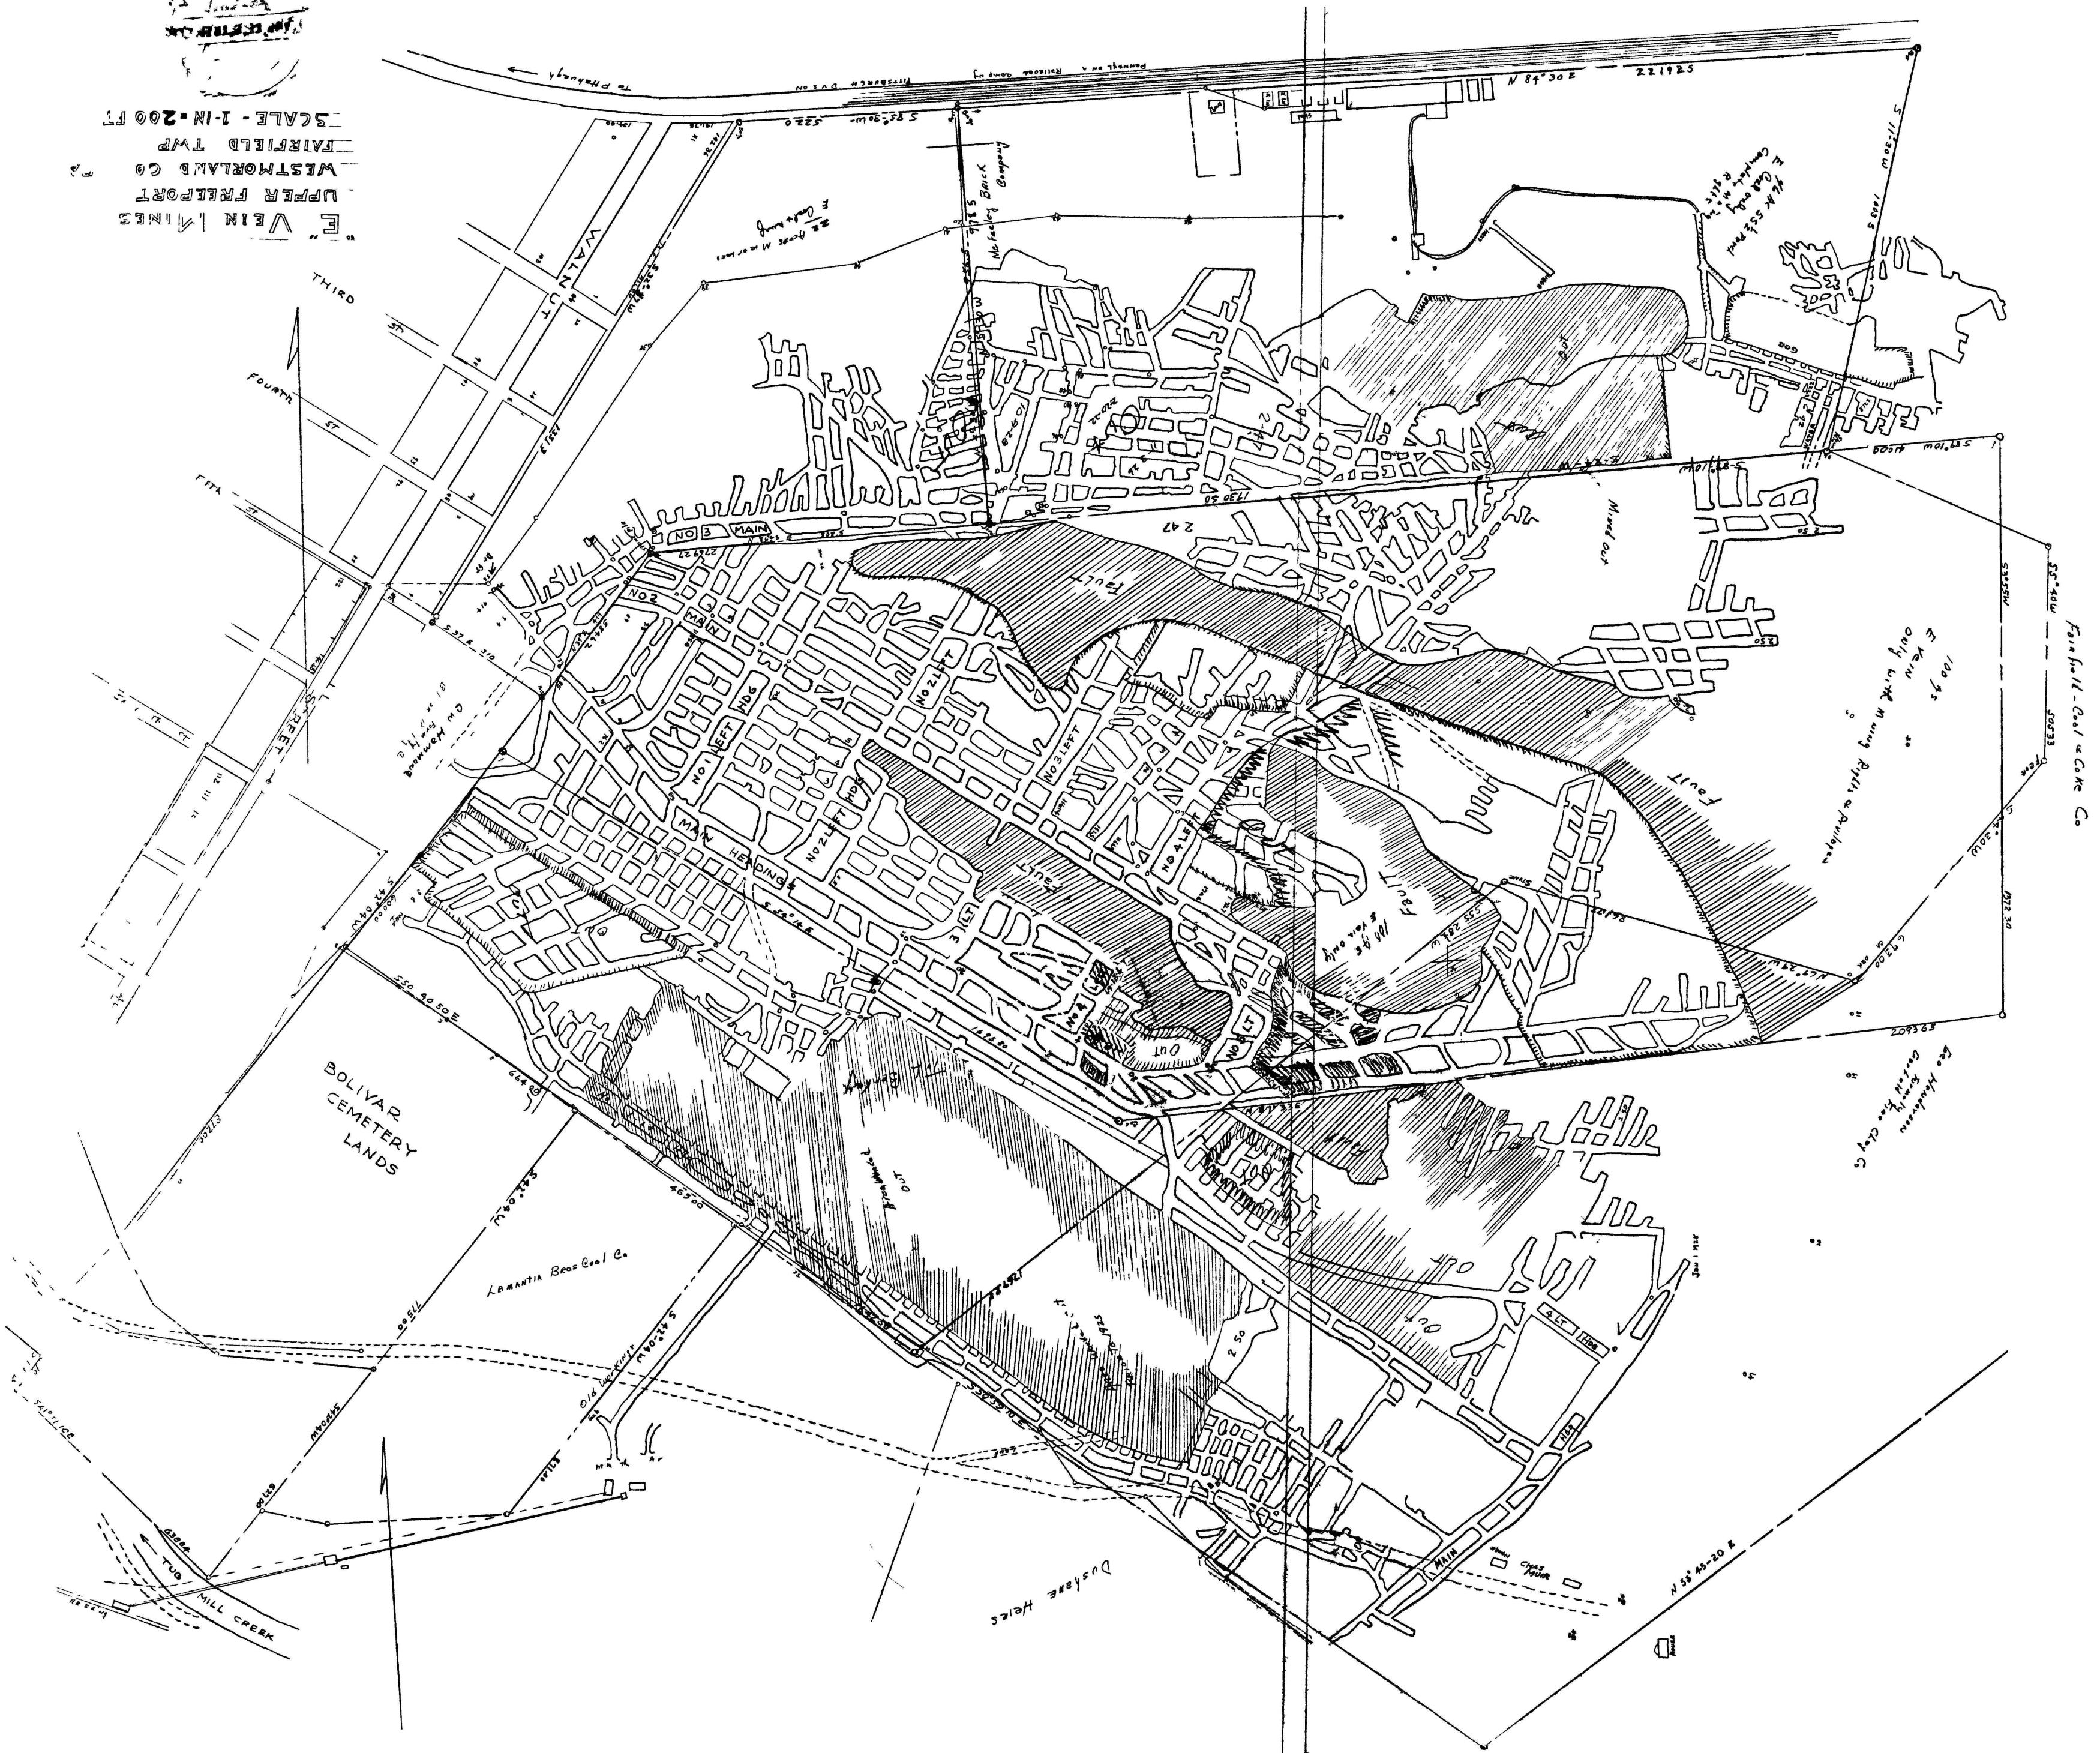

Fairfield - Coal & Coke Co

100 yds
E. Vein
only with Mining Rights & Privileges

Clay Co