


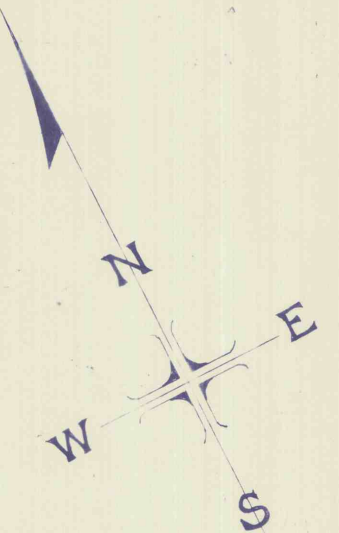

UNION COLLIERIES CO.
OAKMONT PA.
MINE NO. 8
SITUATE IN
INDIANA AND WEST DEER TOWNSHIP, ALLEGHENY CO., PA.

SCALE 1" = 100'

DATUM

ELEVATION BASE IS MEAN SEA LEVEL

LEGEND

- INTAKE VENTILATION
- RETURN VENTILATION
- OVERCAST
- STOPPING
- REGULATOR
- DOOR
- DOOR REGULATOR
- MAIN PUMPS
- GATHERING PUMPS

SURVEY

A	6-10-35
B	12-10-35
C	6-10-36
D	6-10-36
E	6-10-37
F	12-10-37
G	6-10-38
H	5-20-39
I	11-20-39
J	6-10-40
K	11-20-40
L	5-20-41
M	11-20-41
N	5-20-42
O	11-4-42
P	11-3-42